




Geological
Survey and/or
P. GILLES, P.E.
Lake County Engineer

By TAM Date 6/30/99
Swale as shown
Lower F.G. to 885.5

**ROOF DRAINS
SHALL DISCHARGE
TO SPLASH BLOCKS.**

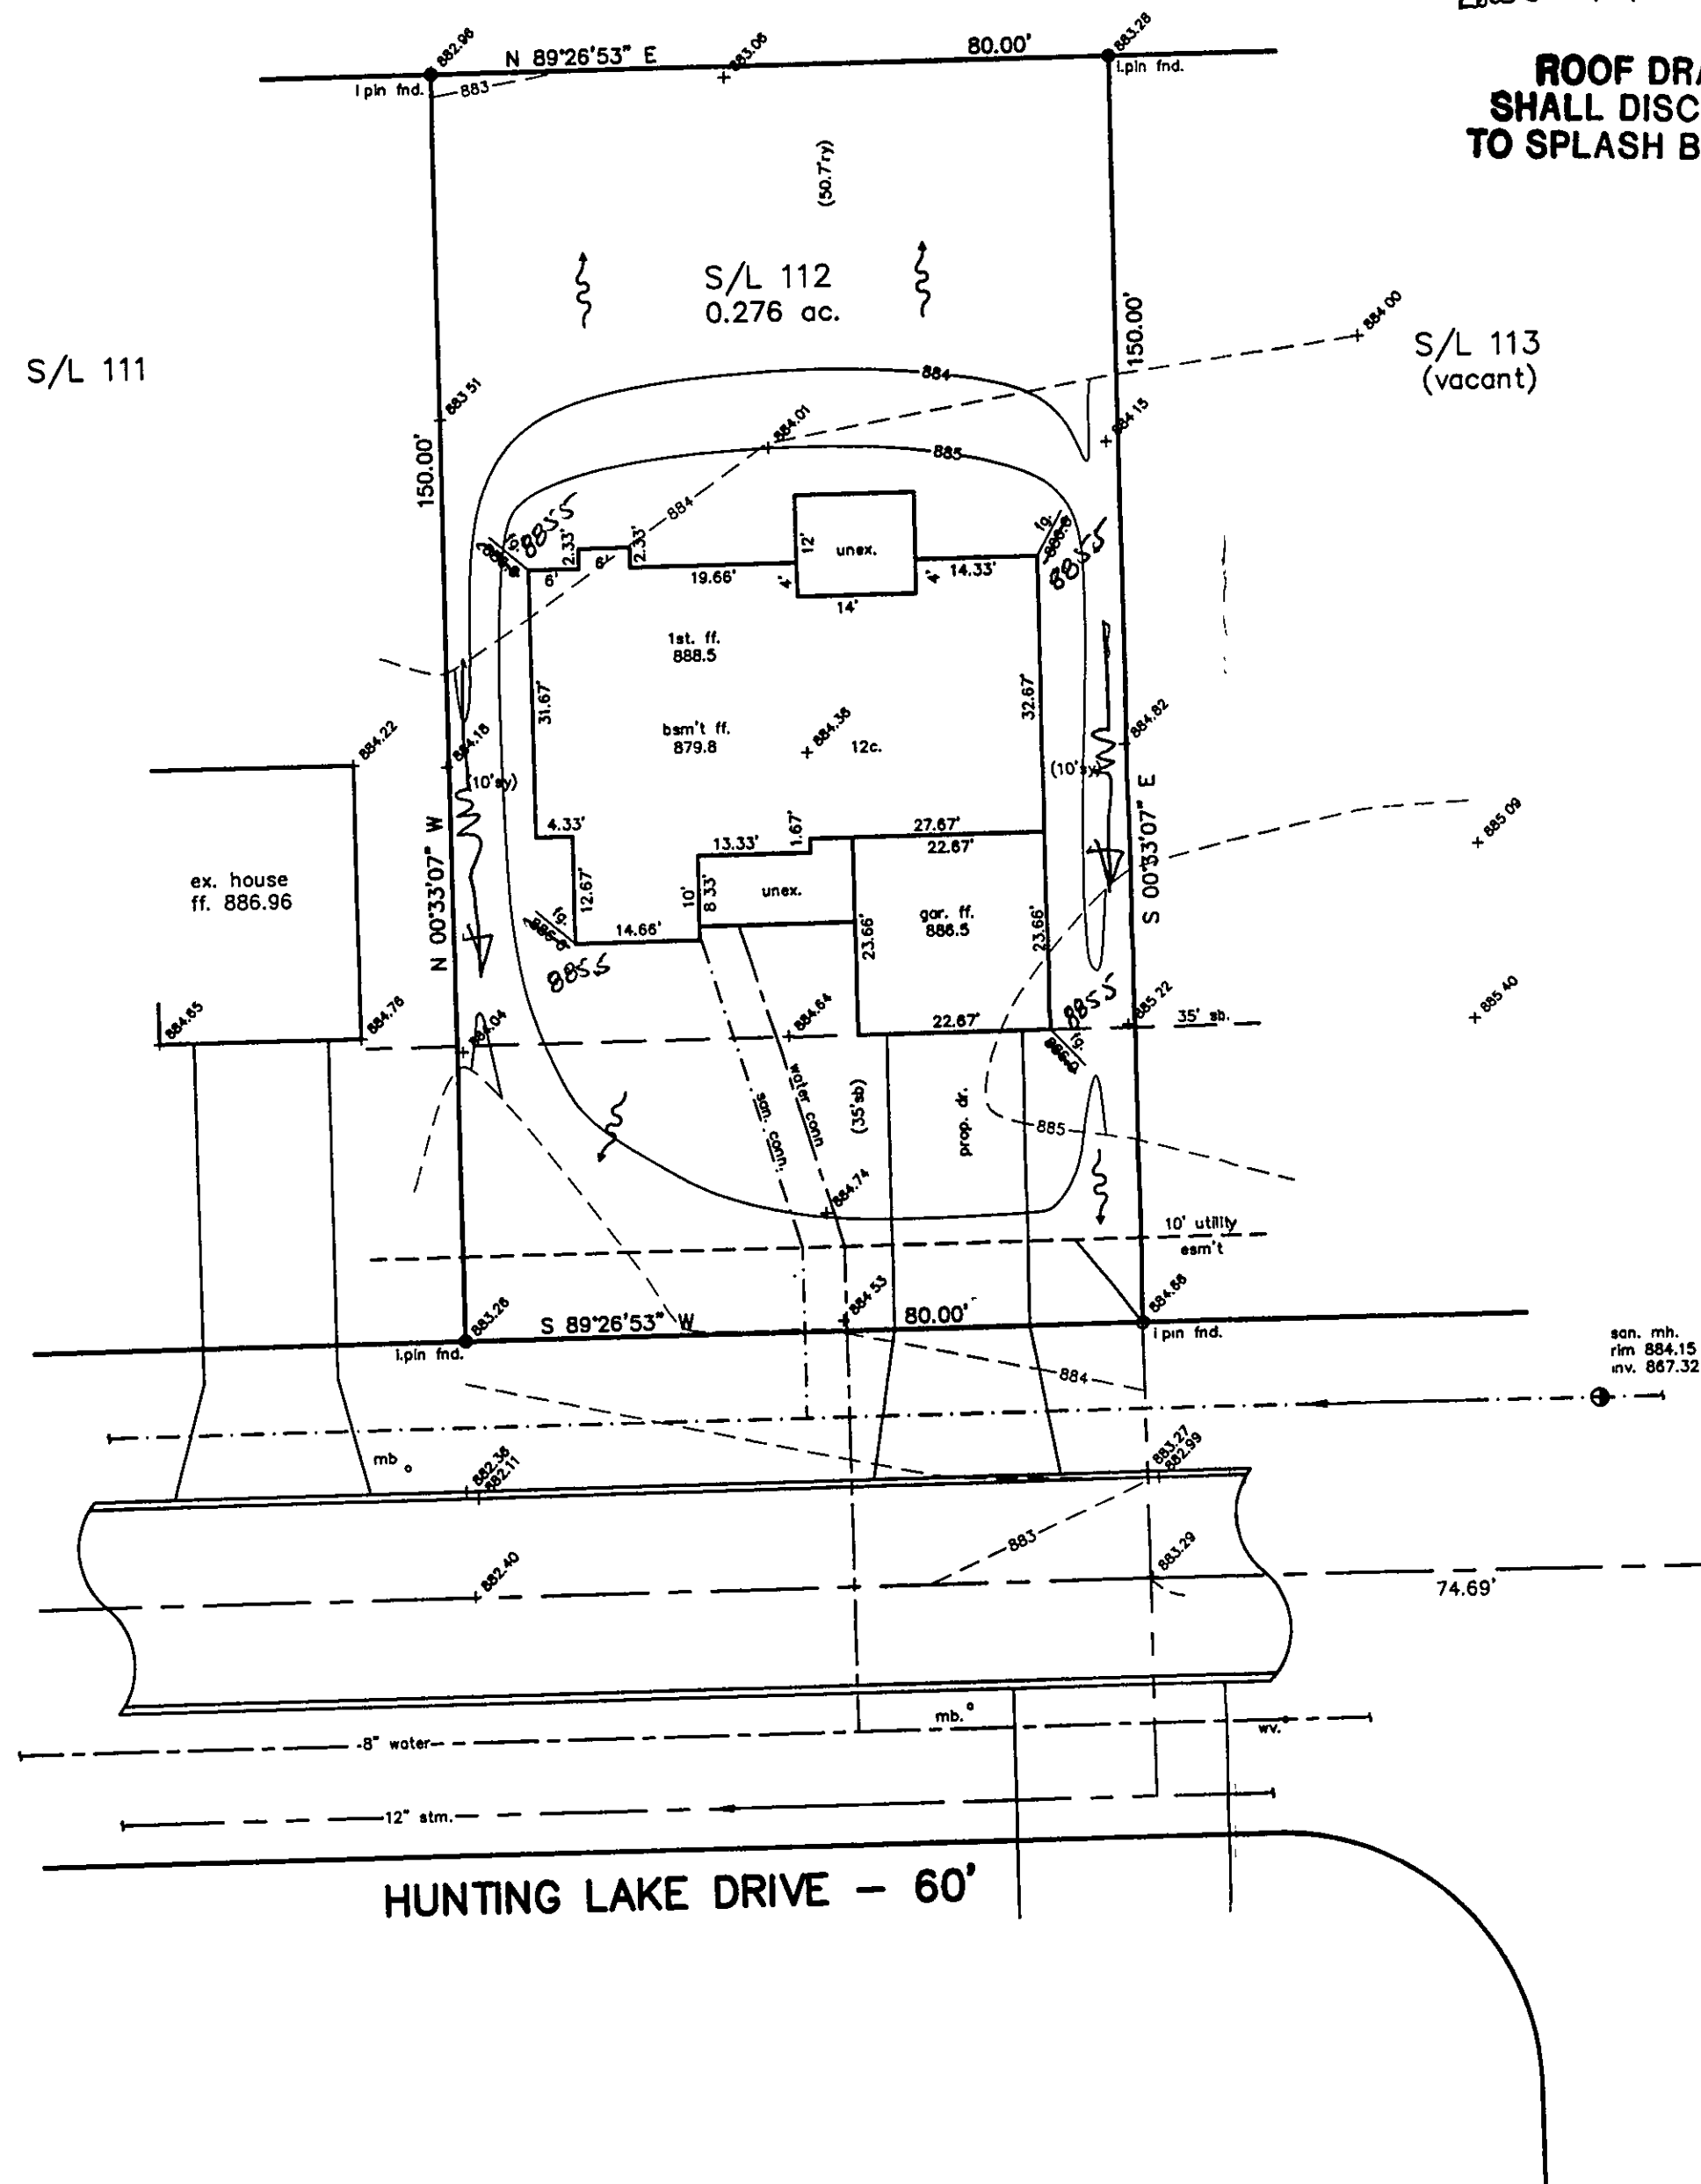

SITE PLAN

CONCORD TOWNSHIP, LAKE COUNTY, OHIO

for: PAVLISIN BUILDERS

CLIENT	OWNER
ADDRESS	STREET
CITY	ZIP
QUAIL HOLLOW SUB.	
SUBDIVISION	NAME
10-44	TRACT
VOL-PG	LOT
112	HUNTING LAKE DR.
SUBLOT NO.	STREET
VOL-PG	PERM. PARCEL NO.

LEGEND

SANITARY MANHOLE	---○---
STORM MANHOLE	---●---
INLET OR CATCH BASIN	---□---
HYDRANT	---◇---
EXISTING CONTOURS	---○---
PROPOSED CONTOURS	---○---
EXIST. ELEV. - 100.0	100.0 ± 2 PROP. ELEV.
AS BUILT ELEVATION	100.0
INDICATES	DIRECTION OF SURFACE DRAINAGE

REMARKS

ALL BOUNDARY DATA SHOWN WAS OBTAINED FROM (DEEDS, RECORDED SUBDIVISION PLAT OR OTHER PUBLIC RECORDS)
LOCATIONS AS SHOWN OF ADJACENT WELLS AND SEPTIC TANKS OBTAINED FROM LAKE COUNTY HEALTH DEPARTMENT

DESIGN CERTIFICATION

THIS PLAT WAS PREPARED BY ME, AND IS CORRECT TO THE BEST OF MY KNOWLEDGE AND BELIEF.

NAME TAM SURVEYOR REGISTRATION NO. 86343

CHECK LIST

NO. OF BEDROOMS	WATER MAIN SIZE, LOCATION
DIMENSIONS	SAN. SEWER SIZE & OR. LOC.
BEARINGS	SAN. MH. CAST. ELEV. INV. ELEV.
TIE TO NEAREST STREET	SAN. CONN. SIZE, LOC. DEPTH
SUBLOT NO. PARCEL NO.	STORM SEWER SIZE & OR. LOC.
SURROUNDING OWNERS	STORM MH. CAST. ELEV. INV. ELEV.
BLDG. DIMENSIONS FIN GR.	PAVT TYPE GRADE CURBS
BLDG. TIES FLTR. GRADES	GAS LINE LOC. SIZE PRESSURE
APRON TYPE WIDTH THICKNESS	SEPTIC TANK LOCATION & DUPLICATION AREA
SEWAGE TYPE WIDTH THICKNESS	WELL LOCATION
CULVERT TYPE DIA., LENGTH	ISOLATION RADIUS FROM WELL
ROCK OUTCROPPINGS	

REVISIONS			PLAN PREPARED BY:	
NO.	DATE	BY	BABCOCK JONES & ASSOCIATES, INC.	
1			PAINESVILLE, OHIO	
2				
3			DRAWN BY T.R.	SCALE 1"=20'
4			CHK'D. H.J.	DATE 3/25/99
5			CREW CHIEF W.B.	APP'D H.J.

"AS BUILT" CERTIFICATION
I, HEREBY CERTIFY THAT THE CIRCLED GRADES ARE EXISTING FINISH GRADES CHECKED IN THE FIELD ON 6/29/99, 1999 AND ARE CORRECT TO THE BEST OF MY KNOWLEDGE AND BELIEF.

REGISTERED SURVEYOR REG. NO.

TBM-SANITARY MH.
RIM=884.15

ZONING PERMIT #0699-9445
ISSUED 6/29/99

SUBJECT TO APPROVAL BY:
Lake County Sanitary Eng. ☐
Lake County Eng. Dept. ☒
Lake County Planning Comm. ☐
Lake County Bldg. Dept. ☒

