

ZONING PERMIT #0797-8804

ISSUED 7/14/97 Contingent upon 55' Corner Sideyard setback

SUBJECT TO APPROVAL BY:

Lake County Sanitary Eng. ☐

Lake County Eng. Dept. ☒

Lake County Planning Comm. ☐

Lake County Bldg. Dept. ☒


SITE PLAN

LOU LAVORATO

KNOWN AS BEING SUBLOT No. 136 IN
QUAIL HOLLOW No. 3 AS RECORDED IN
VOLUME 21 PAGE 33 OF THE LAKE
COUNTY MAP RECORDS, NOW IN THE:
TOWNSHIP OF CONCORD
COUNTY OF LAKE - STATE OF OHIO

EXISTING GRADE
PROPOSED GRADE

EXISTING CONTOUR
PROPOSED SWALE

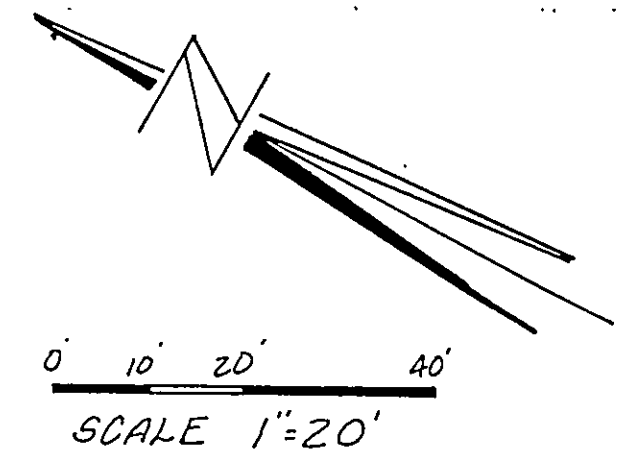

ROOF DRAINS
SHALL DISCHARGE
TO SPLASH BLOCKS.

SEWER & WATER CONNECTIONS TO BE
VERIFIED AT TIME OF CONSTRUCTION.


Grading Plan Approved
as shown and/or noted
THOMAS P. GILLES, P.E.
Lake County Engineer

By Thomas Date 7-15-97

I raised F.G. because
of future road.

BEARINGS SHOWN HEREON ARE TO AN
ASSUMED MERIDIAN AND ARE USED TO
INDICATE ANGLES ONLY. DISTANCES ARE
GIVEN IN FEET AND DECIMAL PARTS
THEREOF, ALL OF WHICH ARE CORRECT,
TO THE BEST OF MY KNOWLEDGE AND BELIEF.

James A. Ziemba
JAMES A. ZIEMBA
P.S. #7094

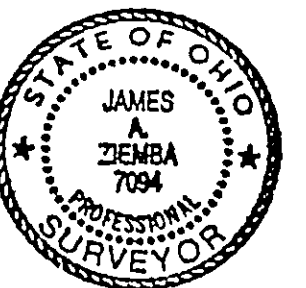

BENCHMARK SURVEY CO.

5964 S. EDGE RD. 428-8599
MADISON, OHIO 44057 6-17-97

HUNTING LAKE DRIVE 60'

BENCH MARK
TOP OF HYDRANT
ELEV. = 911.15'