

LEGEND

- IRON PIN FOUND
- R/R SPIKE FOUND
- ✕ PK NAIL FOUND
- ⊞ STONE FOUND
- FENCE POST FOUND & USED
- IRON PIN SET
- R/R SPIKE SET
- ✕ PK NAIL SET
- △ BREAK POINT
- +— FENCE LINE
- UV WATER VALVE
- PH FIRE HYDRANT
- SM SANITARY MANHOLE
- ST STORM INLET
- EXISTING INDEX CONTOURS (B)
- EXISTING INTERIM CONTOURS (I)
- PROPOSED CONTOURS
- 100 EXISTING ELEV.
- 101.5 PROPOSED ELEV.
- 101.3 PROPOSED CONTOURS




SITE IMPROVEMENT PLAN

WILLIAMSBURG HOMES
 Mr. & Mrs. James Talliano, S/L NO 139 HUNT CLUB
 VOLUME 21 PAGE 33-3
 NO ADDRESS GIVEN
 QUAIL HOLLOW NO. 3
 ORIGINAL TOWNSHIP LOT NOS. 3 & 4 IN TRACT 2
 TOWNSHIP OF CONCORD
 COUNTY OF LAKE
 STATE OF OHIO
 4 BEDROOM HOUSE
 SURVEYOR'S STATEMENT


I, THE UNDERSIGNED HEREBY CERTIFY THAT THE TOPOGRAPHY SHOWN HEREON, INDICATED BY FOOT CONTOURS AND ELEVATIONS REPRESENTS AN ACTUAL FIELD TOPOGRAPHIC SURVEY MADE BY ME ON THE 28th DAY OF NOVEMBER 1994 AND THAT THE ELEVATIONS WERE TAKEN AT APPROPRIATE INTERVALS AND THAT AS OF THAT DATE THEY EXISTED AS INDICATED HEREON.

DIMENSIONS ON THIS PLAT ARE EXPRESSED IN FEET AND DECIMAL PARTS THEREOF UNLESS OTHERWISE NOTED. BEARINGS ARE REFERRED TO AN ASSUMED MERIDIAN AND ARE USED TO DENOTE ANGLES ONLY. MONUMENTS WERE FOUND OR SET AT POINTS INDICATED HEREON.

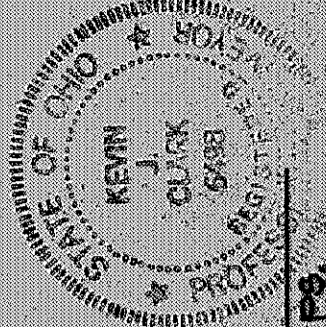

Kevin J. Clark
 KEVIN J. CLARK, P.E. P.S.
 REGISTERED SURVEYOR #439

REVISED: 12-19-94
 DRAWN BY: JJO
 DATE OF SURVEY: 11-28-94
 PROJECT NUMBER: 1094

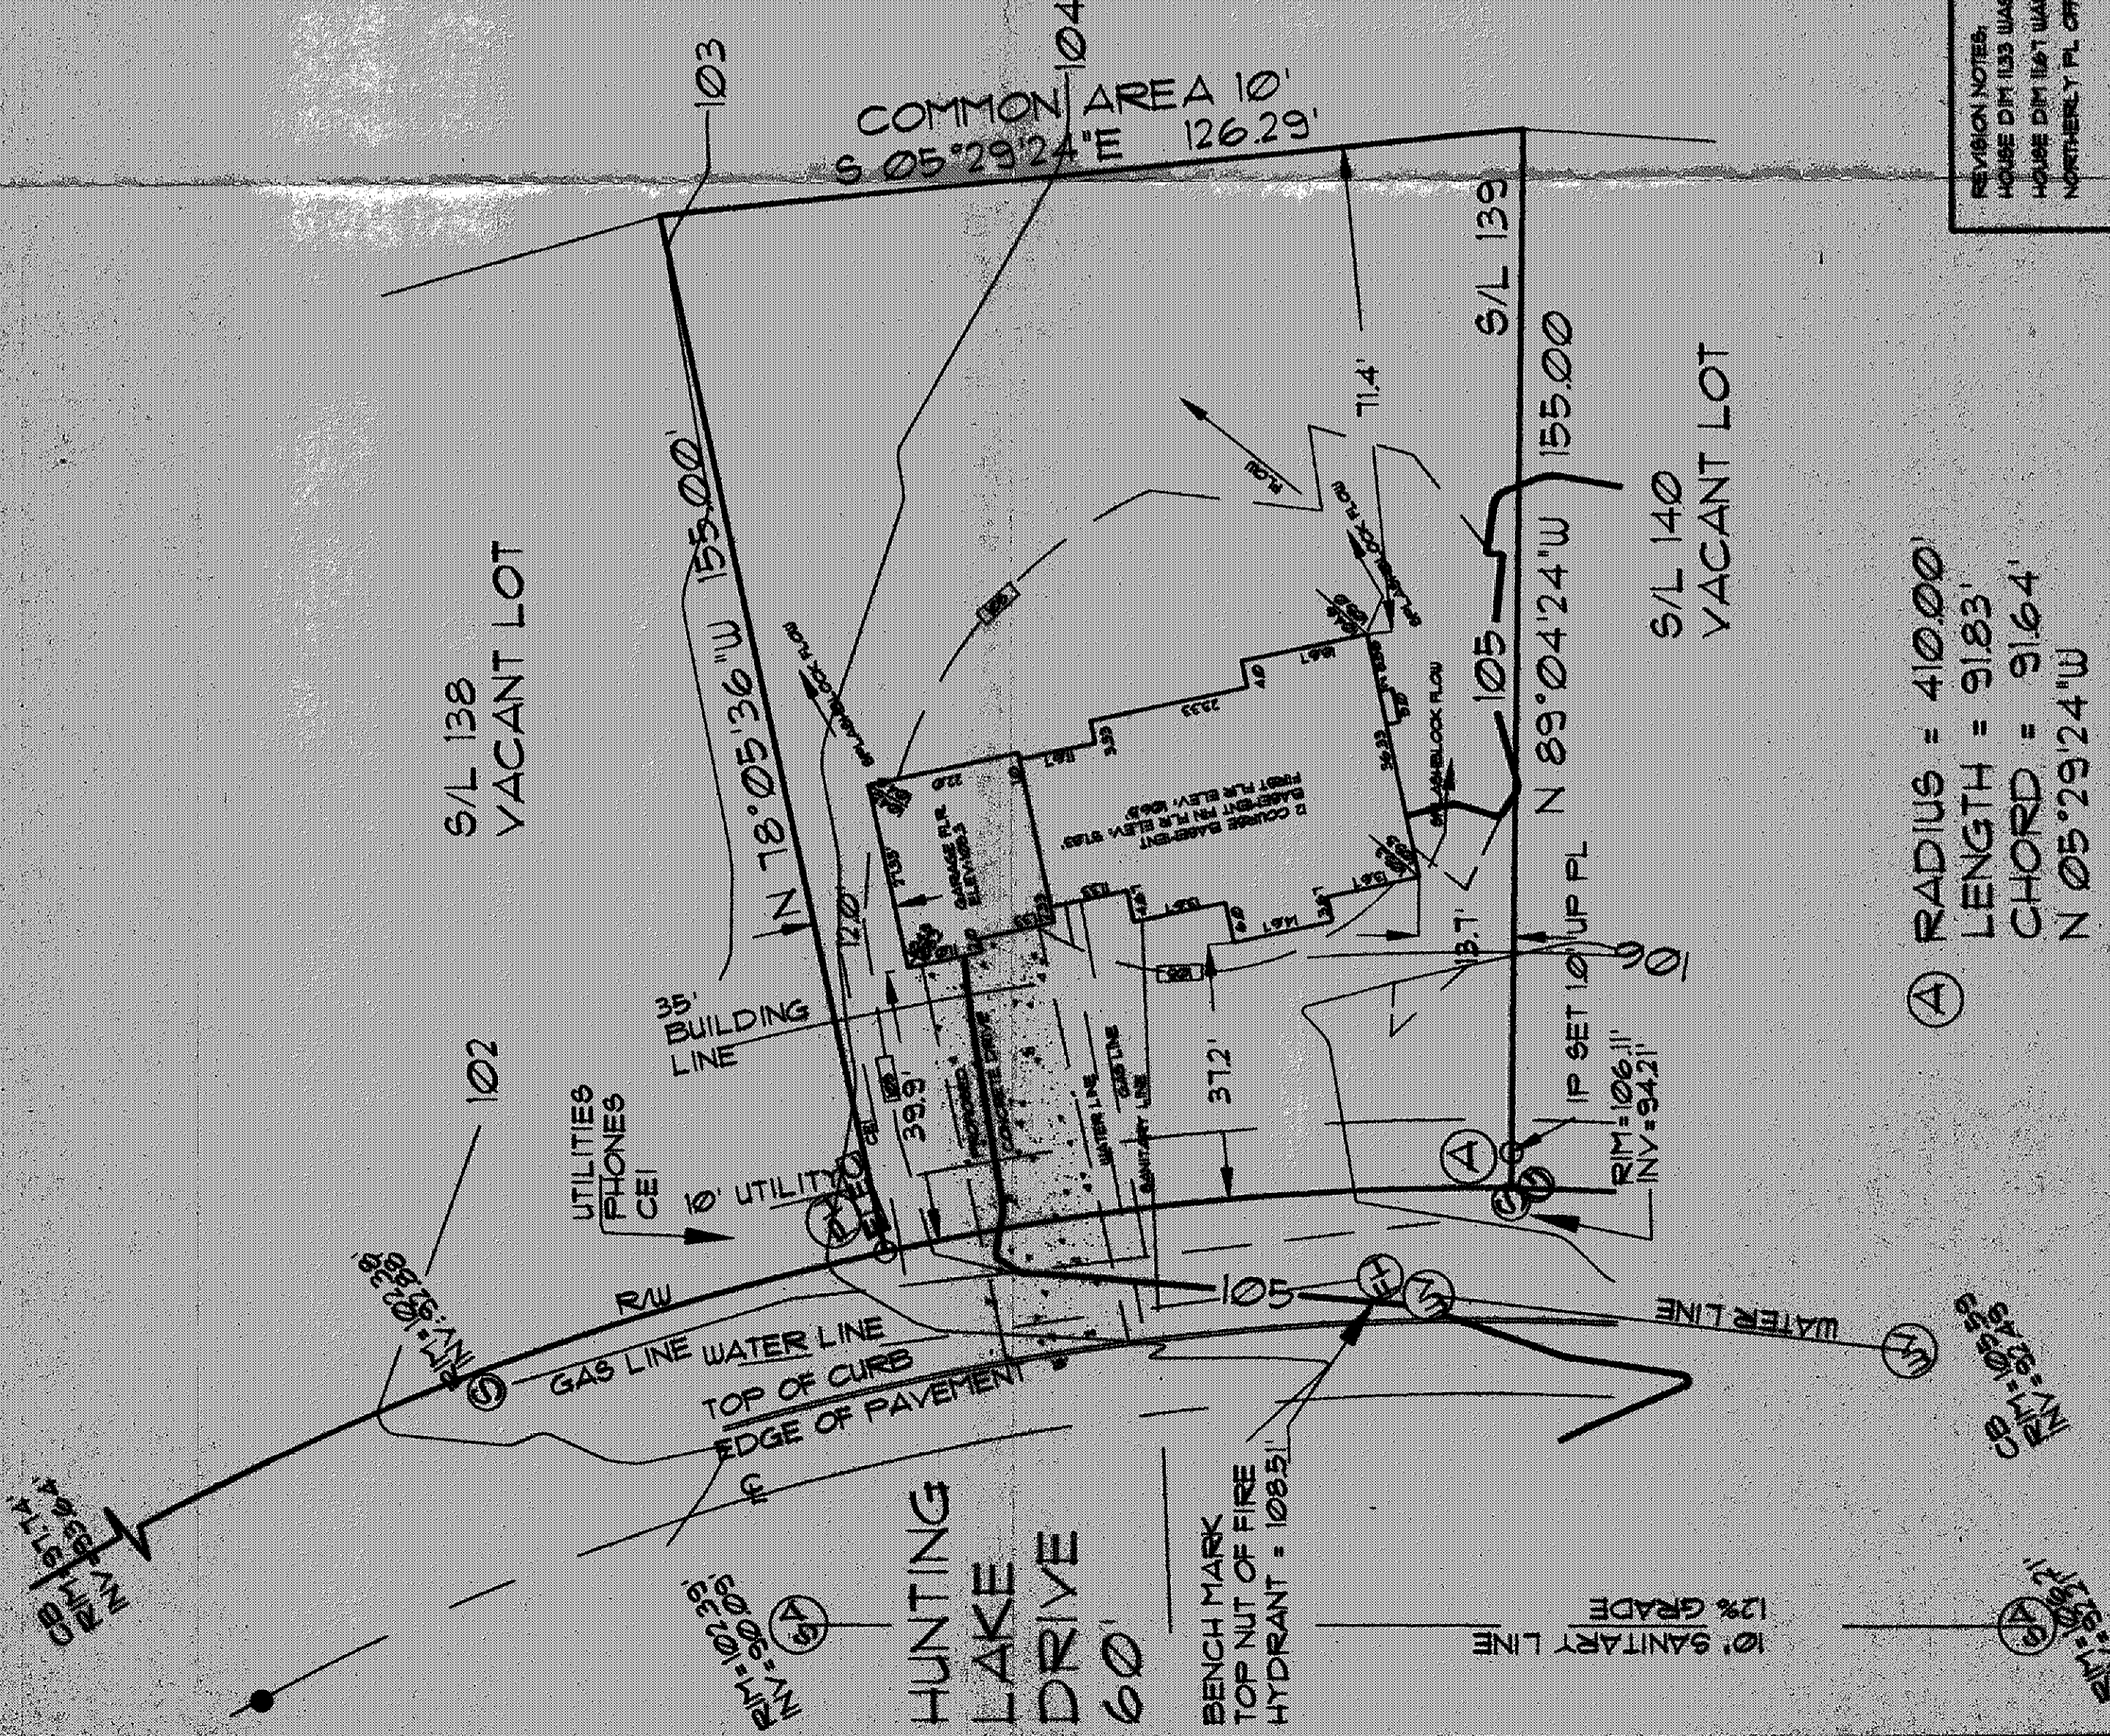

REVISION NOTES:
 HOUSE DIM 13.5 WAS 13.93
 HOUSE DIM 16.7 WAS 13.67
 NORTHERLY PL OFFSET 12.25 WAS 10.07

Ⓐ RADIUS = 410.00'
 LENGTH = 91.83'
 CHORD = 91.64'
 N 05° 29' 24" W