

SUBLOT NO. 163 IN QUAL HOLLOW NO. 3 BEING PART OF ORIGINAL CONCORD TOWNSHIP LOT NOS. 3 & 4 IN TRACT NO. 2, NOW IN THE TOWNSHIP OF CONCORD, COUNTY OF LAKE, OHIO.

INDICATES EXISTING ELEVATION
INDICATES PROPOSED ELEVATION

— INDICATES EXISTING CONTOUR LINE

INDICATES PROPOSED CONTROL LINE

INDICATES DIRECTION OF FLOW OF SURFACE WATER AFTER PUGH GRADING

T.M. TOP OF HYDRAULIC OPPOSITE SUBLOT NO. 162.
HUNTING LAKE DRIVE. ELEVATION 891.26.

CONTRACTOR TO VERIFY SANITARY CONNECTION
BETW. DEPT. MAGNET DECONTAMIN.

**NOTE: ROOF DRAINS TO BE
FLASH BLOCED.**

#2694-7833

SUBJECT TO APPROVAL BY:

Lake County Sanitary Eng. ☐


Lake County Eng. Dept. ☒

Lake County Planning Comm.

Lake County Bridge Dept.

MORTU

SCALE: 1" = 30'
MAY, 1994

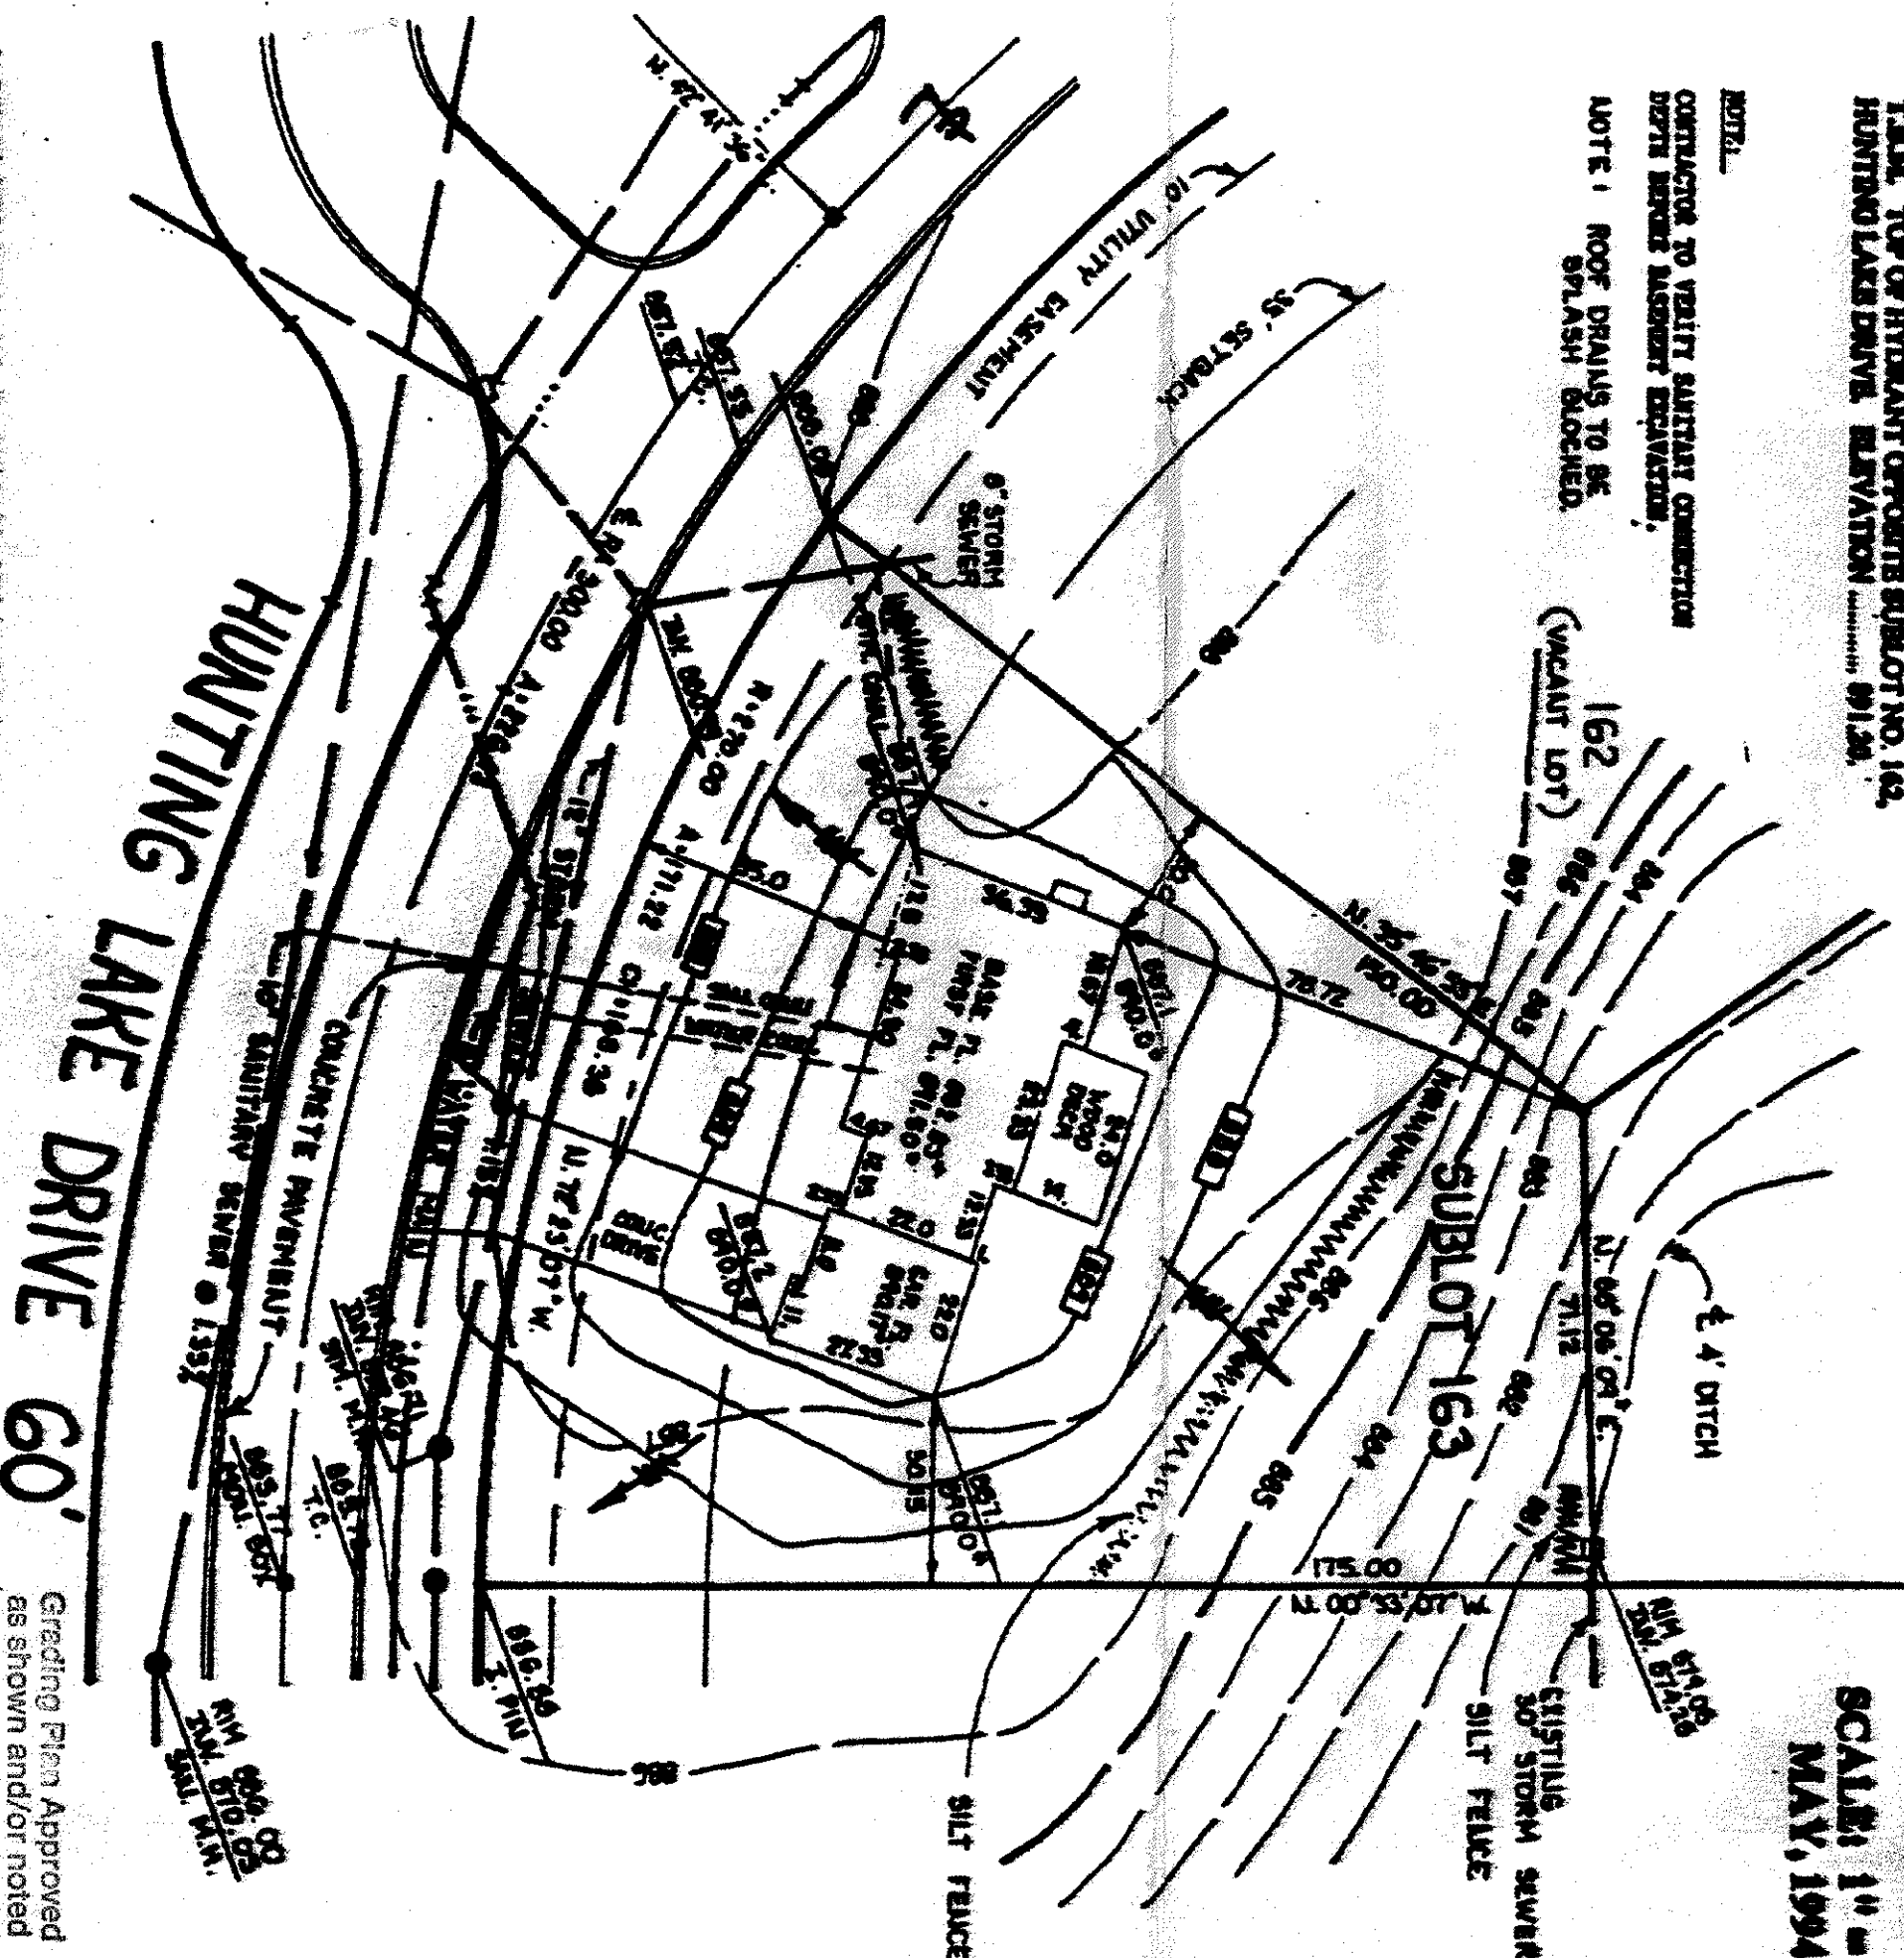

DISORDERLY BEHAVIOR BEING THE DOMINANT IN FACT AND BEING
THEIR TENDENCY. THEREFORE THE NEED OF THE "DISORDERED
MINDS" BEING THE MAIN IN ORDER TO BE THE MAIN
IN THE "MINDS" OF DISORDERED AND BEHAVIOR BEING THE
BEHAVIOR BEING THE MAIN IN ORDER TO BE THE MAIN
IN THE "MINDS" OF DISORDERED AND BEHAVIOR BEING THE
BEHAVIOR BEING THE MAIN IN ORDER TO BE THE MAIN



Grading Plan Approved
as shown and/or noted
THOMAS P. GILLES, P.E.
Lake County Engineer
6/14

HOWARD R. SEELE & ASSOCIATES,
Professional Land Surveyors
3701 Broadway, Third Floor 261
CLEVELAND, OHIO 44129

94681-163