


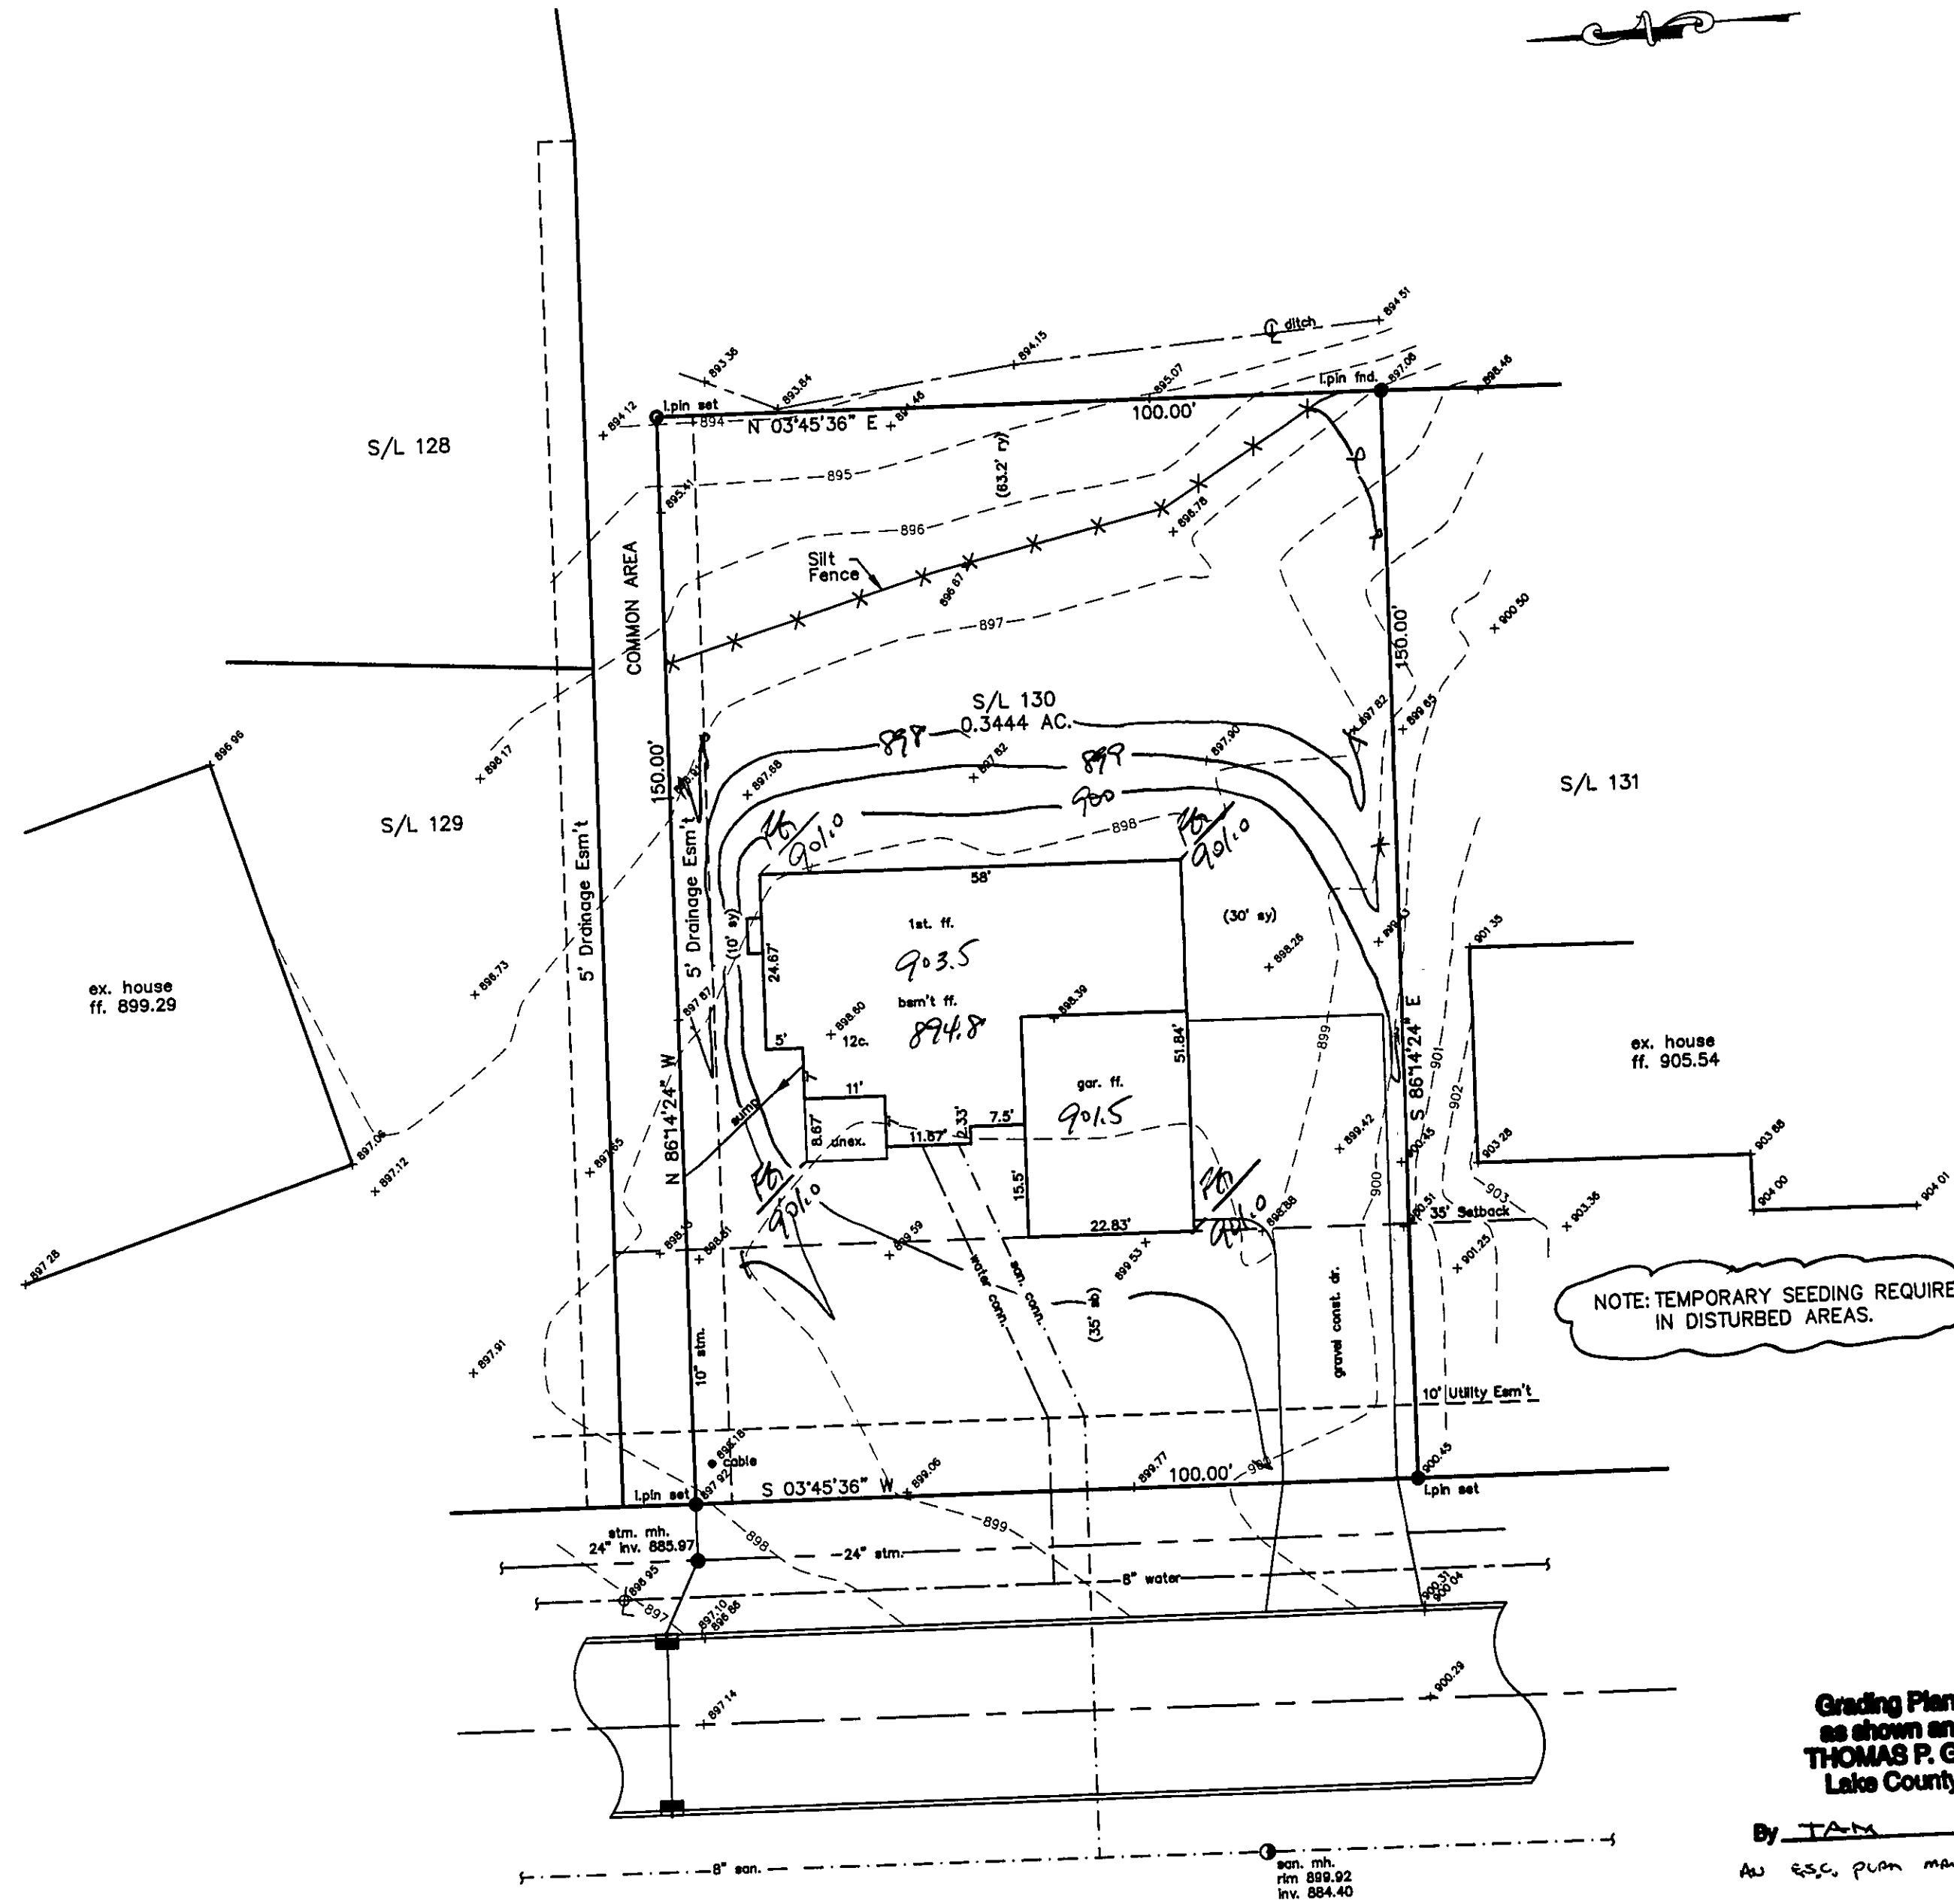

SITE PLAN

CONCORD TOWNSHIP, LAKE COUNTY, OHIO

for: SULLIVAN

CLIENT		OWNER	
ADDRESS	STREET	CITY	ZIP
QUAIL HOLLOW No. 3		TRACT	STREET
SUBDIVISION	21-33	NAME	LOT
130	VOL-PG.	HUNTING LAKE DRIVE	LOT
SUBLOT NO.	STREET	VOL-PG.	PERM. PARCEL NO.

LEGEND

SANITARY MANHOLE	---○---
STORM MANHOLE	---●---
INLET OR CATCH BASIN	---□---
HYDRANT	---○---
EXISTING CONTOURS	---○---
PROPOSED CONTOURS	---○---
EXST. ELEV.	100.0
PROP. ELEV.	100.0
AS BUILT ELEVATION	100.0
INDICATES DIRECTION OF SURFACE DRAINAGE	100.0

REMARKS

ALL BOUNDARY DATA SHOWN WAS OBTAINED FROM (DEEDS, RECORDED SUBDIVISION PLAT OR OTHER PUBLIC RECORDS)

LOCATIONS AS SHOWN OF ADJACENT WELLS AND SEPTIC TANKS OBTAINED FROM LAKE COUNTY HEALTH DEPARTMENT

DESIGN CERTIFICATION

THIS PLAT WAS PREPARED BY ME, AND IS CORRECT TO THE BEST OF MY KNOWLEDGE AND BELIEF.

NAME: *Harry S. Jones, Jr.* SURVEYOR REGISTRATION NO. *6343*

CHECK LIST

NO. OF BEDROOMS	WATER MAIN SIZE, LOCATION
DIMENSIONS	SAN. SEWER SIZE & GR. LOC.
BEARINGS	SAN. MH. CAST. ELEV. INV. ELEV.
TIE TO NEAREST STREET	SAN. CONN. SIZE, LOC. DEPTH
SUBLOT NO. PARCEL NO.	STORM SEWER SIZE & GR. LOC.
SURROUNDING OWNERS	STORM MH. CAST. ELEV. INV. ELEV.
BLDG. DIMENSIONS FIN GR.	PAV'T TYPE GRADE CURBS
BLDG. TIES FL'R. GRADES	GAS LINE LOC. SIZE PRESSURE
APRON TYPE WIDTH THICKNESS	SEPTIC TANK LOCATION & DUPLICATION AREA
SIDEWALK TYPE WIDTH THICKNESS	WELL LOCATION
CULVERT TYPE DIA., LENGTH	ISOLATION RADIUS FROM WELL
ROCK OUTCROPPINGS	

REVISIONS			PLAN PREPARED BY:	
NO.	DATE	BY	BABCOCK JONES & ASSOCIATES, INC.	
			PAINESVILLE, OHIO	
1			DRAWN BY T.R.	SCALE 1"=20'
2			CHK'D. H.J.	DATE 3/19/00
3			CREW W.B.	APPD H.J.
4			CHIEF	
5				

"AS BUILT" CERTIFICATION

I, HEREBY CERTIFY THAT THE CIRCLED GRADES ARE EXISTING FINISH GRADES CHECKED IN THE FIELD ON 4/4/2000, 20 0400-9705 AND ARE CORRECT TO THE BEST OF MY KNOWLEDGE AND BELIEF.

REGISTERED SURVEYOR REG. NO.

TBM-SANITARY MH.
RIM=899.92

Grading Plan Approved
as shown and/or noted
THOMAS P. GILLES, P.E.
Lake County Engineer

By TAM Date April 7, 2000
As ESC plan may be required by LCSWCD

ROOF DRAINS
SHALL DISCHARGE
TO SPLASH BLOCKS.

4/4/2000
ZONING PERMIT
ISSUED 0400-9705

SUBJECT TO APPROVAL BY:
Lake County Sanitary Eng. ☒
Lake County Eng. Dept. ☒
Lake County Planning Comm. ☒
Lake County Bldg. Dept. ☒
Lake Co. Soil & Water Cons. Dist.

