


ISSUED 2/19/99

SUBJECT TO APPROVAL BY:
 Lake County Sanitary Eng. ☐
 Lake County Eng. Dept. ☒
 Lake County Planning Comm. ☐
 Lake County Bldg. Dept. ☒

Grading Plan Approved
 as shown and/or noted
THOMAS P. GILLES, P.E.
 Lake County Engineer

TAM Date 2/22/99
 LOWER F.G. AS NOTED
 INSTALL YARD DRAIN

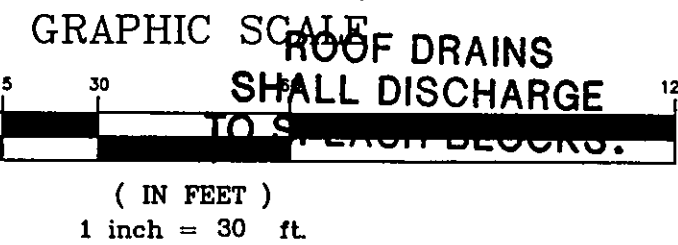

GENERAL NOTES:

1. DRIVEWAY APRON TO BE 6" THICK
2. BENCHMARK - TOP STEM OF FIRE HYDRANT LOCATED IN FRONT OF SUBLOT NO. 144 ELEV=926.07

LEGEND


- EXISTING CONTOUR
- PROPOSED CONTOUR
- EXISTING ELEVATION
- PROPOSED ELEVATION

CERTIFICATION

"I THE UNDERSIGNED HEREBY CERTIFY THAT THIS TOPOGRAPHY INDICATED BY 'I' CONTOURS AND ELEVATIONS SHOWN HEREON REPRESENTS AN ACTUAL SURVEY MADE BY ME ON THE 28TH DAY OF FEBRUARY, 1999 AND THE ELEVATIONS WERE TAKEN AT APPROPRIATE INTERVALS AND AS OF THAT DAY THEY EXISTED AS INDICATED HEREON.


"I HEREBY CERTIFY THAT THIS PLAN WAS PREPARED BY ME AND IS CORRECT TO THE BEST OF MY KNOWLEDGE"

David W. Novak
 DAVID W. NOVAK, P.S. No. 7507

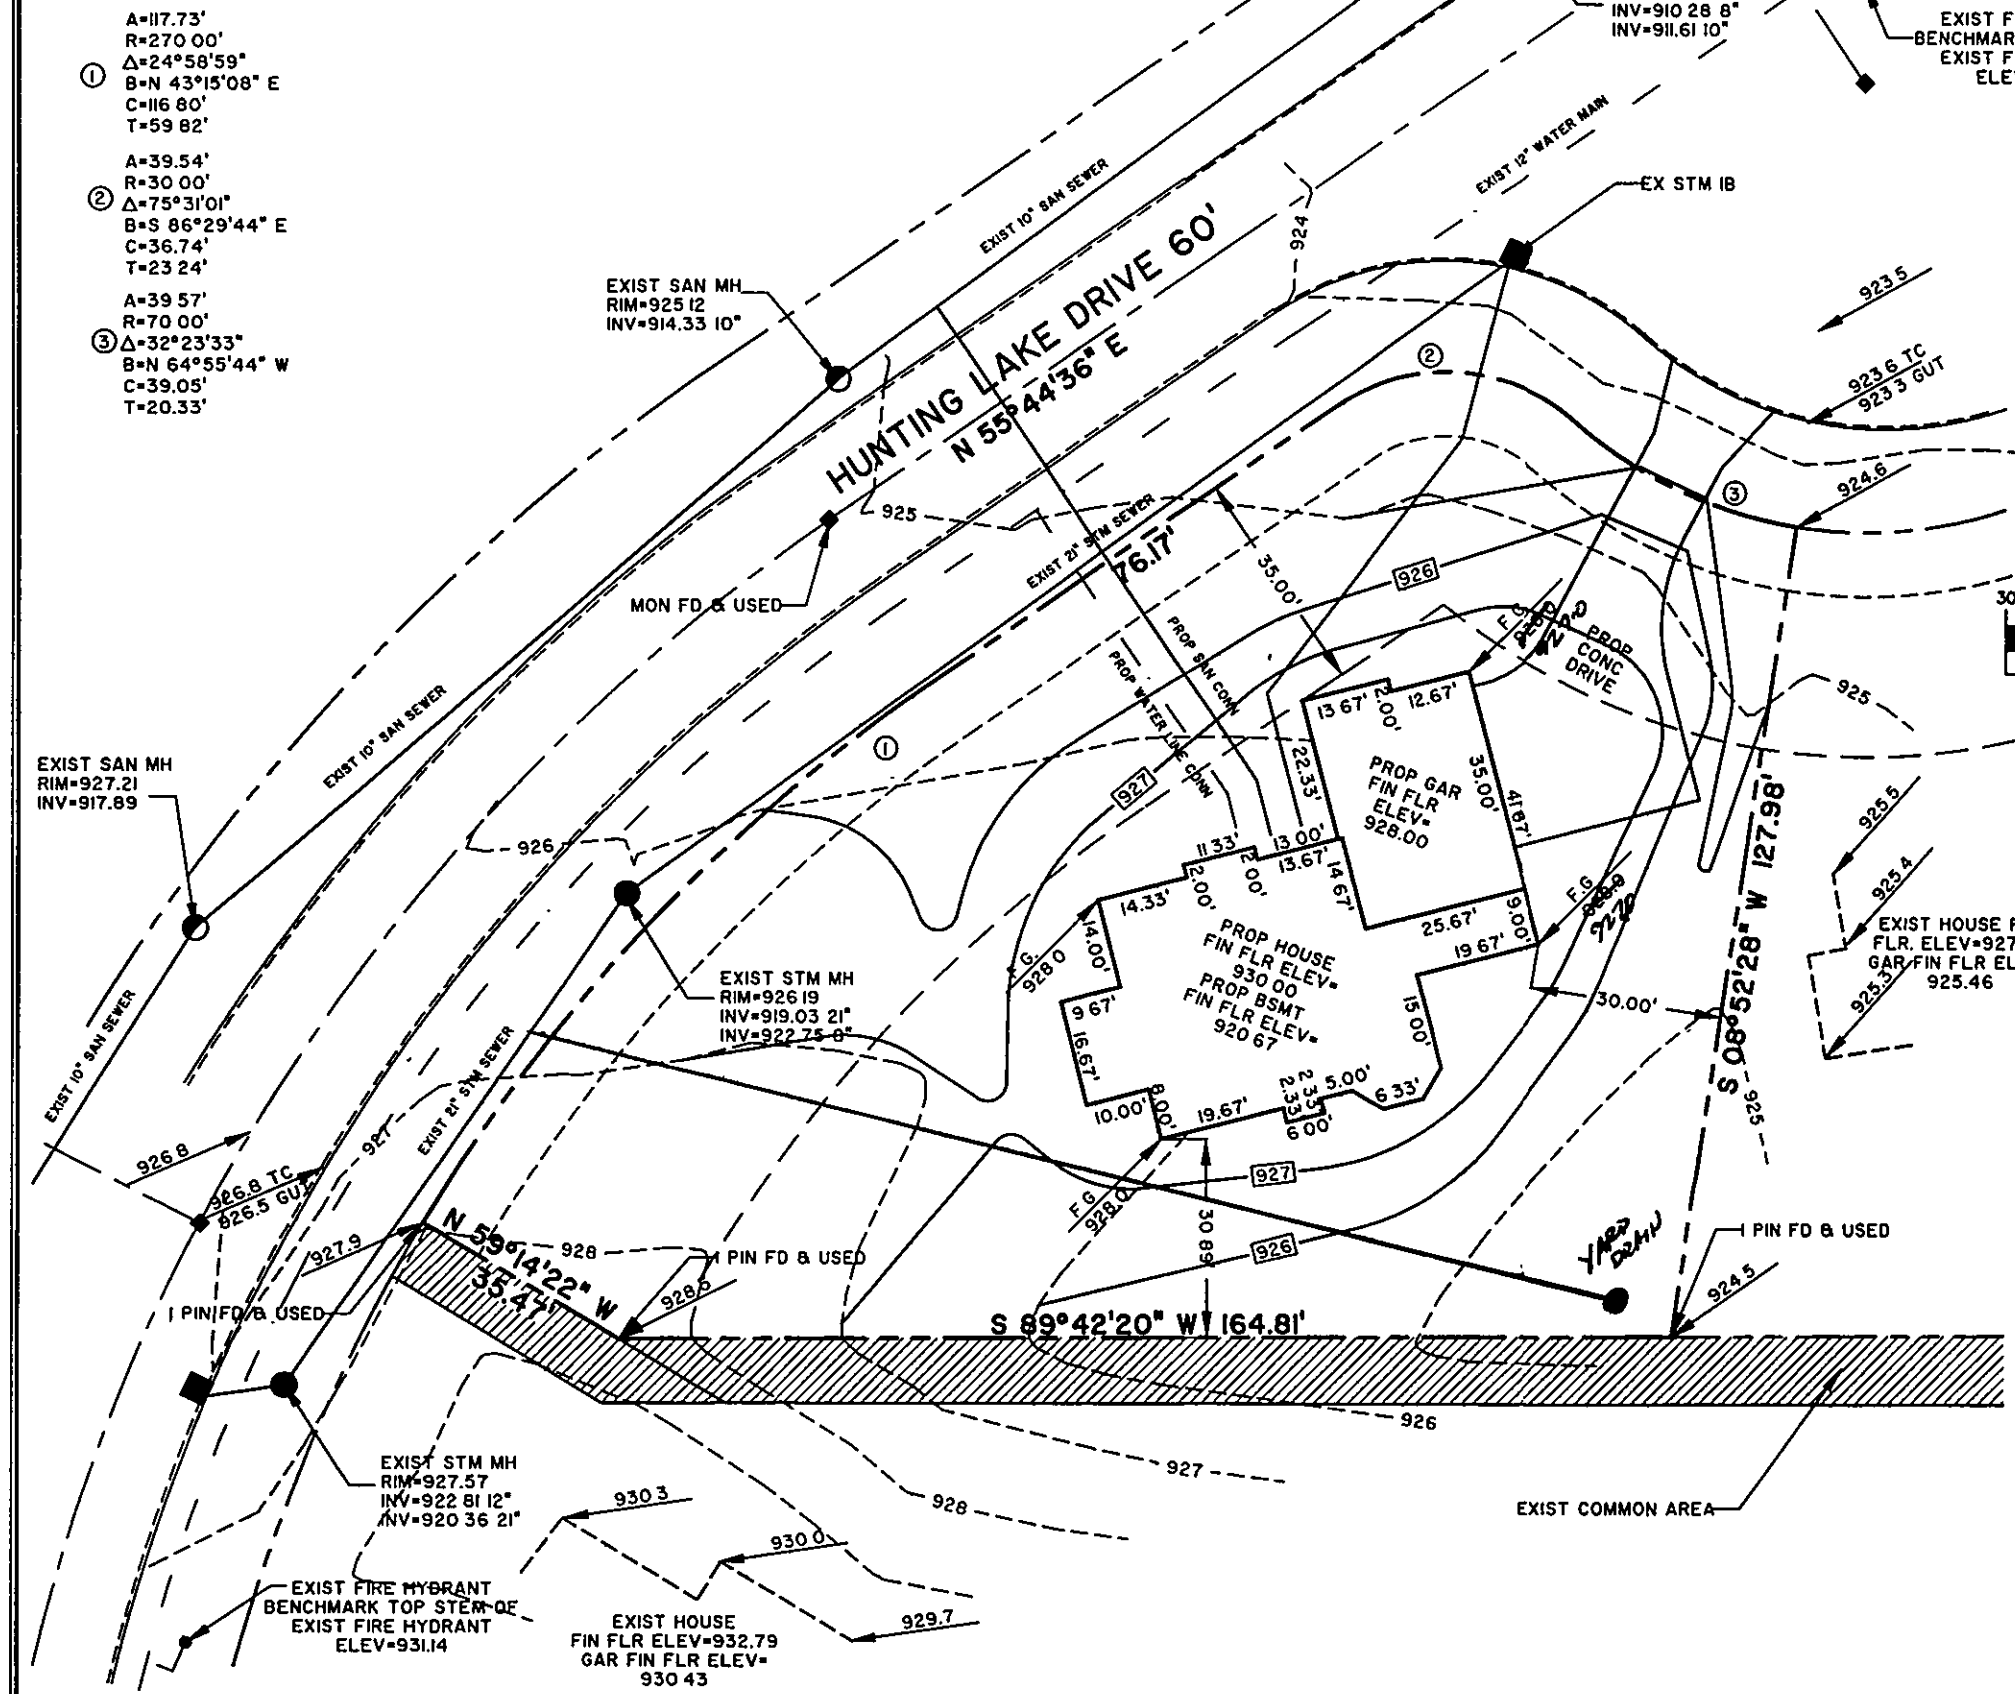

- ① A=117.73'
R=270.00'
Δ=24°58'59"
B=N 43°15'08" E
C=116.80'
T=59.82'
- ② A=39.54'
R=30.00'
Δ=75°31'01"
B=S 86°29'44" E
C=36.74'
T=23.24'
- ③ A=39.57'
R=70.00'
Δ=32°23'33"
B=N 64°55'44" W
C=39.05'
T=20.33'

REV	DESCRIPTION	DATE	BY	CHK'D

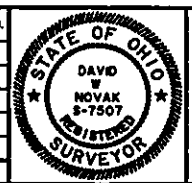

Himebaugh and Novak
 Surveyors and Site Consultants
 38342 Western Parkway, Unit 10
 Willoughby, Ohio 44094
 (440) 946-1761, (440) 918-0486 Fax.

KISS BUILDERS
 P.O. BOX 610, CHARDON, OH. 44024

DATE: FEB 1, 1999
 DRAWN BY: C.R. KRAFT
 CHECKED BY: DWN
 APPROVED BY: DWN

SITEPLAN
 SUBLOT NO. 145 HUNTING LAKE DRIVE, CONCORD, OH. 44077

SCALE:	
HORIZ. 1" = 30'	
VERT. 1" = 10'	
CONTRACT NO.	
99009	
SHEET NO.	
OF	