


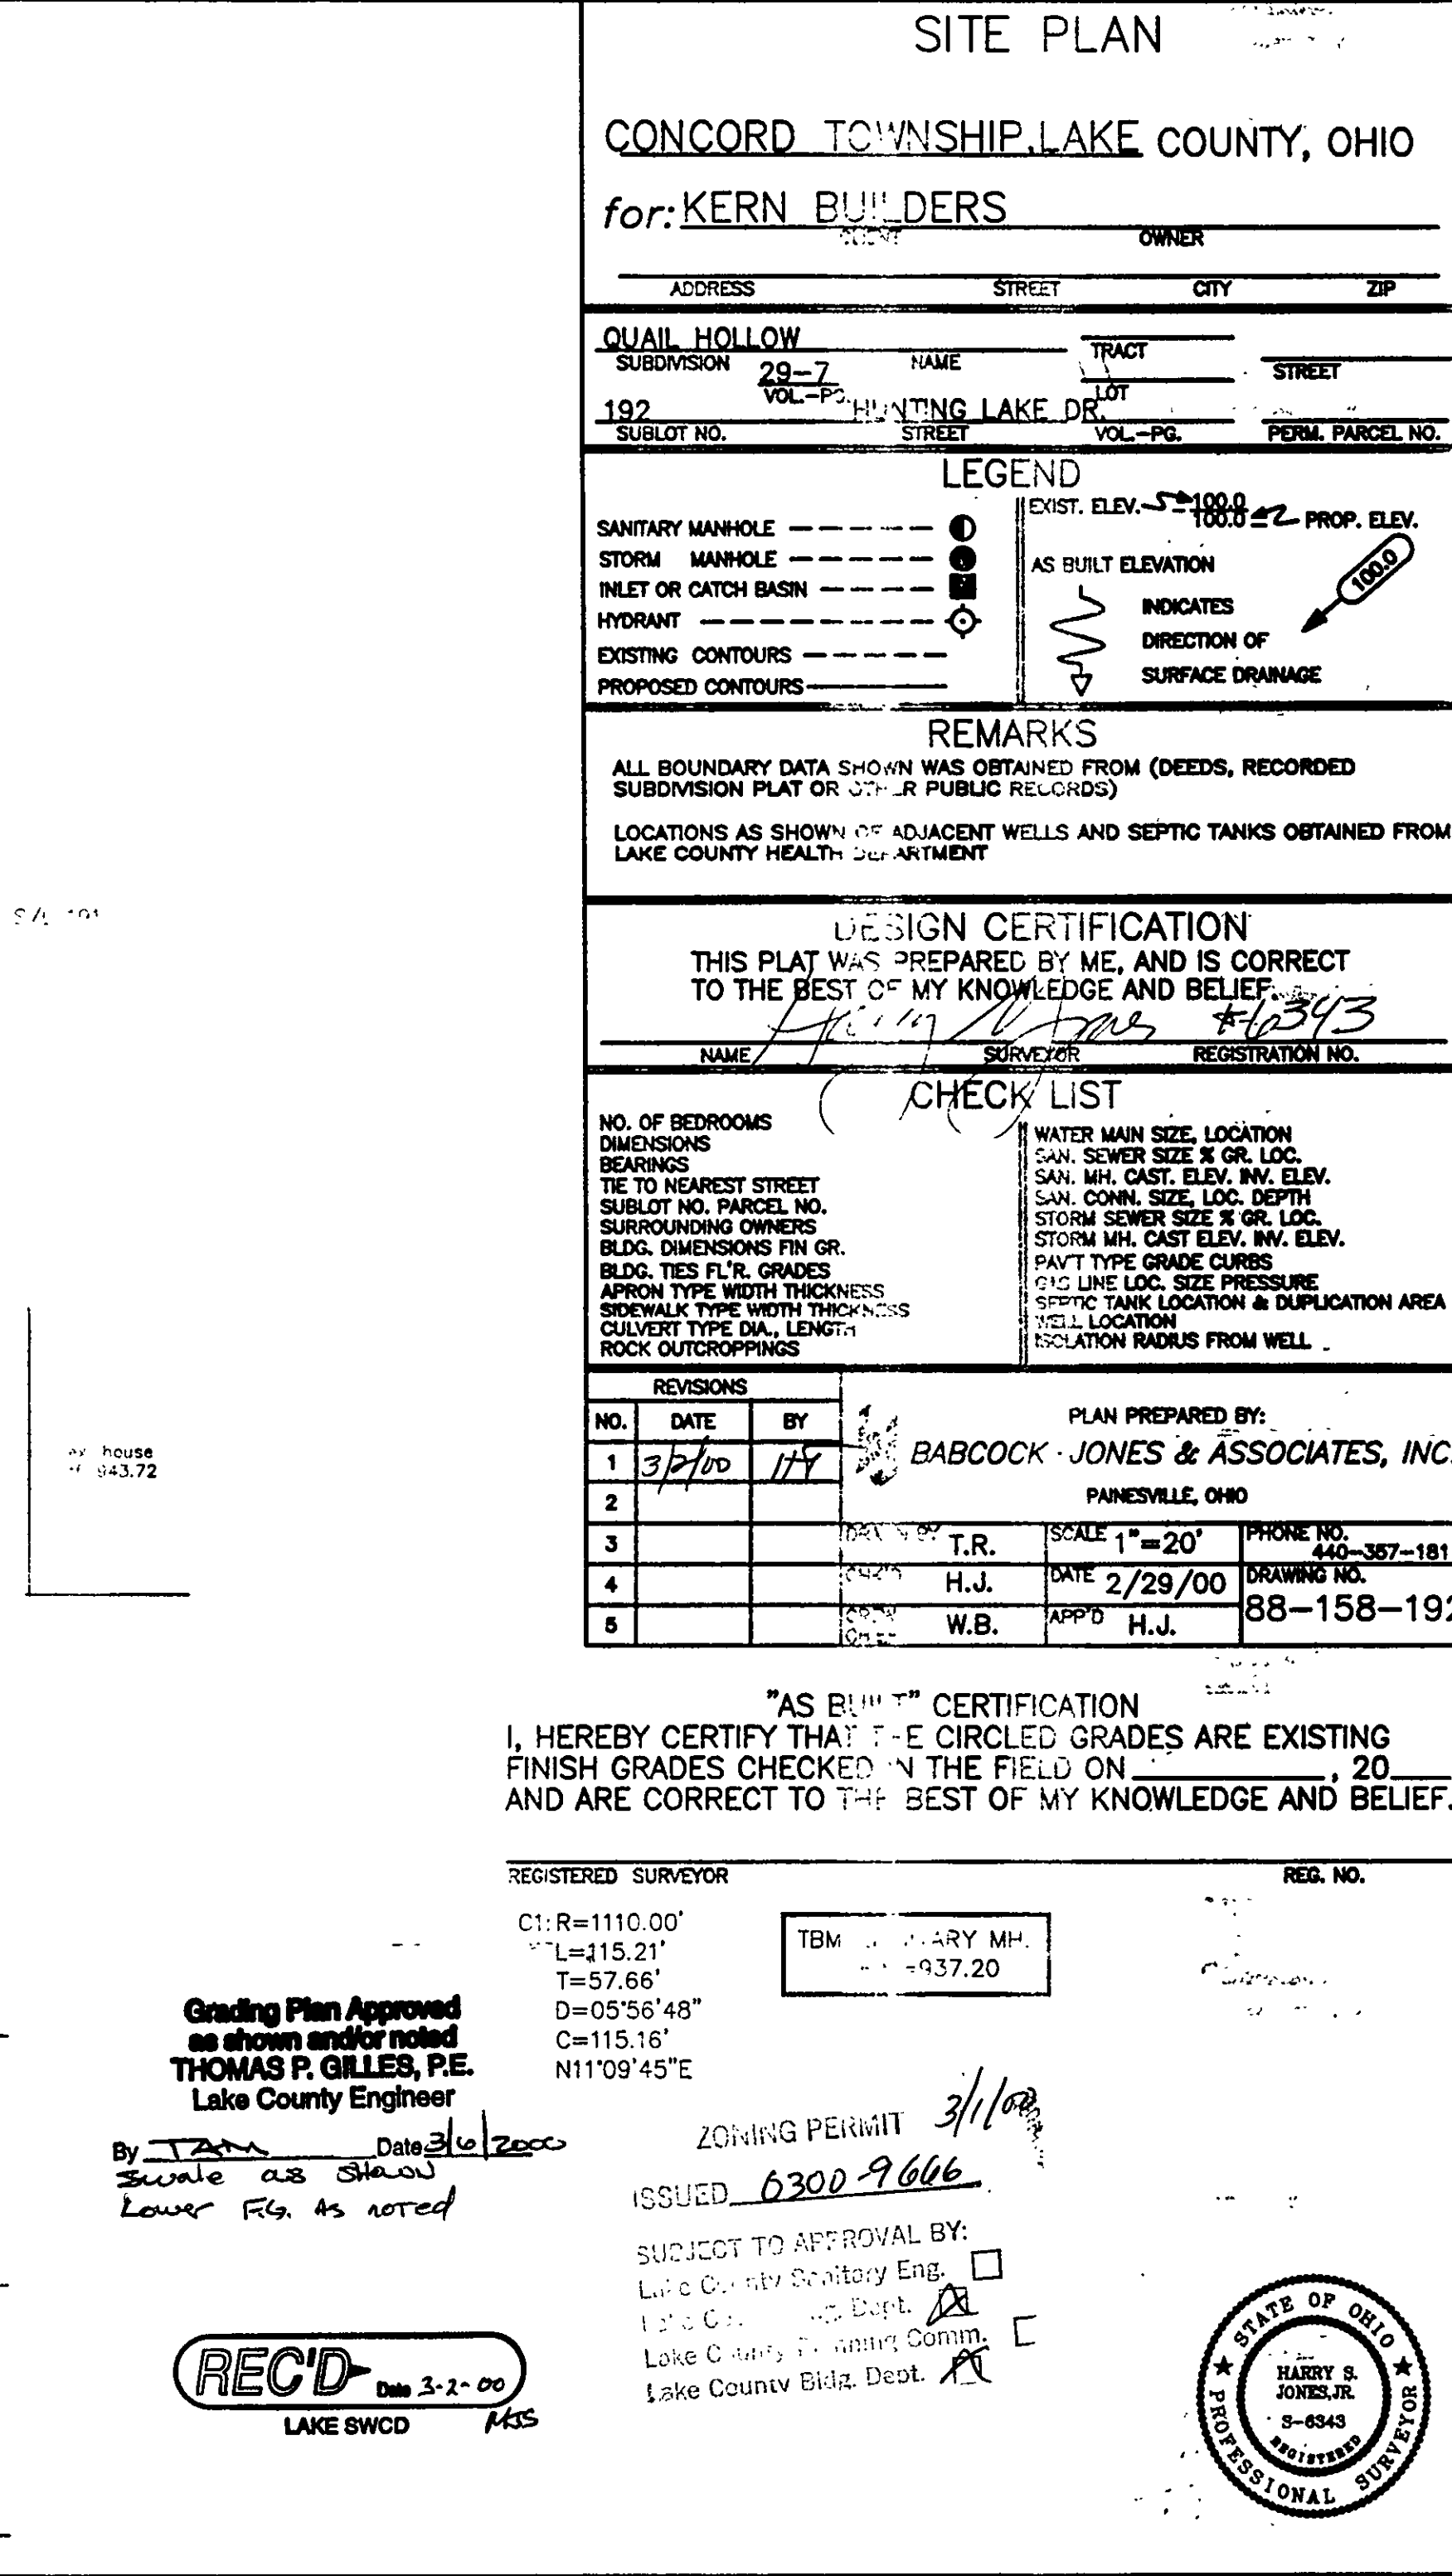

REC'D Date 3-2-00
LAKE SWCD MJS

A circular professional seal for Harry S. Jones, Jr. The outer ring contains the text "STATE OF OHIO" at the top and "PROFESSIONAL SURVEYOR" at the bottom, separated by two five-pointed stars. The inner circle contains the name "HARRY S. JONES, JR." in the center, the number "6-6343" below it, and the word "REGISTERED" at the very bottom.