


Grading Plan Approved
as shown and/or noted
THOMAS P. GILLES, P.E.
Lake County Engineer

By T.P.G. Date 5 Dec 72

BUILDING SITE PLAN FOR
THOMAS MORELLO
LOT No. 12 - TRACT No. 1 CONCORD TWP.
LAKE COUNTY OHIO
Scale 1" = 50' Nov. 29, 1972
Joseph D. Hadden - Reg. Surveyor

Zoning Permit # 2428
Issued Dec. 4, 1972
J.E. new sheet.

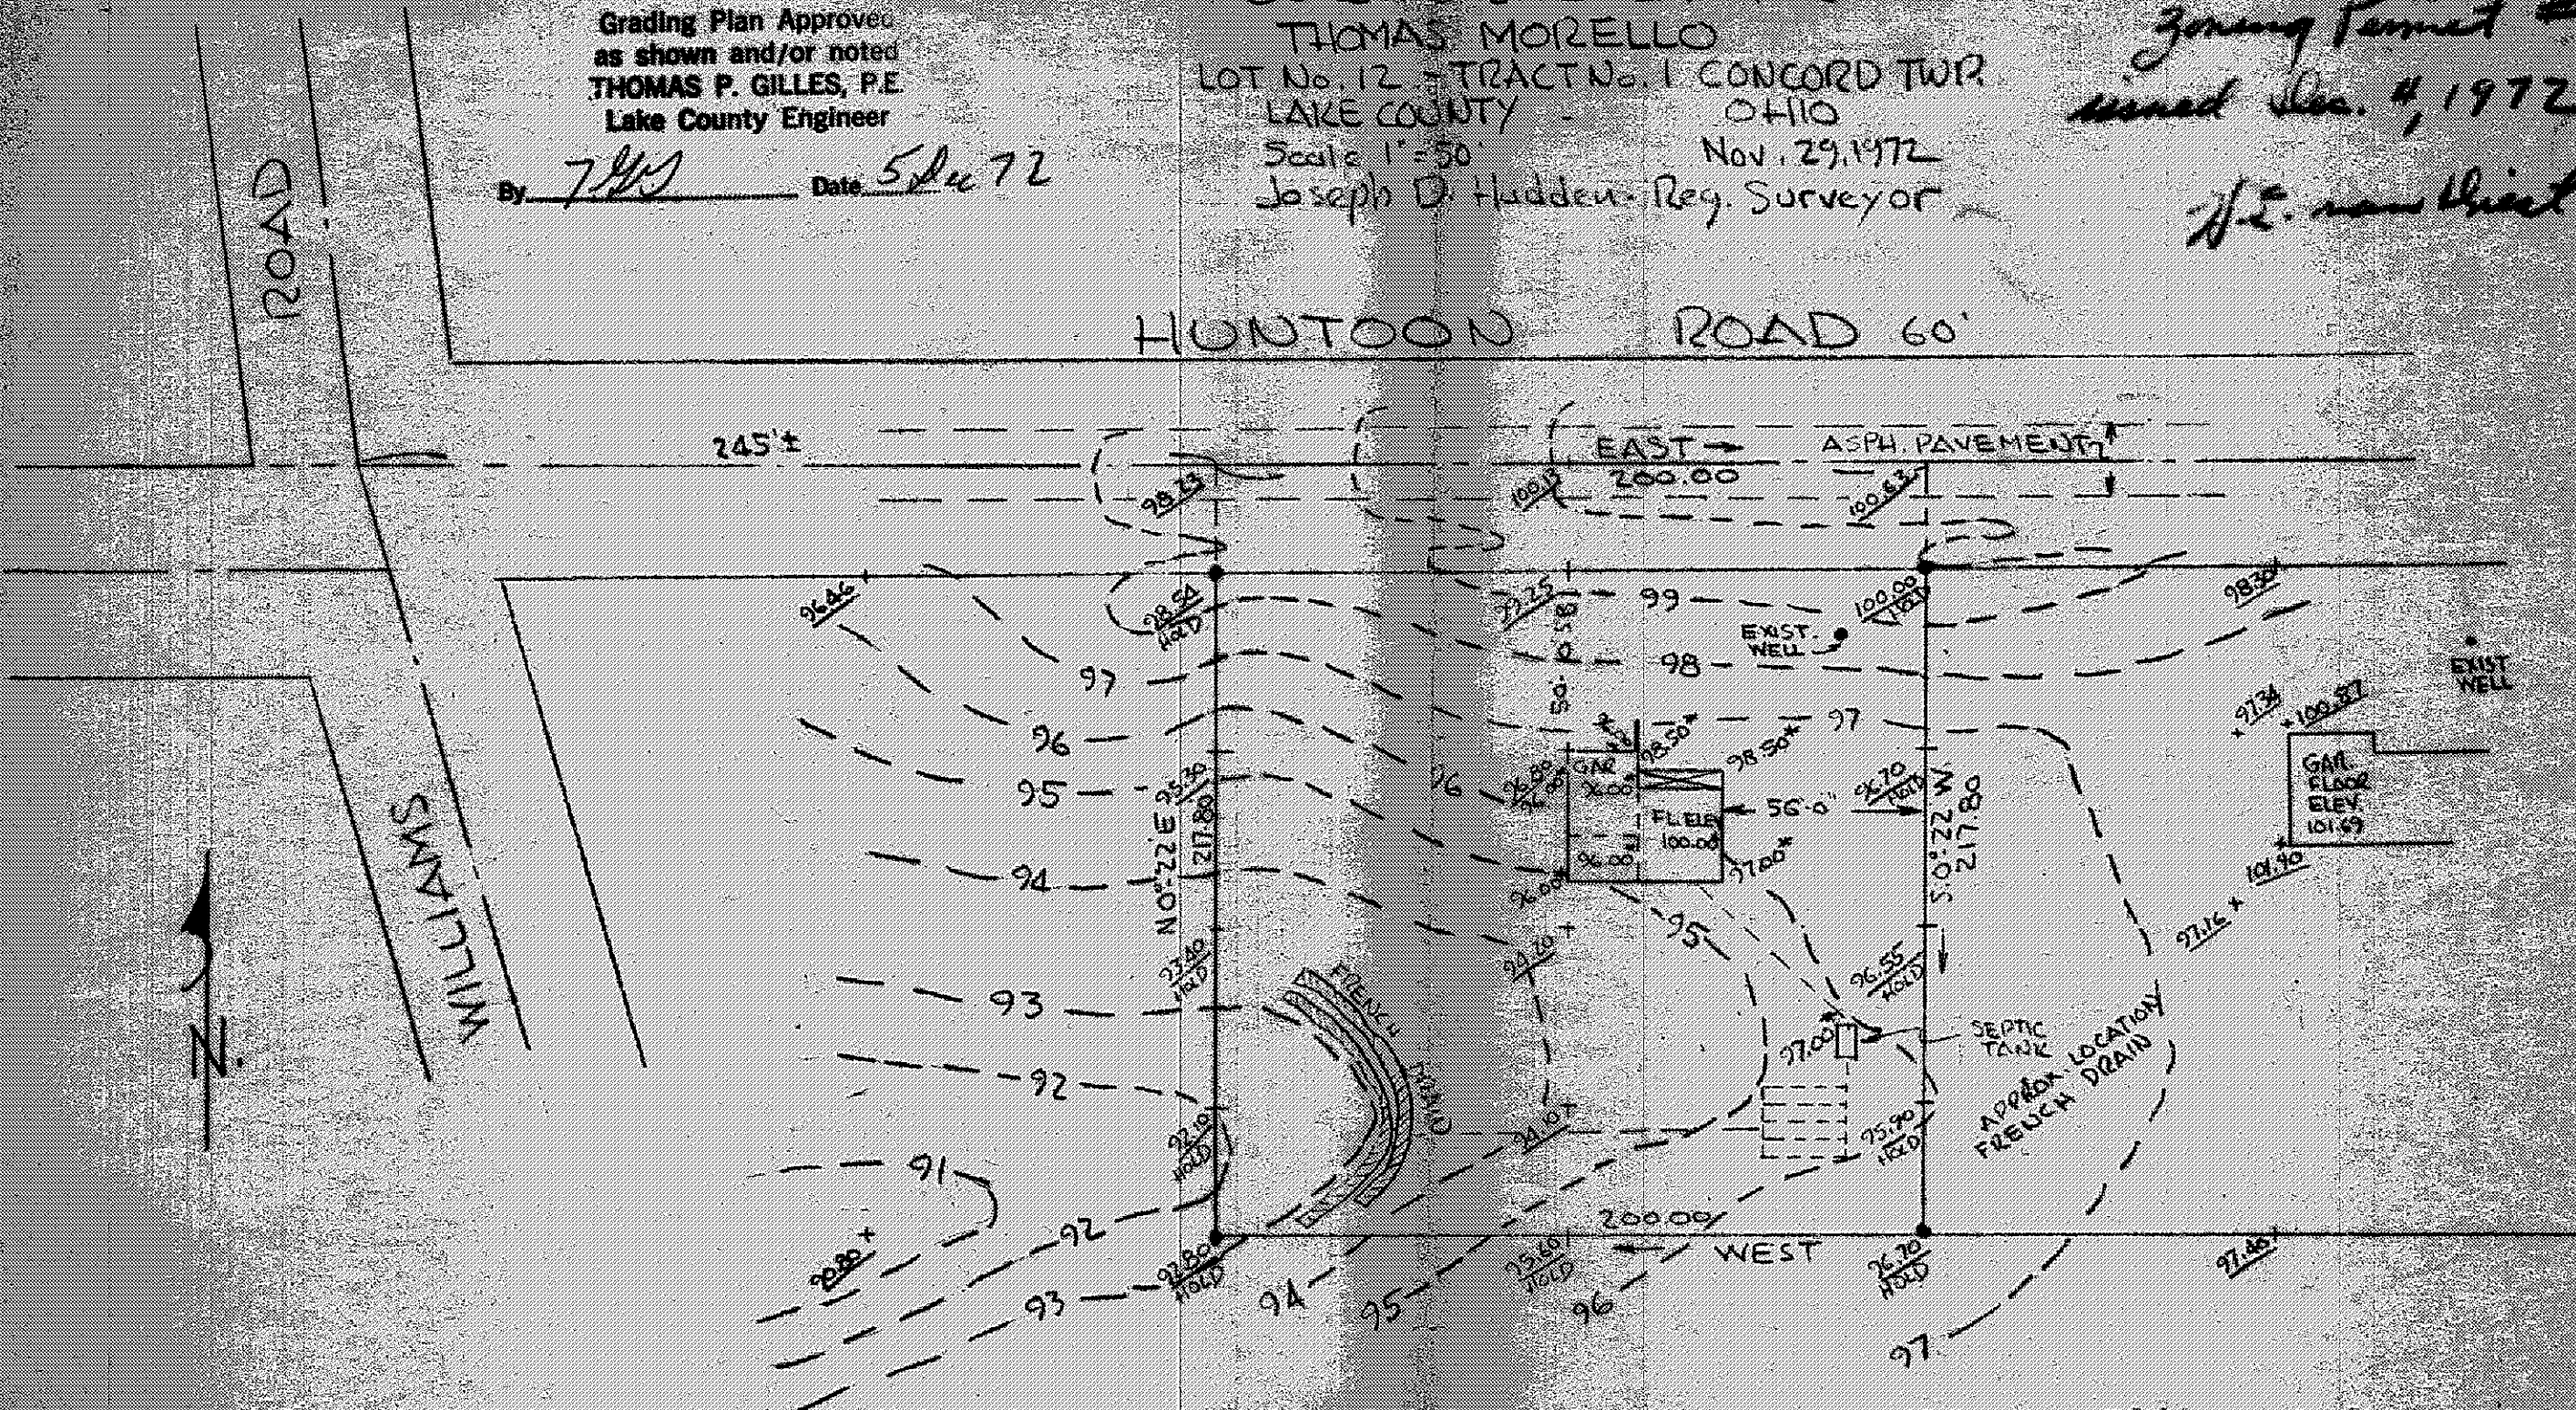

FRENCH DRAIN INLET - - 92.00
FILTER BED OUTLET - - 92.30
FILTER BED INLET - - 95.30
SEPTIC TANK OUTLET - - 95.50
SEPTIC TANK INLET - - 96.00

EXIST. ELEV. - 95.90
PROPOSED ELEV. - 95.90*
BENCH MARK TOP IRON PIN
AT NORTHEAST CORNER OF LOT - 100.53