



REVIEWED AND ACCEPTED
LAKE COUNTY GENERAL
HEALTH DISTRICT

Date 5-10-01 *David*

SEWAGE DISPOSAL PERMIT MUST BE
OBTAINED BY A LAKE COUNTY LICENSED
INSTALLER BEFORE INSTALLATION IS
STARTED

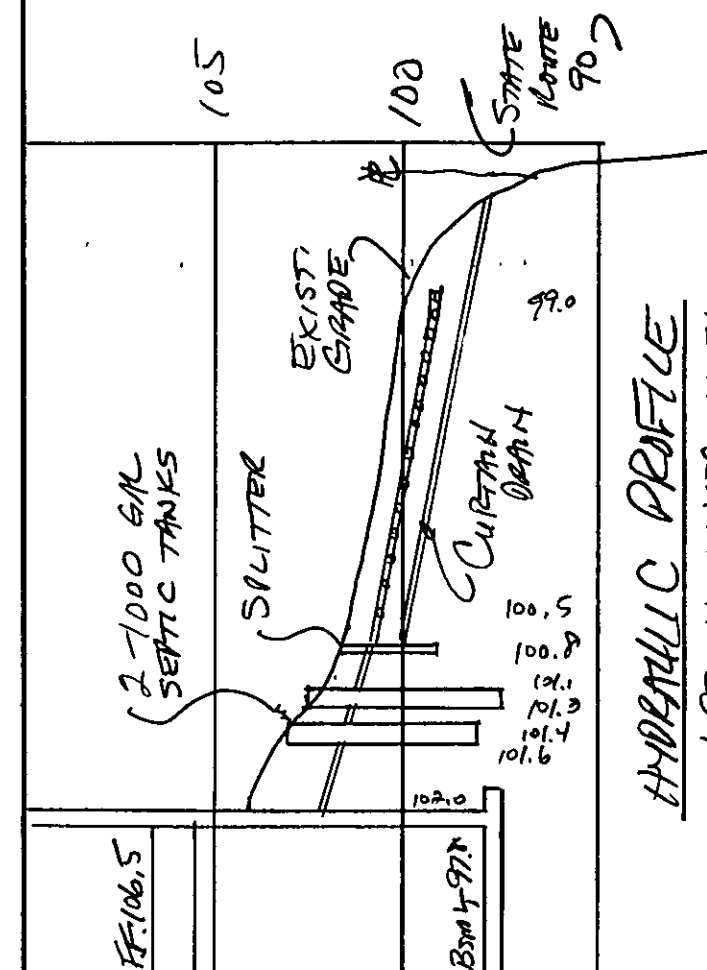

NOTE: TEMPORARY SEEDING REQUIRED
IN DISTURBED AREAS.

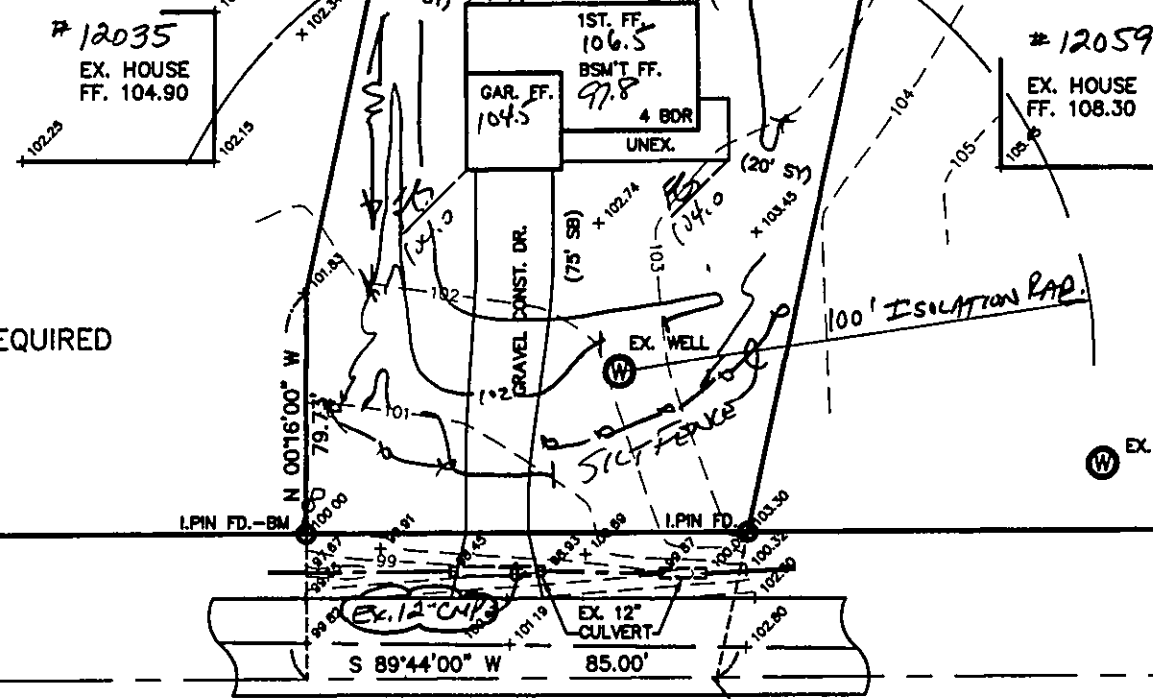

HUNTOON ROAD - 60'

Grading Plan Approved
as shown and/or noted
JAMES R. GILLS, P.E.
Lake County Engineer

By *TAM* Date 5-10-01
Scale as shown

ROOF DRAINS
SHALL DISCHARGE
TO SPLASH BLOCKS.

BALANCE OF PARCEL

CONCORD TOWNSHIP ZONING OFFICE

ZONING PERMIT # *0501-10127*

ISSUED *5/10/2001*

SUBJECT TO APPROVAL BY:

- ☐ Lake Co. Sanitary Engineer
- ☒ Lake Co. Eng. Dept.
- ☐ Lake Co. Planning Comm.
- ☒ Lake Co. Building Dept.
- ☒ Lake Co. Soil & Water Cons. Dist.

BM-IRON PIN FOUND
ELEV. = 100.00

"I, the undersigned hereby certify that
this topography indicated by 6", 1", or 2"
contours, and elevations shown hereon
represent an actual field survey made by
me on the *26th* day of *April*, 20 *01*
and that the elevations were taken at
appropriate intervals and that as of that
date they existed as indicated hereon."

Name *Harry Jones* #6343 Reg. No.

SITE PLAN

CONCORD TOWNSHIP, LAKE COUNTY, OHIO

for: **MATT KRUPKA**

CLIENT OWNER

ADDRESS STREET CITY ZIP

SUBDIVISION NAME TRACT **HUNTOON RD.**

VOL-PG. LOT STREET

SUBLOT NO. STREET VOL-PG. **PA-10-**

PERM. PARCEL NO.

LEGEND

SANITARY MANHOLE --- EXIST. ELEV. *100.0* PROP. ELEV. *100.0*
STORM MANHOLE ---
INLET OR CATCH BASIN ---
HYDRANT ---
EXISTING CONTOURS ---
PROPOSED CONTOURS ---
AS BUILT ELEVATION
INDICATES
DIRECTION OF
SURFACE DRAINAGE

REMARKS

ALL BOUNDARY DATA SHOWN WAS OBTAINED FROM (DEEDS, RECORDED
SUBDIVISION PLAT OR OTHER PUBLIC RECORDS)

LOCATIONS AS SHOWN OF ADJACENT WELLS AND SEPTIC TANKS OBTAINED FROM
LAKE COUNTY HEALTH DEPARTMENT

DESIGN CERTIFICATION

THIS PLAT WAS PREPARED BY ME, AND IS CORRECT
TO THE BEST OF MY KNOWLEDGE AND BELIEF

NAME *Harry Jones* #6343 SURVEYOR REGISTRATION NO.

CHECK LIST

NO. OF BEDROOMS
DIMENSIONS
BEARINGS
TIE TO NEAREST STREET
SUBLOT NO. PARCEL NO.
SURROUNDING OWNERS
BLDG. DIMENSIONS FIN GR.
BLDG. TIES FL'R. GRADES
APRON TYPE WIDTH THICKNESS
SIDEWALK TYPE WIDTH THICKNESS
CULVERT TYPE DIA. LENGTH
ROCK OUTCROPPINGS
WATER MAIN SIZE, LOCATION
SAN. SEWER SIZE & GR. LOC.
SAN. MH. CAST. ELEV. INV. ELEV.
SAN. CONN. SIZE, LOC. DEPTH
STORM SEWER SIZE & GR. LOC.
STORM MH. CAST. ELEV. INV. ELEV.
PACT TYPE GRADE CURBS
GAS LINE LOC. SIZE PRESSURE
SEPTIC TANK LOCATION & DUPLICATION AREA
WELL LOCATION
ISOLATION RADIUS FROM WELL

REVISIONS

NO.	DATE	BY
1	<i>5/2/01</i>	<i>HJ</i>
2		
3		
4		
5		

PLAN PREPARED BY:
BABCOCK JONES & ASSOCIATES, INC.
PAINESVILLE, OHIO

DRAWN BY T.R. SCALE 1"=40' PHONE NO. 440-357-1811
CHK'D. H.J. DATE 4/27/01 DRAWING NO.
CREW R.B. APP'D H.J. 01-063

"AS BUILT" CERTIFICATION

I, HEREBY CERTIFY THAT THE CIRCLED GRADES ARE EXISTING
FINISH GRADES CHECKED IN THE FIELD ON *20*
AND ARE CORRECT TO THE BEST OF MY KNOWLEDGE AND BELIEF.

