

SITE PLAN

Colored Township, Lake County, Ohio

for: **Bob D. Cullum Construction**

1753 Southgate Lane, P.O. Box 114, Dayton, Ohio 45404

Subdivision: **1753 Southgate Lane**
 Lot: **114**
 Volume: **114**
 Page: **1**

LEGEND	REMARKS
SANITARY MANHOLE STORM MANHOLE INLET OR CATCH BASIN HYDRANT EXISTING CONTOURS PROPOSED CONTOURS EXIST. ELEV. 100' PROP. ELEV.	WATER VALVE (GAS) WATER METER (GAS) AS BUILT ELEVATION INDICATES DIRECTION OF SURFACE DRAINAGE

ALL BOUNDARY DATA SHOWN WAS OBTAINED FROM IDEEDS, RECORDED SUBDIVISION PLAT OR OTHER PUBLIC RECORDS.
 LOCATIONS AS SHOWN OF ADJACENT WELLS AND SEPTIC TANKS OBTAINED FROM LAKE COUNTY HEALTH DEPARTMENT

DESIGN CERTIFICATION

THIS PLAT WAS PREPARED BY ME, AND IS CORRECT TO THE BEST OF MY KNOWLEDGE AND BELIEF.

NAME: **Harry S. Jones, Jr.** SURVEYOR REGISTRATION NO. **56343**


CHECK LIST

NO.	DATE	BY	REVISIONS
1	4/18/88	HT	PLAN PREPARED BY: BABCOCK & JONES & ASSOCIATES, INC. PAINESVILLE, OHIO
2	4/21/88	HT	SCALE 1" = 40'
3	6/14/88	HT	DATE: 5/14/88
4		CHIEF	DATE: 5/14/88
5		CHIEF	DATE: 5/14/88

"AS BUILT" CERTIFICATION
 I, HEREBY CERTIFY THAT THE CIRCLED GRADES ARE EXISTING FINISH GRADES CHECKED IN THE FIELD ON 19 **1988** AND ARE CORRECT TO THE BEST OF MY KNOWLEDGE AND BELIEF.

REGISTERED SURVEYOR REG. NO. **1988**

T.B.M. - L.M. 5744 M.H.
 ELEV. = 825.96

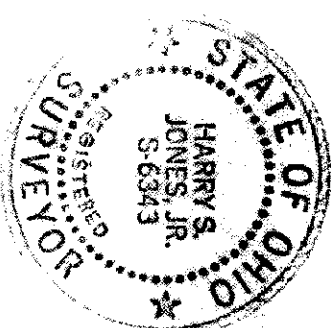

Grading Plan Approved
 as shown and/or noted
 THOMAS P. GILLES, P.E.
 Lake County Engineer
 Date: **6/21/88**

IT SLEY SOURCE - 60'

THATCHUM LAKE - 60'

