


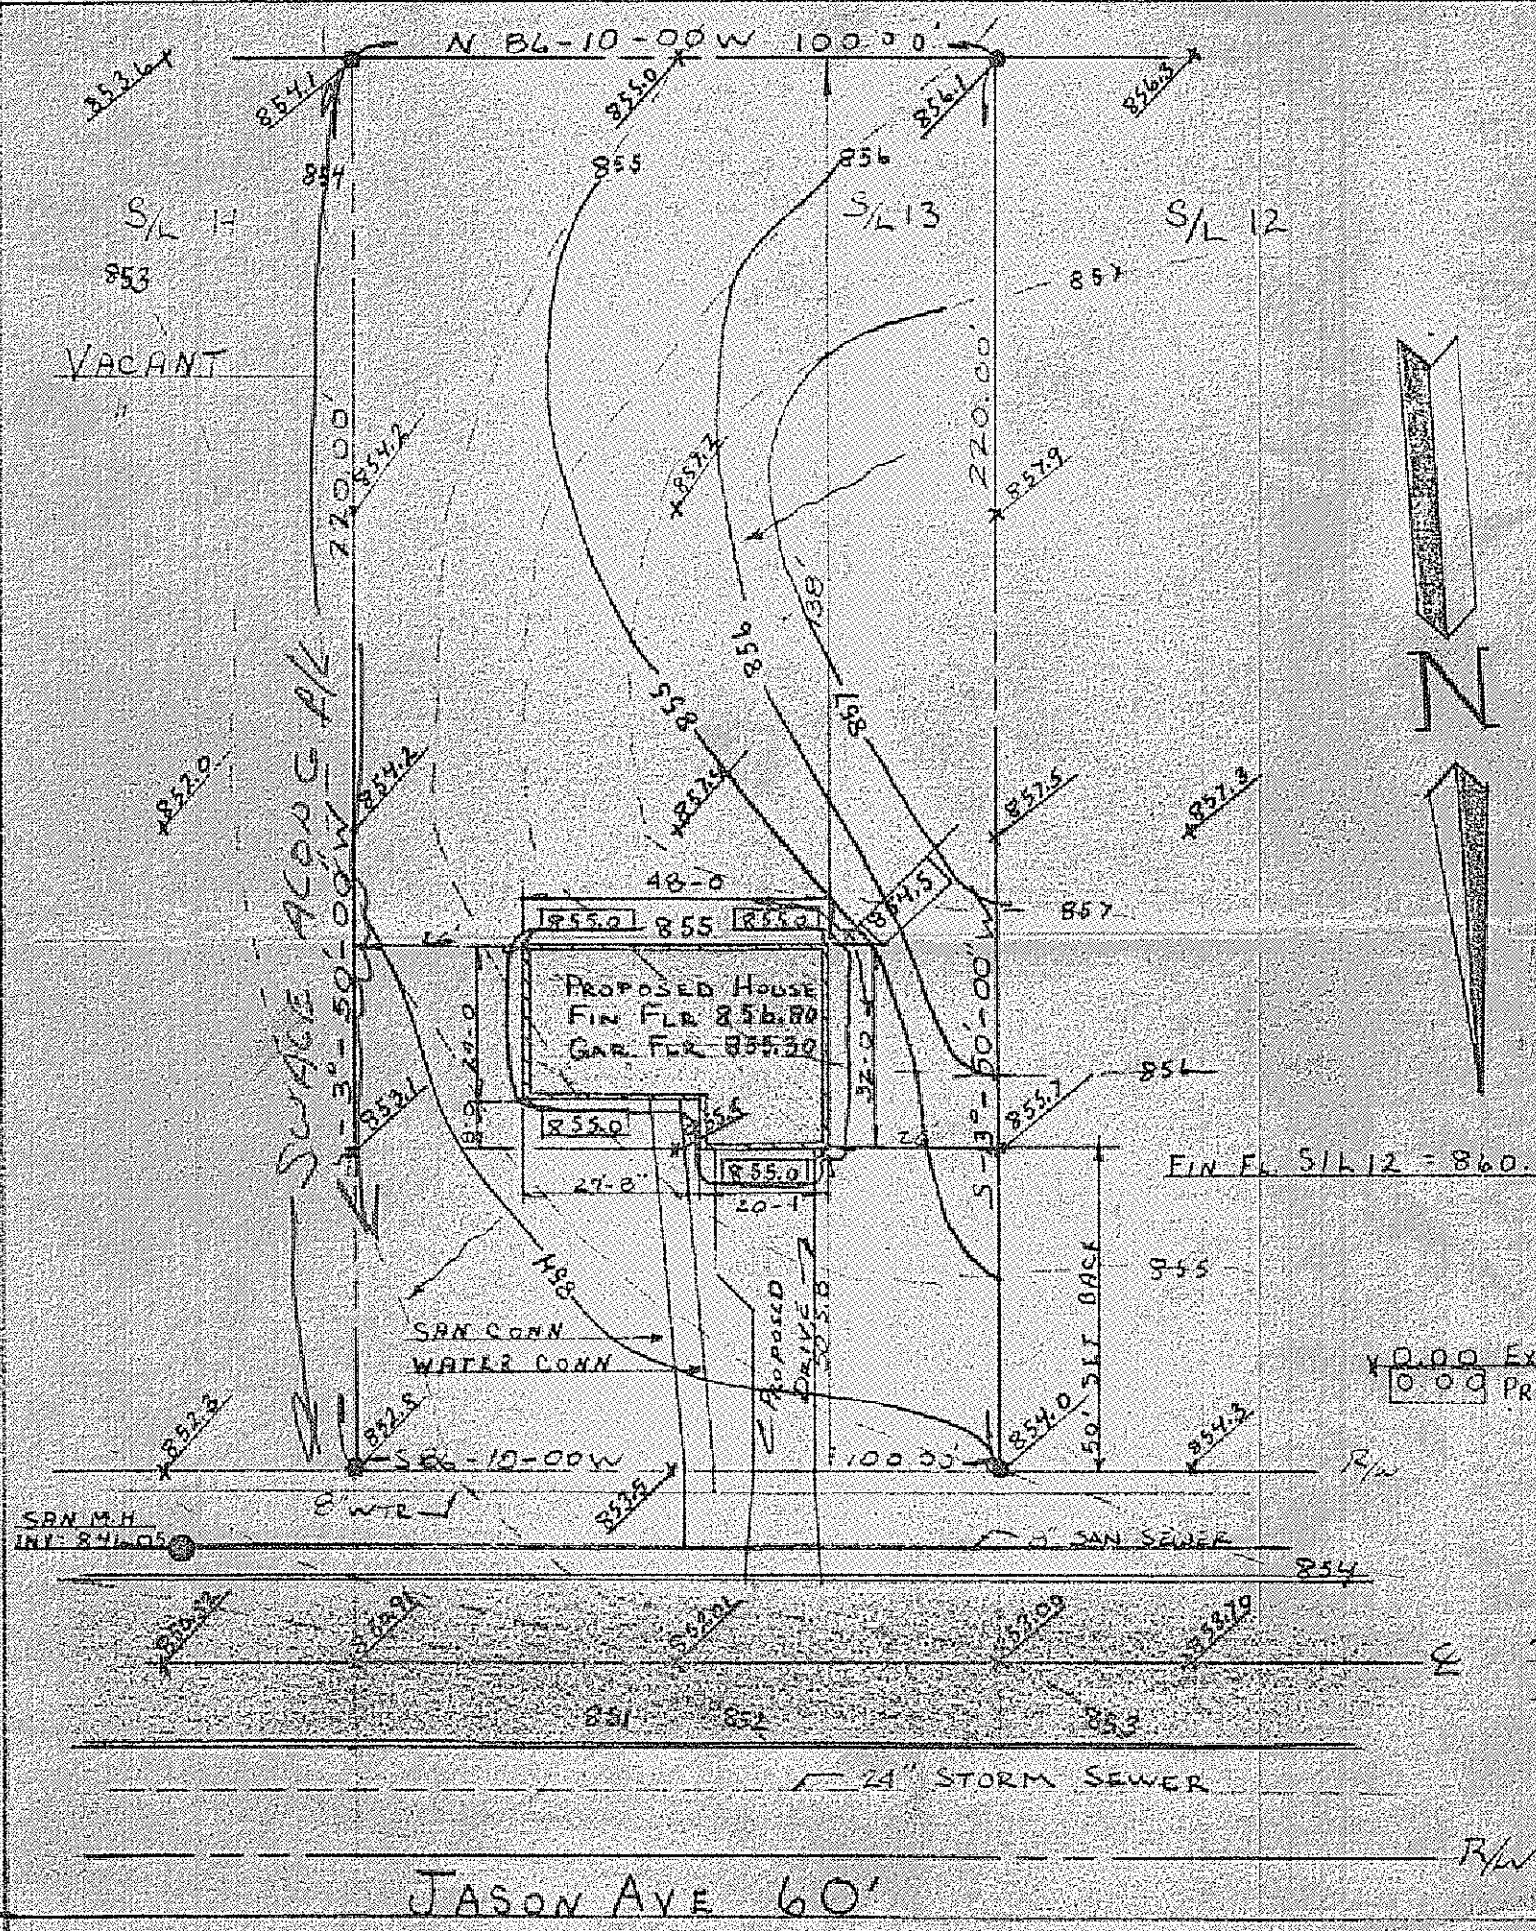


IF PROPOSED HOUSE
HAS A BASEMENT
Then Footers CAN
NOT BE TIED INTO
EXISTING SAN. SEWER
Grading Plan Approved
as shown and/or noted
THOMAS P. GILLES, P. E.
Lake County Engineer
By TWO Date 6 JAN 78

3502
ZONING
PERMIT
12-73-47
Wm. R. Gray

SITE PLAN FOR:
RYAN HOME
3141 TYLER BLVD
MENTOR OHIO
BEING SUBLOT NO 13 IN
FAR HILL ESTATE NO 2 IN
CONCORD TWP, LAKE COUNTY
OHIO

PREPARED BY:
WM. R. GRAY AND ASSOC. INC.
7547 MENTOR AVE
MENTOR OHIO
SCALE: 1" = 30'
DATE: DEC. 7, 1977

CERTIFICATION:
I HEREBY CERTIFY THAT
THIS PLAN IS CORRECT TO
THE BEST OF MY KNOWLEDGE
BY Wm. R. Gray

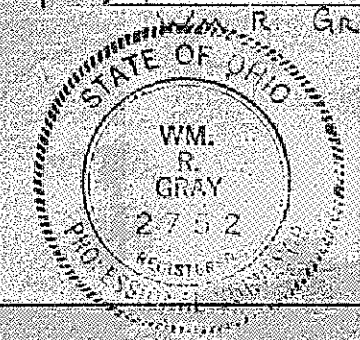

T.B.M. RIM = 856.95 AT
N.W. CORNER S/L 12