

SITE PLAN FOR:

RYAN HOMES

8141 TYLER BLVD.

MENTOR OHIO

BEING SUBLLOT NUMBER 20
IN FAR HILLS ESTATES NO 2 IN
CONCORD TWP LAKE COUNTY OHIO

Grading Plan Approved
as shown and/or noted

THOMAS P. GILLES, P. E.

Lake County Engineer

By FW Date 5 MAY 78

PREPARED BY

WM. R. GRAY ASSOC. INC.

7547 MENTOR AVE

MENTOR OHIO

SCALE: 1" = 30'

DATE: MAY 9, 1978

CERTIFICATION:

I HEREBY CERTIFY THAT THIS
PLAN IS CORRECT TO THE BEST OF
MY KNOWLEDGE

By Terrence J. Gilson P.E.

WM. R. GRAY Reg. Engr. #2752

ZONING PERMIT
#3607

ISSUED 5-10-78


SUBJECT TO APPROVAL BY:

Lake County Sanitary Eng. ☐

Lake County Eng. Dept. ☒

Lake County Planning Comm. ☐

Lake County Eng. ☒

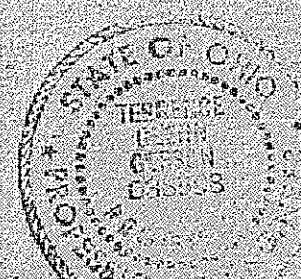


W. R. Gray

Dr. By:

Ch. By:

SHERENDOAH

F.B. 79-47

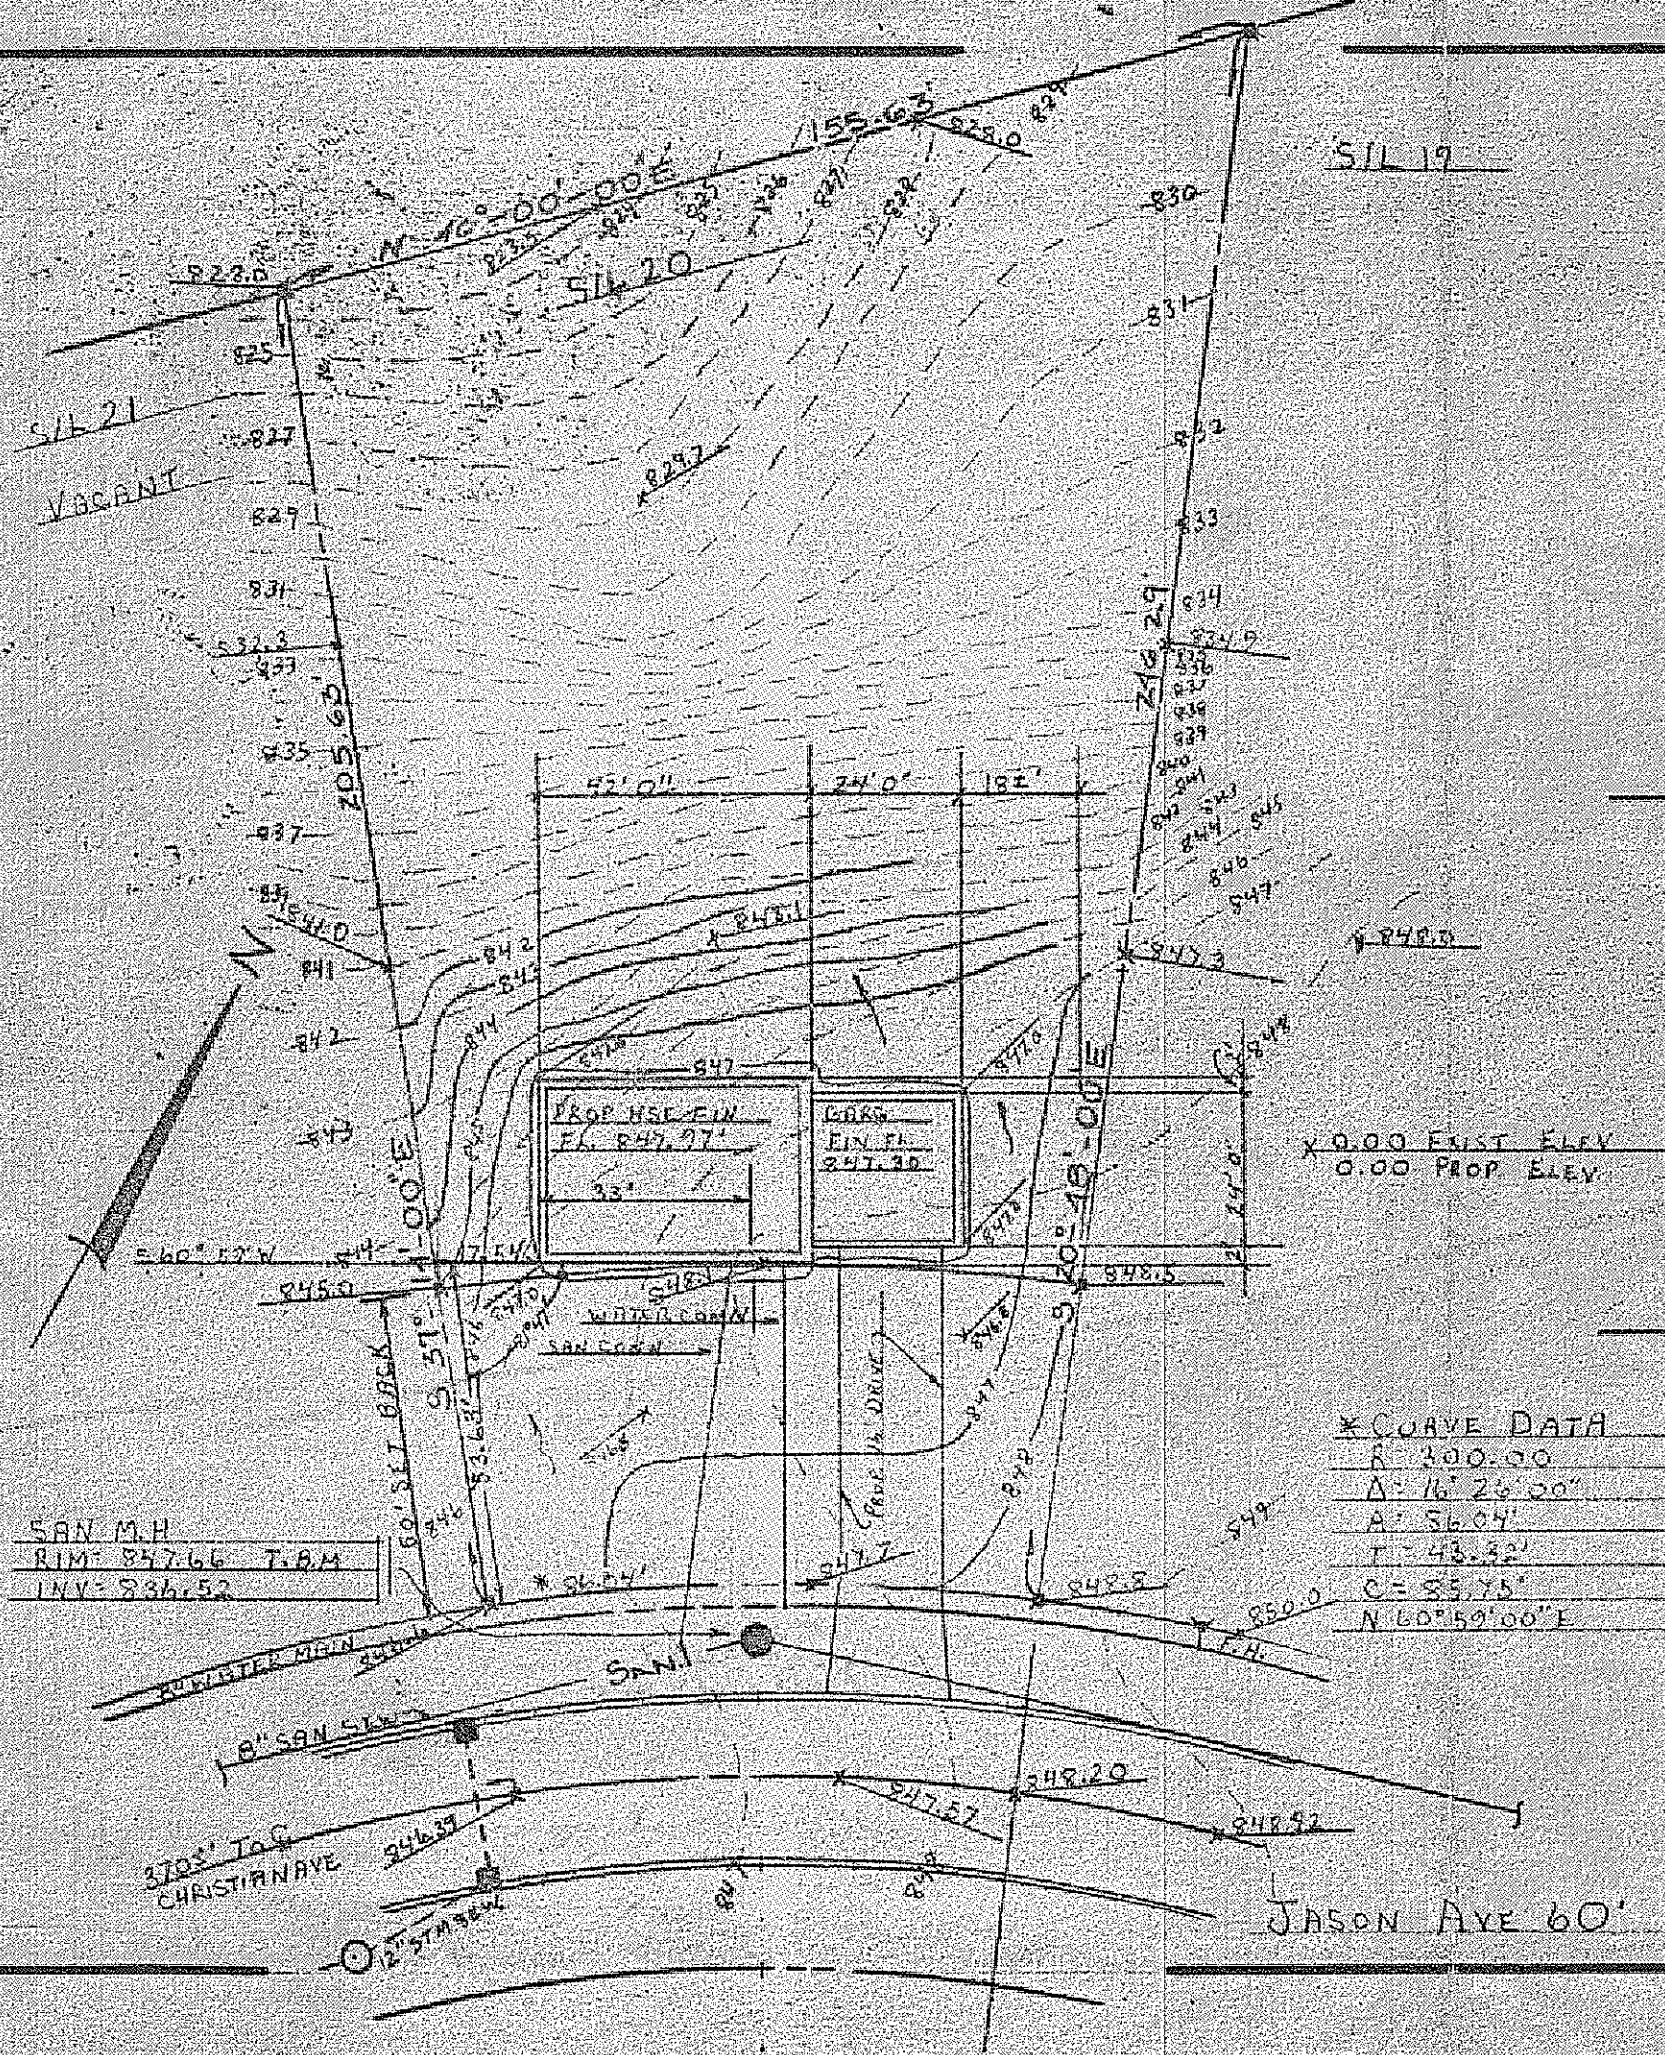

* CURVE DATA	
R	400.00
Δ	16° 24' 00"
A	56.04'
T	43.32'
C	55.75'
N	60° 59' 00" E