


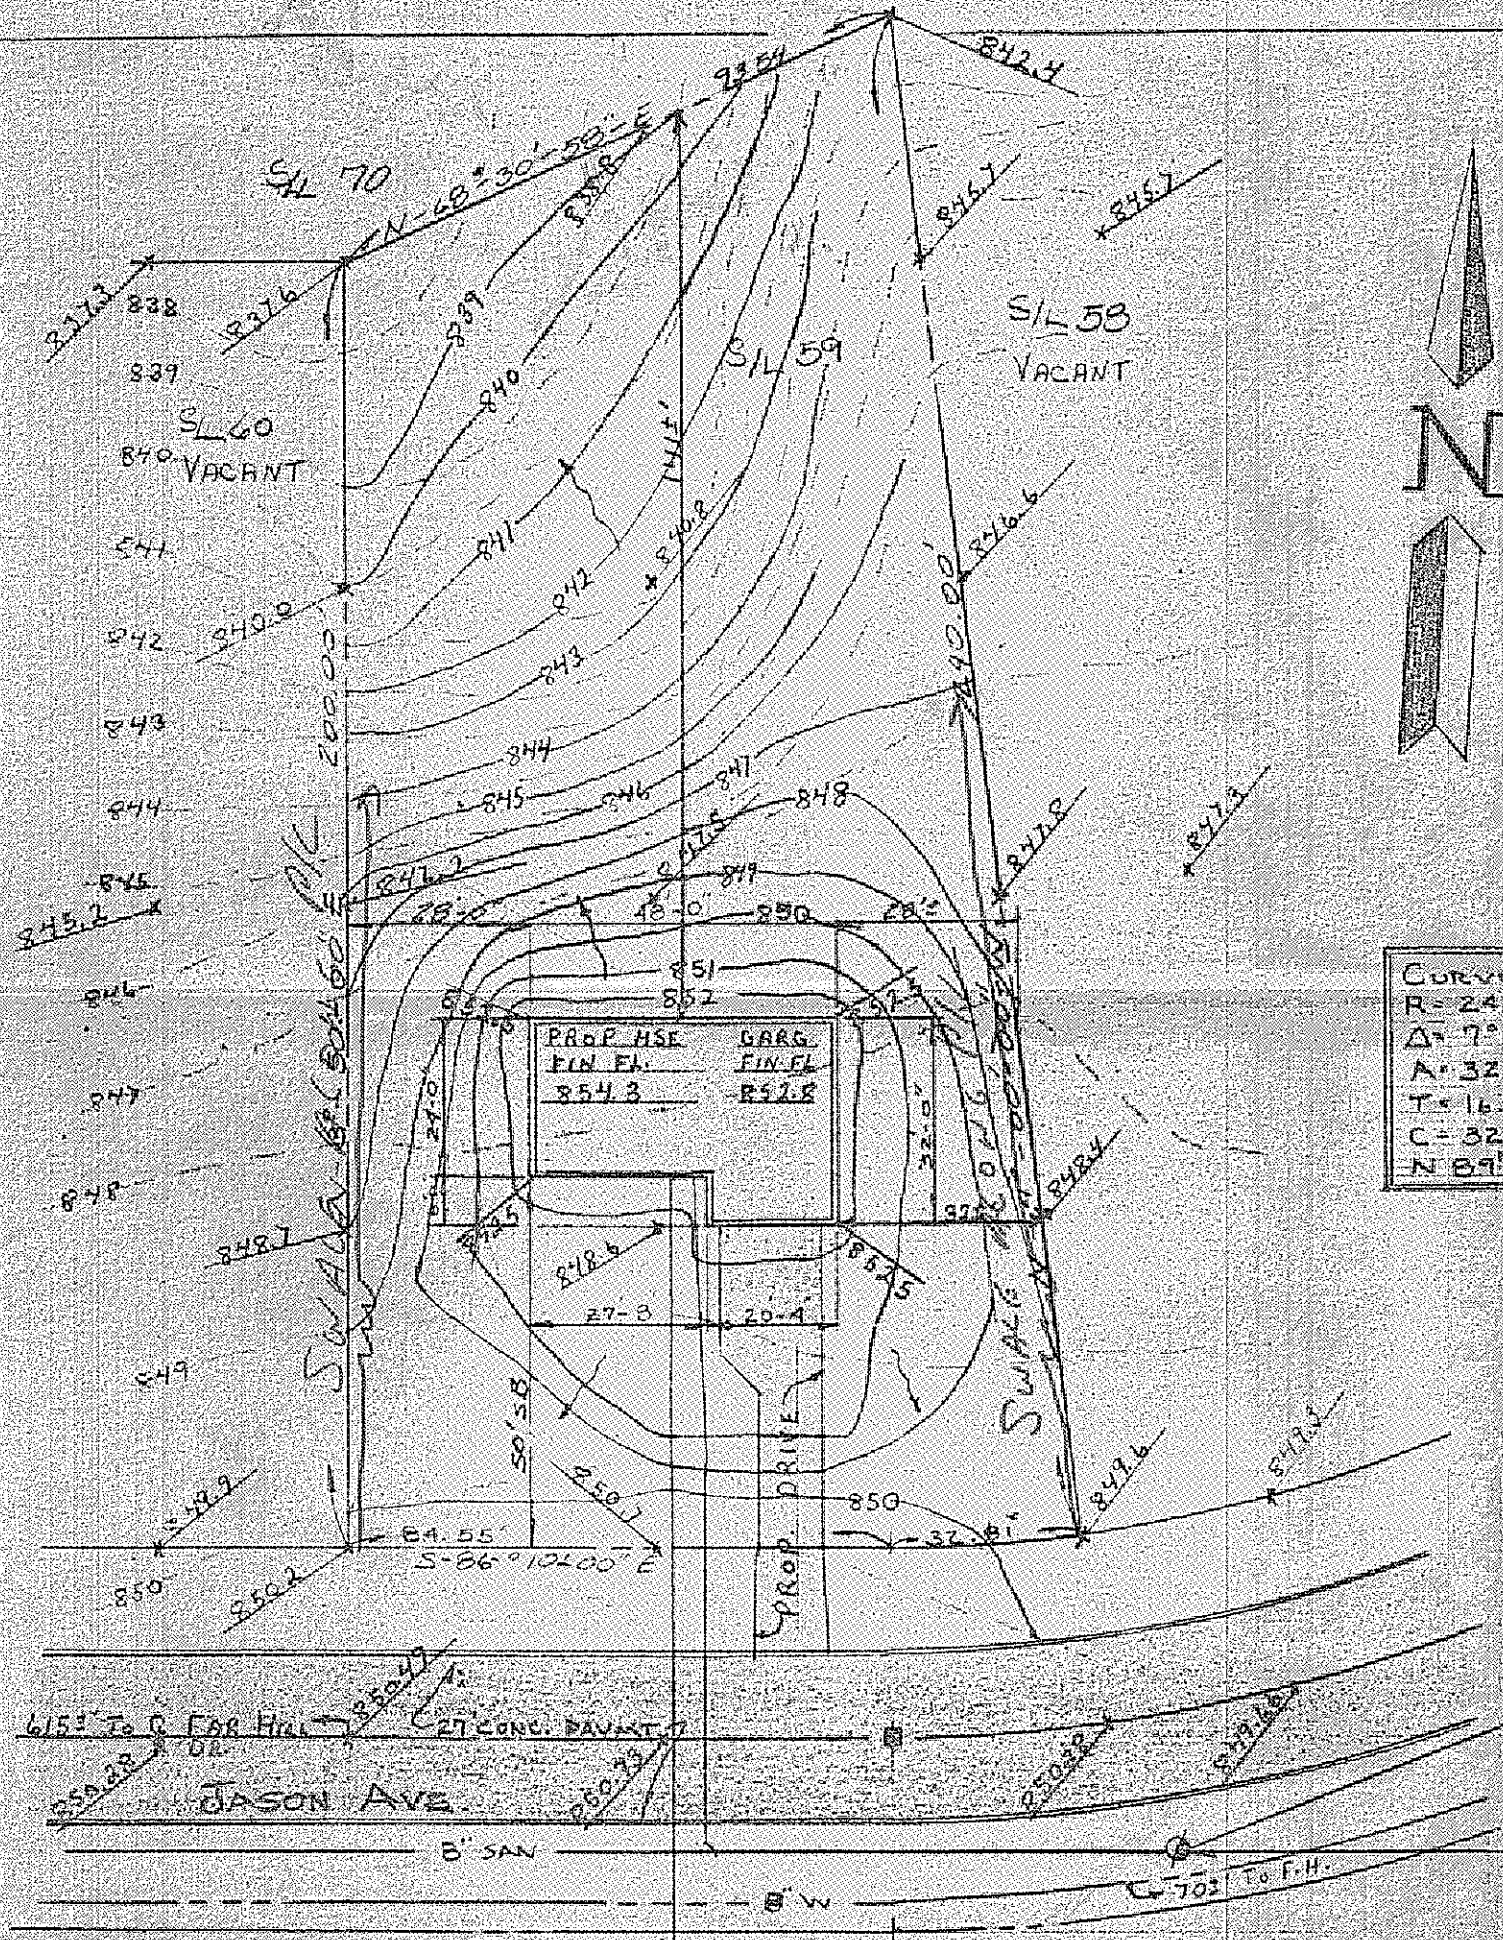

SITE PLAN FOR:

RYAN HOMES

8141 TYLER BLVD

MENTOR, OHIO

BEING SUBLLOT NO. 59 IN
FAR HILLS ESTATE IN CONCORD
TWP., COUNTY OF LAKE, STATE
OF OHIO

Grading Plan Approved
as shown and/or noted
THOMAS P. GILLES, P. E.
Lake County Engineer

PREPARED BY: Wm. R. Gray Date 6/26/78

WM. R. GRAY ASSOC. INC.

7547 MENTOR AVENUE

MENTOR OHIO

SCALE: 1" = 30'

DATE: DEC 19, 1977

CERTIFICATION:

I HEREBY CERTIFY THAT
THIS PLAN IS CORRECT TO THE
BEST OF MY KNOWLEDGE

BY: Wm. R. Gray

WM. R. GRAY REG. SURV. #2752

**ZONING
PERMIT**

SAN MH. NO. 12

RIM = 850.21

INV. = 838.45

Approved 1-16-78

BUNKER HILL