


* CURVE DATA
 R: 300.00'
 Δ = 8° 12' 00"
 A = 42.94'
 T = 21.50'
 C = 42.90'
 N 82° 44' 00" E

0.00 EXIST ELEV.
 0.00 PROP ELEV.

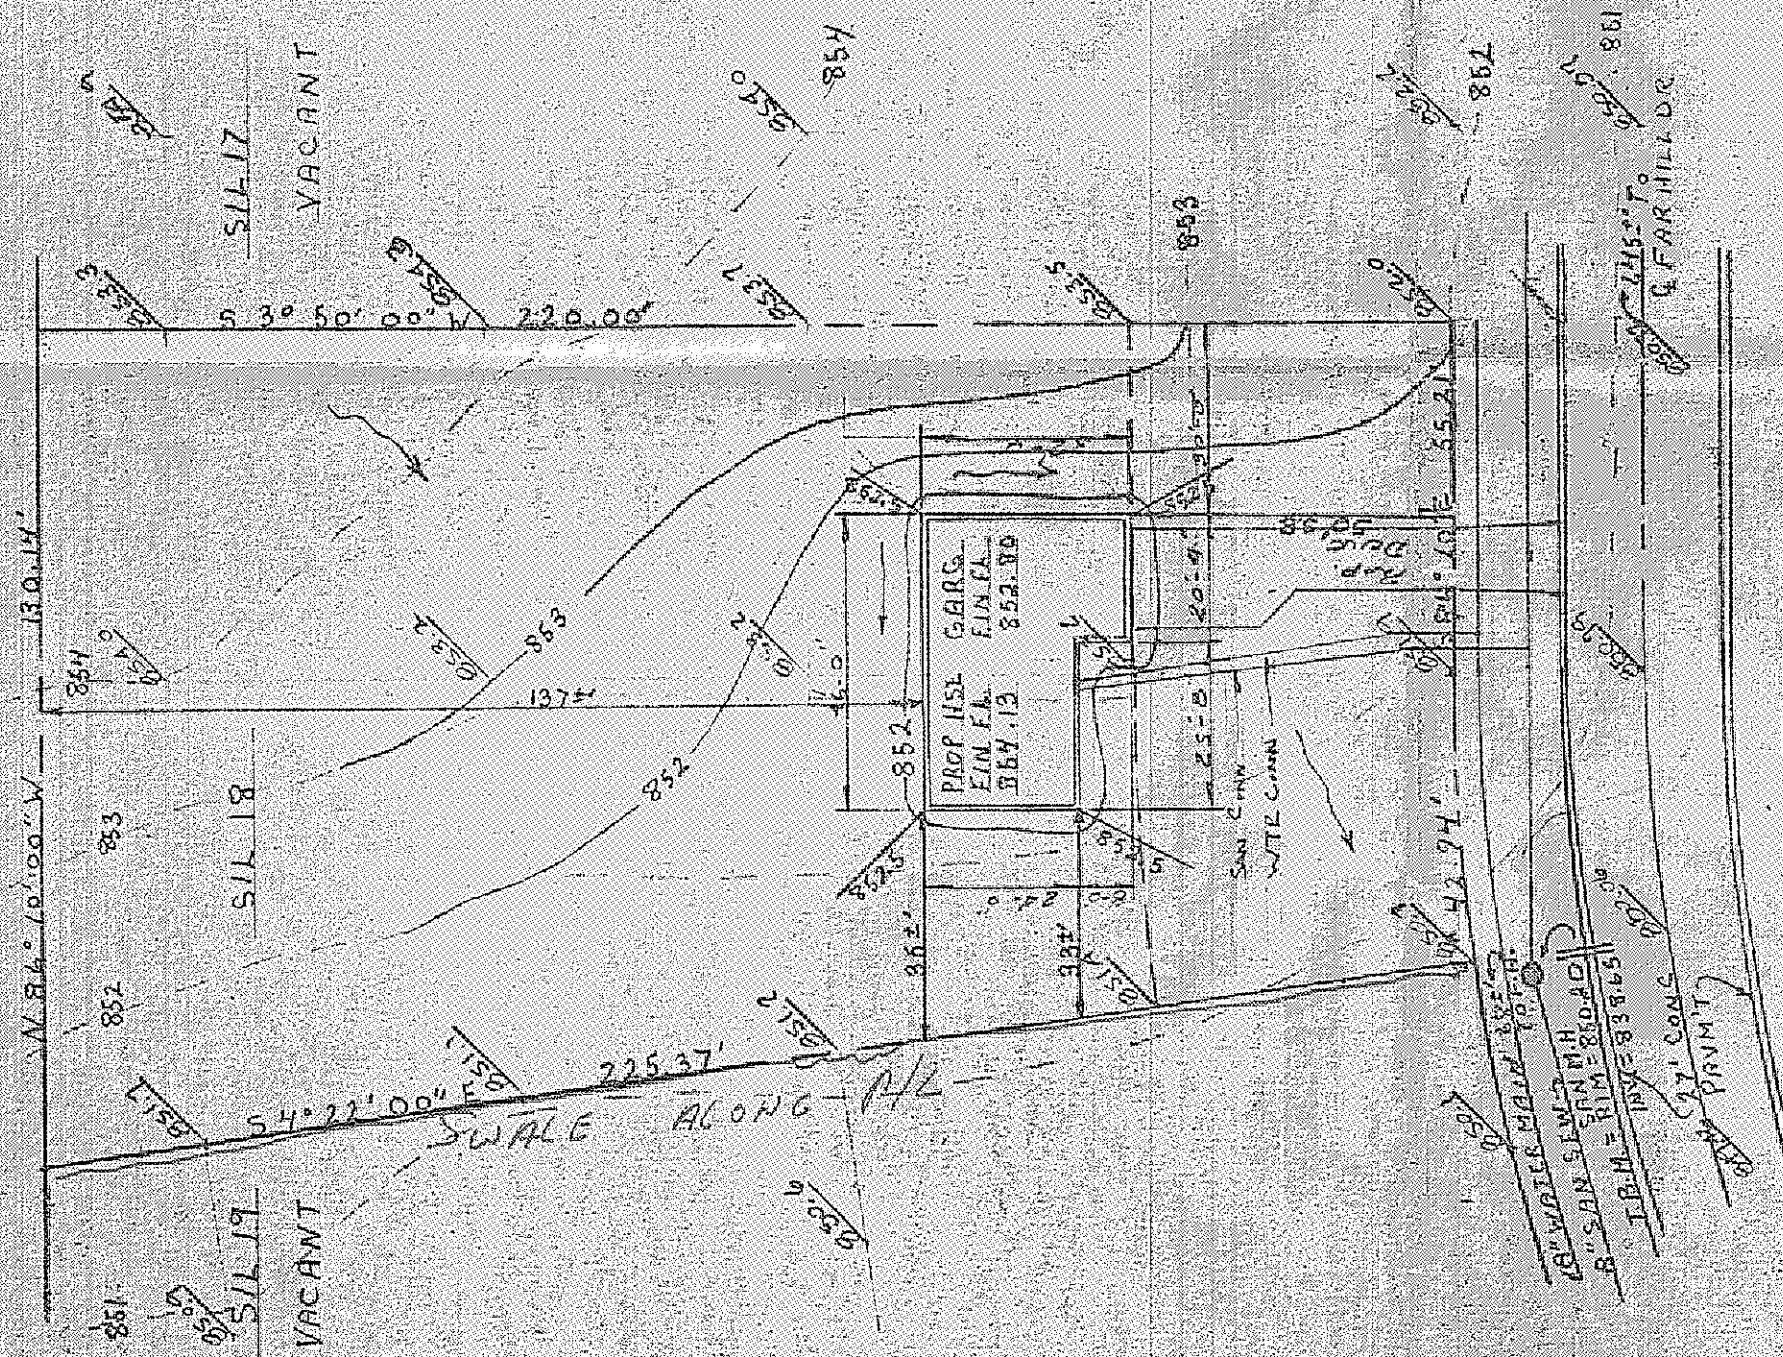

SITE PLAN:

RYAN HOMES
 8141 TYLER BLVD
 MENTOR, OHIO

BEING SUBLT No 18 IN
 FAR HILLS ESTATES SUBDIVISION
 IN CONCORD TWP, OHIO

PREPARED BY:

WM. R. GRAY ASSOC-INC.
 7547 MENTOR AVE
 MENTOR OHIO

SCALE: 1"=30'
 DATE: JAN. 3, 1978

Grading Plan Approved
 as shown and/or noted
 THOMAS P. GILLES, P.E.
 Lake County Engineer
 By 7-20 Date 6-26-78

CERTIFICATION:

I HEREBY CERTIFY THAT THIS
 PLAT IS CORRECT TO THE
 BEST OF MY KNOWLEDGE

BY: Wm R Gray
 WM. R. GRAY REG. SURV. #2752



ZONING
 PERMIT

APPROVED 1-16-78

Wm R Gray