

SITE PLAN FOR
 SILVER AND SON CONST.
 35475 VINE STREET
 EASTLAKE OHIO
 BEING SUBLOT No 10 IN THE ROSEMONT
 TERRACE SUBDIVISION IN CONCORD TWP OHIO

PREPARED BY
 WM. R. GRAY ASSOC. INC.
 CIVIL ENGINEERS SURVEYORS
 7547 MENTOR AVENUE


SCALE: 1" = 30' DATE MARCH, 9 1979



CERTIFICATION
 I HEREBY CERTIFY THAT THIS PLAN
 IS CORRECT TO THE BEST OF MY
 KNOWLEDGE

TERRENCE G. GERSON PROF. ENG.

Grading Plan Approved
 as shown and/or noted
 THOMAS P. GILLES, P.E.
 - 11th County Engineer
 By *Thc* Date *5-1-79*
 24 3902

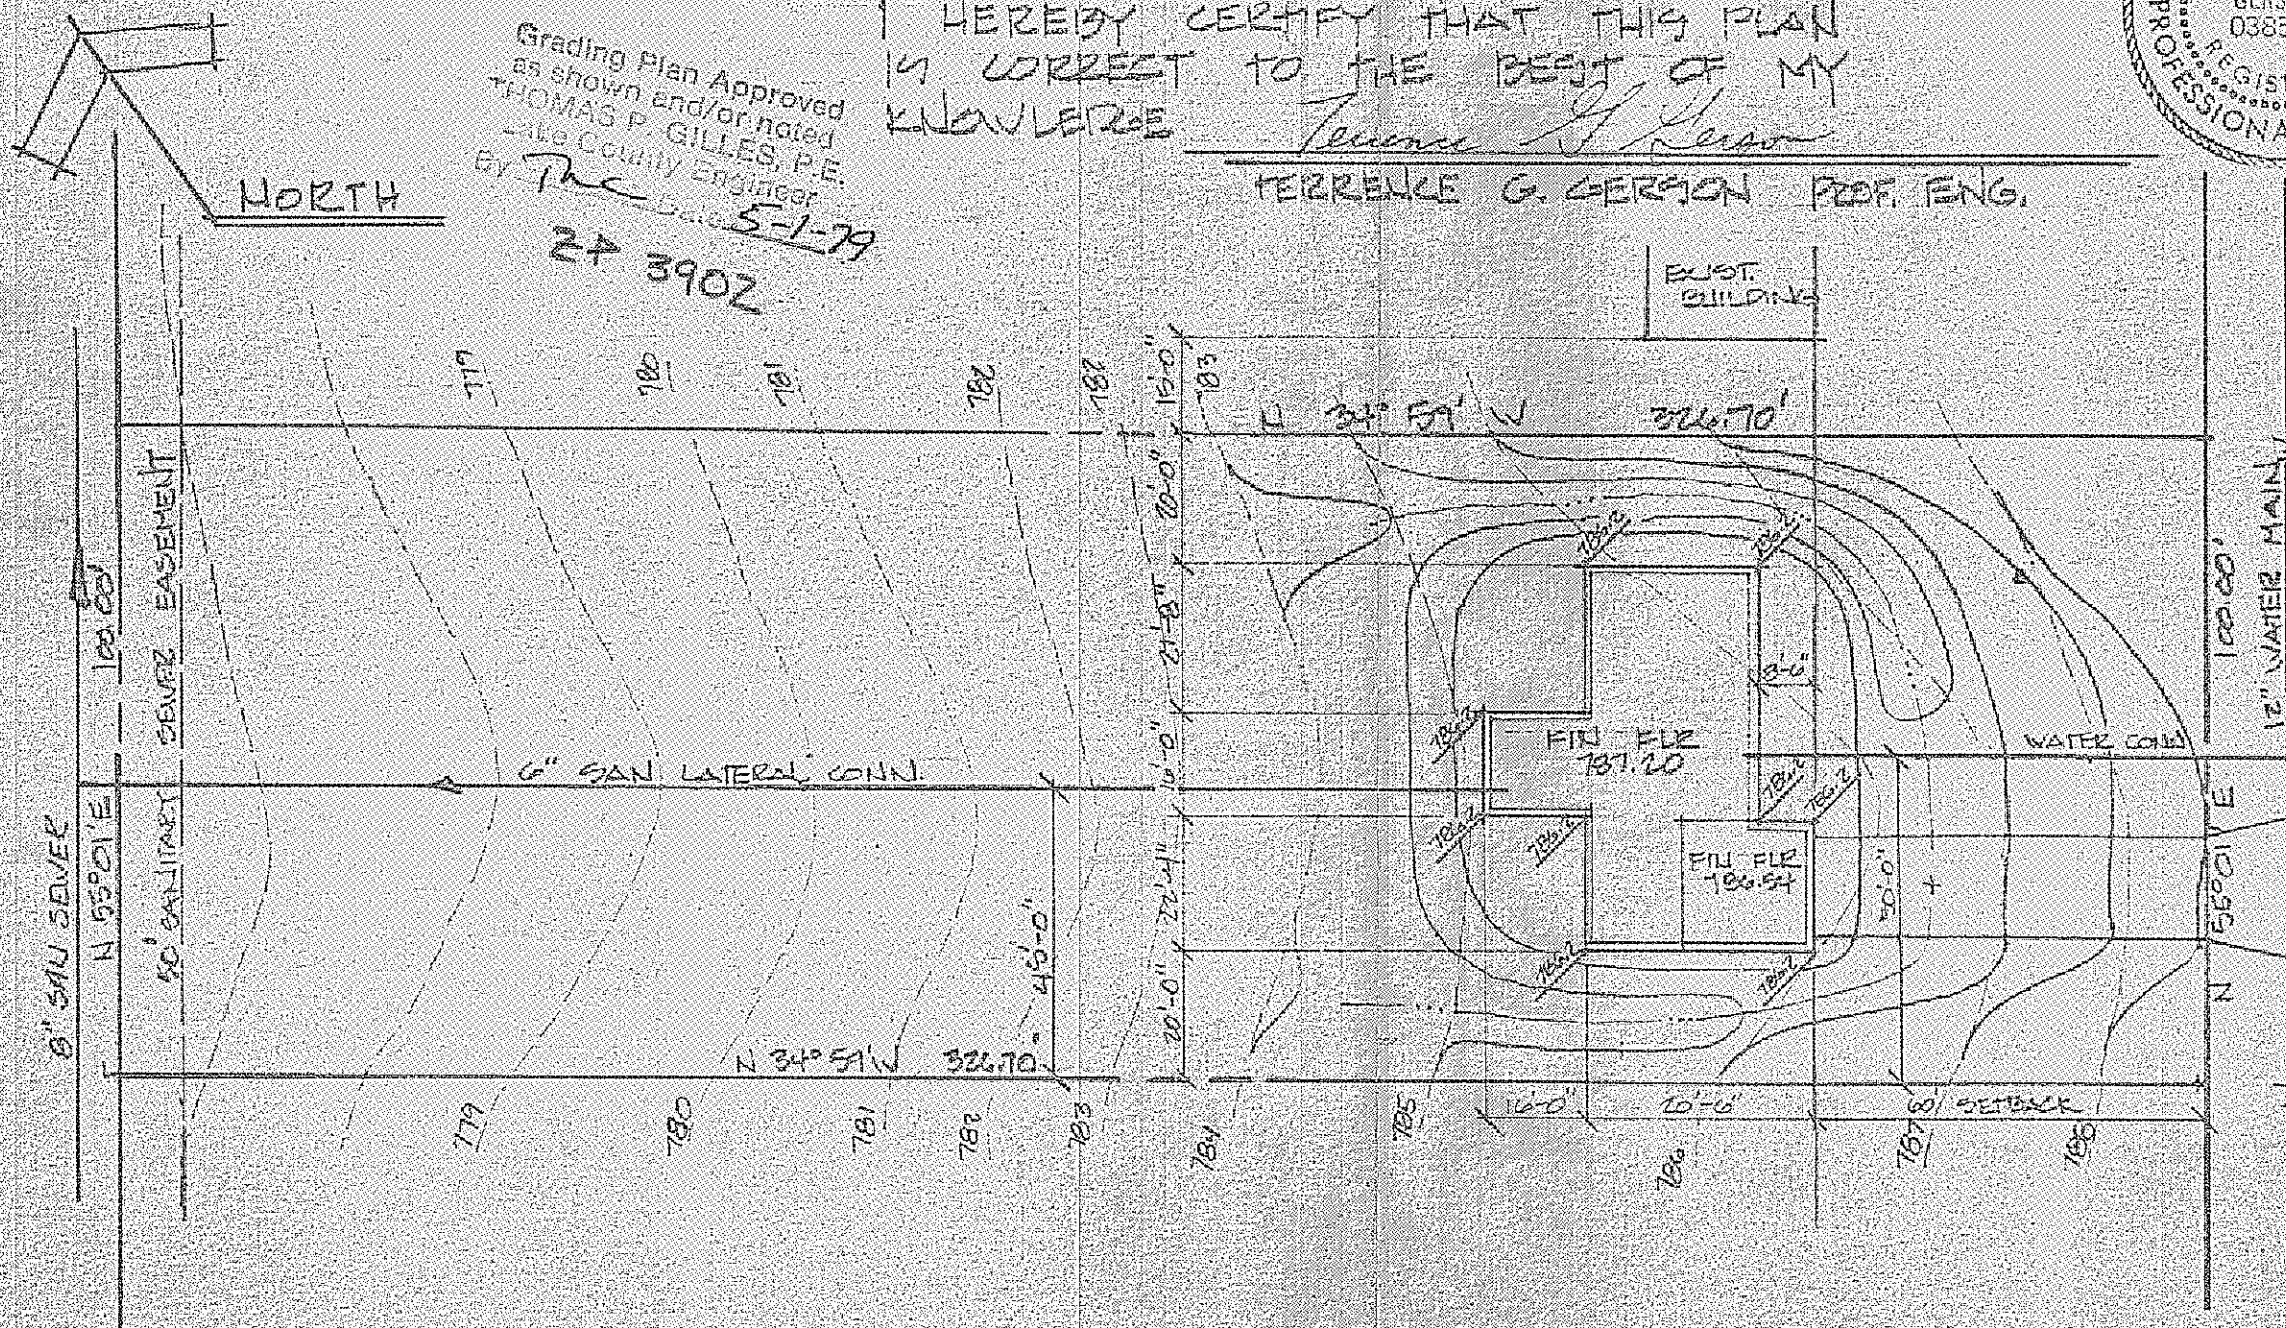

BAXTER ROAD 60'

9839 Johnny Ridge Rd.