


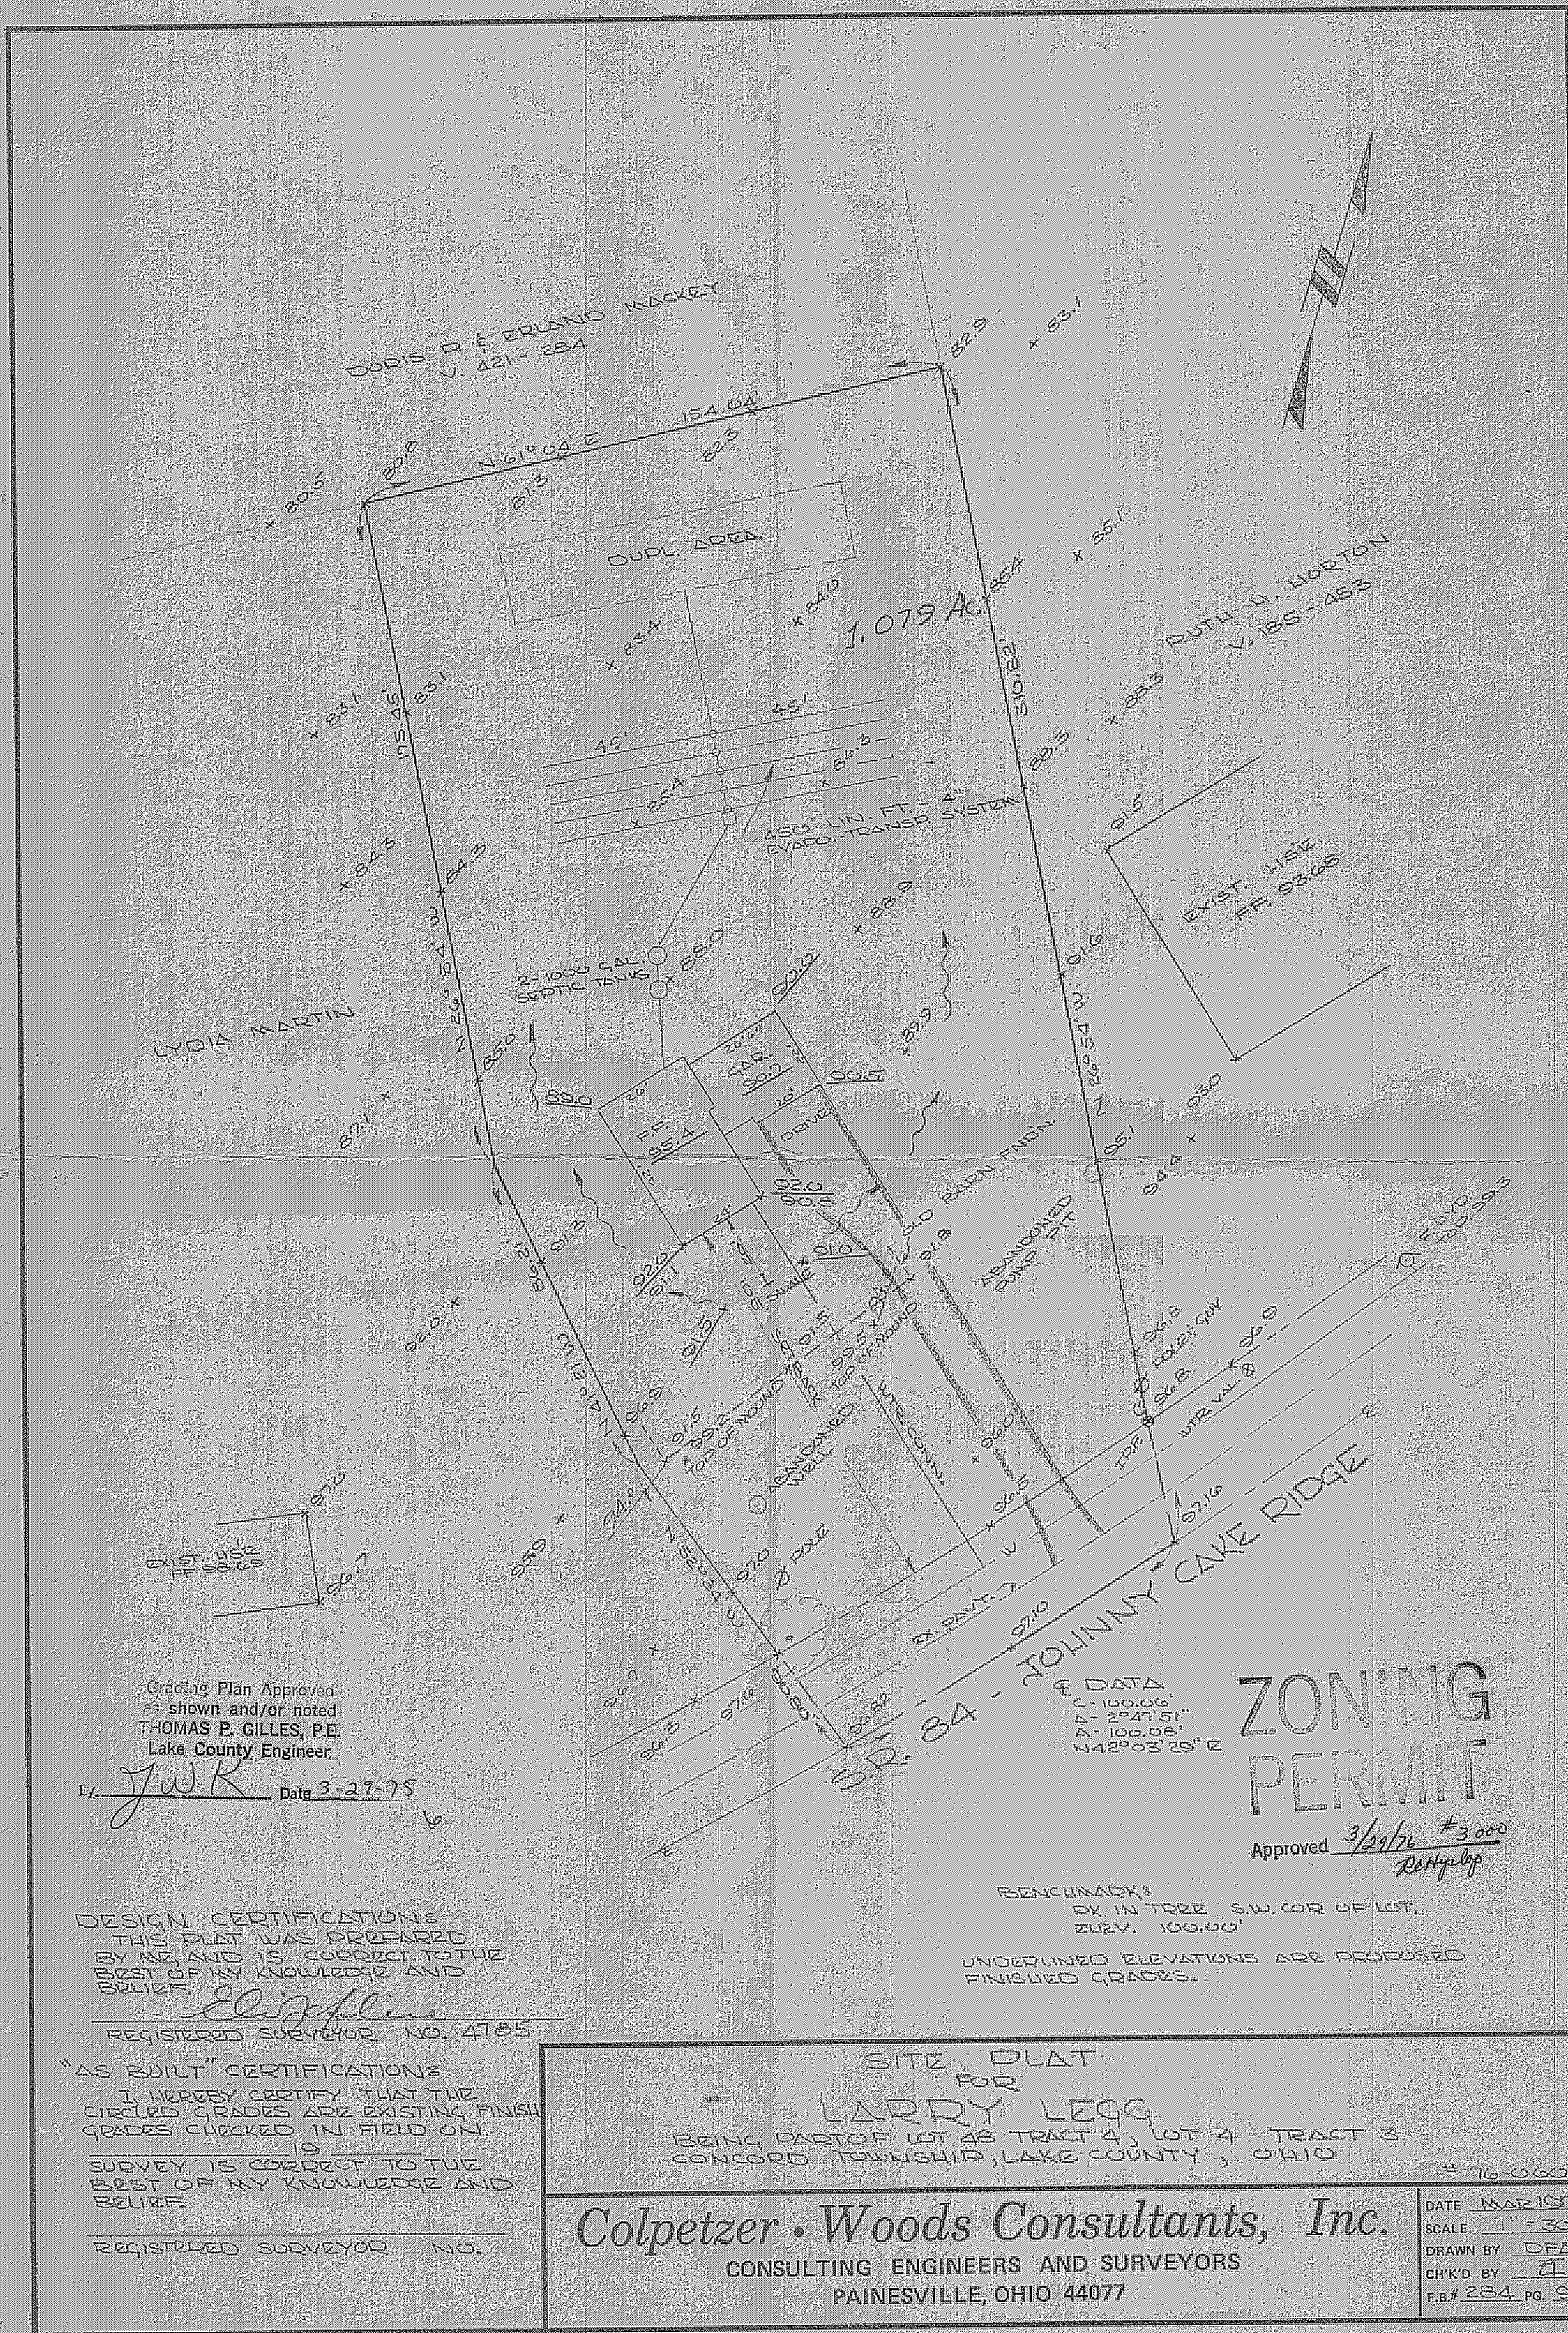

Grading Plan Approved
shown and/or noted
THOMAS P. GILLES, P.E.
Lake County Engineer.
by JWK Date 3-27-75

DESIGN CERTIFICATIONS
THIS PLAT WAS PREPARED
BY ME AND IS CORRECT TO THE
BEST OF MY KNOWLEDGE AND
BELIEF.
Elizbeth
REGISTERED SURVEYOR NO. 4785

"AS BUILT" CERTIFICATIONS
I HEREBY CERTIFY THAT THE
CIRCLED GRADES ARE EXISTING FINISH
GRADES CHECKED IN FIELD ON
19
SURVEY IS CORRECT TO THE
BEST OF MY KNOWLEDGE AND
BELIEF.
REGISTERED SURVEYOR NO.

DATA
C-100.06'
A-2547.51'
A-100.06'
N42°03'29"E

ZONING
PERMIT

Approved 3/29/76 #3000
R.H. Hays

BENCHMARKS
OK IN TREE S.W. COR. OF LOT.
ELEV. 100.00'
UNDERLINED ELEVATIONS ARE PROPOSED
FINISHED GRADES.

SITE PLAT
FOR
LARRY LEGG
BEING PART OF LOT 48 TRACT 4, LOT 4 TRACT 3
CONCORD TOWNSHIP, LAKE COUNTY, OHIO

Colpetzer • Woods Consultants, Inc.
CONSULTING ENGINEERS AND SURVEYORS
PAINESVILLE, OHIO 44077

DATE MAR 1976
SCALE 1" = 30'
DRAWN BY DPA
CHK'D BY JH
T.B.# 284 PG. 92

10709 JOHNNYCAKE Ridge Rd.