


Grading Plan Approved
as shown and/or noted
THOMAS P. GILLES, P.E.
Lake County Engineer

JWK Date 16 May 73

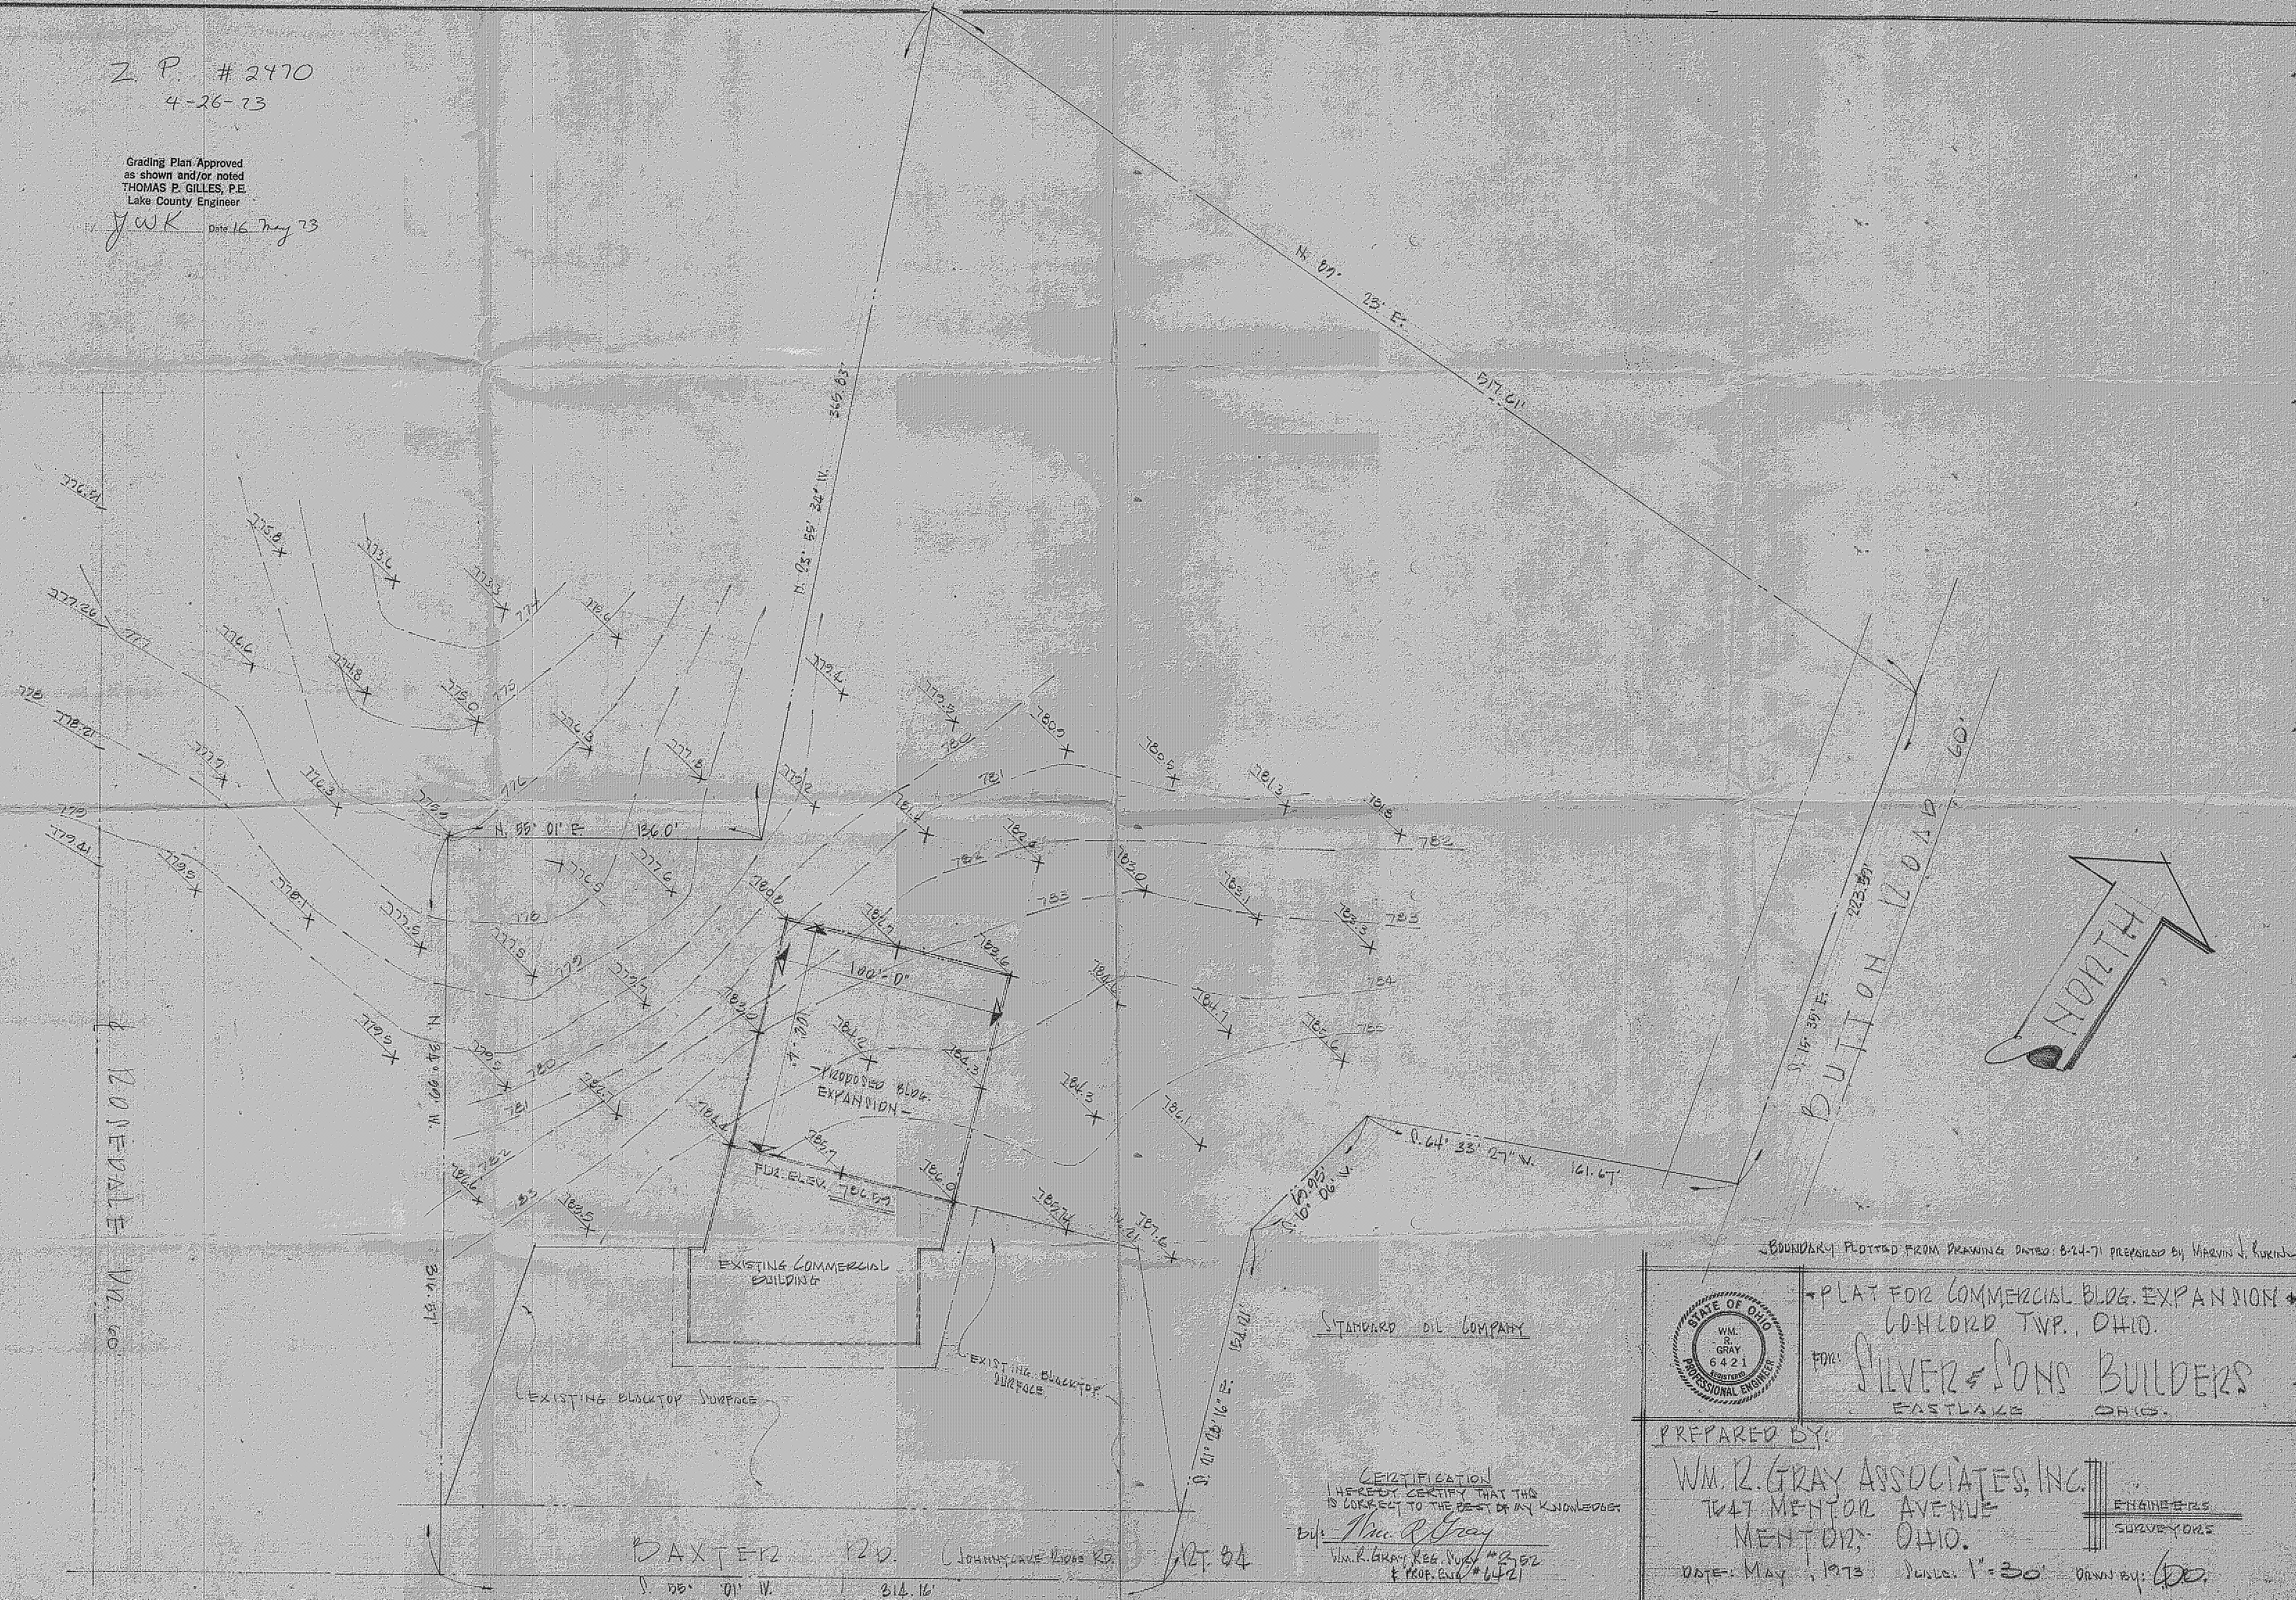

A circular professional engineer seal for the State of Ohio. The outer ring contains the text "STATE OF OHIO" at the top and "PROFESSIONAL ENGINEER" at the bottom. The inner circle contains the name "WM. R. GRAY", the number "6421", and the word "REGISTERED" below it.

• PLAT FOR COMMERCIAL BLDG. EXPANSION •
CONCORD TWP., OHIO.

TIME: SILVER & SONS BUILDERS
EASTLAKE OHIO.

PREPARED BY

WM. R. GRAY ASSOCIATES, INC.
1747 MENTOR AVENUE
MENTOR, OHIO.

ENGINEER'S
SURVEYOR

DATE: MAY 1, 1973 PUNTS: 1" = 30' DRAWN BY: DE