


SAN M.H.  
R/M = 837.30 T.B.M.  
INV = 826.00

Approved 11-9-77  
J.E. van Fleet

# ZONING PERMIT

3478

CURVE DATA  
R = 60.00'  
A = 23.86°  
T = 12.09'  
Δ = 22° 47' 17"  
C = 23.71'  
M 53° 41' 16" W

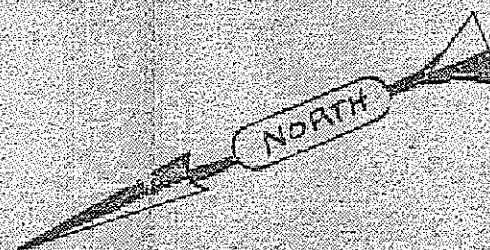

Grading Plan Approved  
as shown and/or noted  
THOMAS P. GILLES, P. E.  
Lake-County Engineer

By Leo Date 1/17/0077

SITE PLAN FOR:

SHANDLE CONSTRUCTION  
8353 MENTOR AVENUE  
MENTOR, OHIO

BEING 6 SUBLOT NO. 145  
IN THE MAPLEY HILLS SUBDIVISION  
3 LOCATED IN CONCORD TWP.  
CONCORD OHIO

PREPARED BY:

177 KVM, A. GRAY ASSOC. INC.  
2547 MENTOR AVENUE  
MENTOR, OHIO

52445

DATE: OCT 31 1977

**CERTIFICATION:**

I HEREBY CERTIFY  
THAT THIS PLAN IS CORRECT  
TO THE BEST OF MY KNOWLEDGE



WM. L. GRAY, JR. - 30400

