

NOTE: ALL IRON PINS SET ARE
5/8" X 30" AND ARE CAPPED
BABCOCK, JONES & ASSOC.

THERE IS NO 100 YEAR FLOOD
ZONE PER LETTER FROM FEMA

● = 3" PEAR TREE W/ LIGHT

CONCORD TWP. ZONING OFFICE

ZONING PER 1204-11988

ISSUED 12/2/04

SUBJECT TO APPROVAL BY:

- ☒ Lake Co. Engineer
- ☒ Lake Co. Zoning Dept.
- ☐ Lake Co. Planning Comm.
- ☒ Lake Co. Building Dept.
- ☒ Lake Co. Soil & Water Cons. Dist.

SITE PLAN

CONCORD TWP., LAKE COUNTY, OHIO

for: CANTERBILT

CLIENT		OWNER	
ADDRESS	STREET	CITY	ZIP
NOBLE RIDGE		TRACT	
SUBDIVISION	NAME	LOT	STREET
1	JAMIE DR.		
SUBLOT NO.	STREET	VOL-PG.	PERM. PARCEL NO.

LEGEND

SANITARY MANHOLE	---	EXIST. ELEV. ± 100.0	PROP. ELEV.
STORM MANHOLE	---	100.0 ± 2	
INLET OR CATCH BASIN	---	AS BUILT ELEVATION	
HYDRANT	---	INDICATES	
EXISTING CONTOURS	---	DIRECTION OF	
PROPOSED CONTOURS	---	SURFACE DRAINAGE	

REMARKS

ALL BOUNDARY DATA SHOWN WAS OBTAINED FROM (DEEDS, RECORDED
SUBDIVISION PLAT OR OTHER PUBLIC RECORDS)

LOCATIONS AS SHOWN OF ADJACENT WELLS AND SEPTIC TANKS OBTAINED FROM
LAKE COUNTY HEALTH DEPARTMENT

DESIGN CERTIFICATION

THIS PLAT WAS PREPARED BY ME, AND IS CORRECT
TO THE BEST OF MY KNOWLEDGE AND BELIEF.

NAME SURVEYOR REGISTRATION NO.

CHECK LIST

NO. OF BEDROOMS	WATER MAIN SIZE, LOCATION
DIMENSIONS	SAN. SEWER SIZE & GR. LOC.
BEARINGS	SAN. MH. CAST. ELEV. INV. ELEV.
TIE TO NEAREST STREET	SAN. CONN. SIZE, LOC. DEPTH
SUBLOT NO. PARCEL NO.	STORM SEWER SIZE & GR. LOC.
SURROUNDING OWNERS	STORM MH. CAST ELEV. INV. ELEV.
BLDG. DIMENSIONS FIN GR.	PAV'T TYPE GRADE CURBS
BLDG. TIES FL'R. GRADES	GAS LINE LOC. SIZE PRESSURE
APRON TYPE WIDTH THICKNESS	SEPTIC TANK LOCATION & DUPLICATION AREA
SEWER TYPE DIA. LENGTH	WELL LOCATION
ROCK OUTCROPPINGS	ISOLATION RADIUS FROM WELL

REVISIONS			PLAN PREPARED BY:		
NO.	DATE	BY	BABCOCK · JONES & ASSOCIATES, INC.		
1	10/18/04	B.P.	PAINESVILLE, OHIO		
2	10/19/04	B.P.			
3	10/27/04	B.P.	DRAWN BY B.C.	SCALE 1"=30'	PHONE NO. 440-387-1811
4	11/8/04	B.P.	CHK'D. H.J.	DATE 9/27/04	DRAWING NO.
5			CREW CHIEF WB	APP'D H.J.	03-233-01

"AS BUILT" CERTIFICATION
I, HEREBY CERTIFY THAT THE CIRCLED GRADES ARE EXISTING
FINISH GRADES CHECKED IN THE FIELD ON 9/27/04, 20
AND ARE CORRECT TO THE BEST OF MY KNOWLEDGE AND BELIEF.


REGISTERED SURVEYOR




REG. NO.

TBM - T.S.F.H.
ELEV - 682.51

CURVE	LENGTH	RADIUS	TANGENT	CHORD	BEARING	DELTA
C1	47.13	30.00	30.01	42.43	S55°19'19"E	90°00'35"

EXISTING UTILITIES NOTE:
THE SIZE AND LOCATION, BOTH HORIZONTAL AND VERTICAL
OF THE UNDERGROUND UTILITIES SHOWN HEREON, HAVE BEEN
OBTAINED BY A SEARCH OF AVAILABLE RECORDS.
VERIFICATION BY FIELD OBSERVATION HAS BEEN CONDUCTED
WHERE PRACTICAL, HOWEVER, BABCOCK, JONES AND ASSOCIATES
INC. DOES NOT GUARANTEE THE COMPLETENESS NOR ACCURACY
THEREOF.

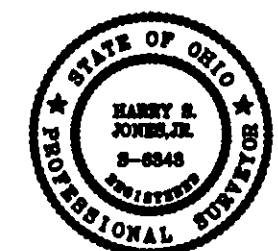

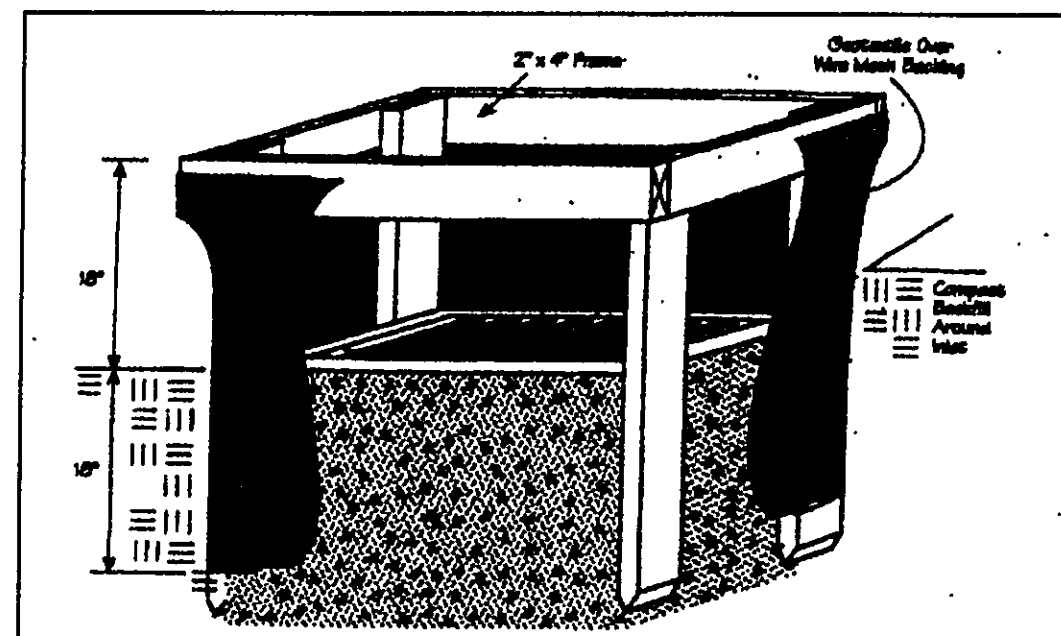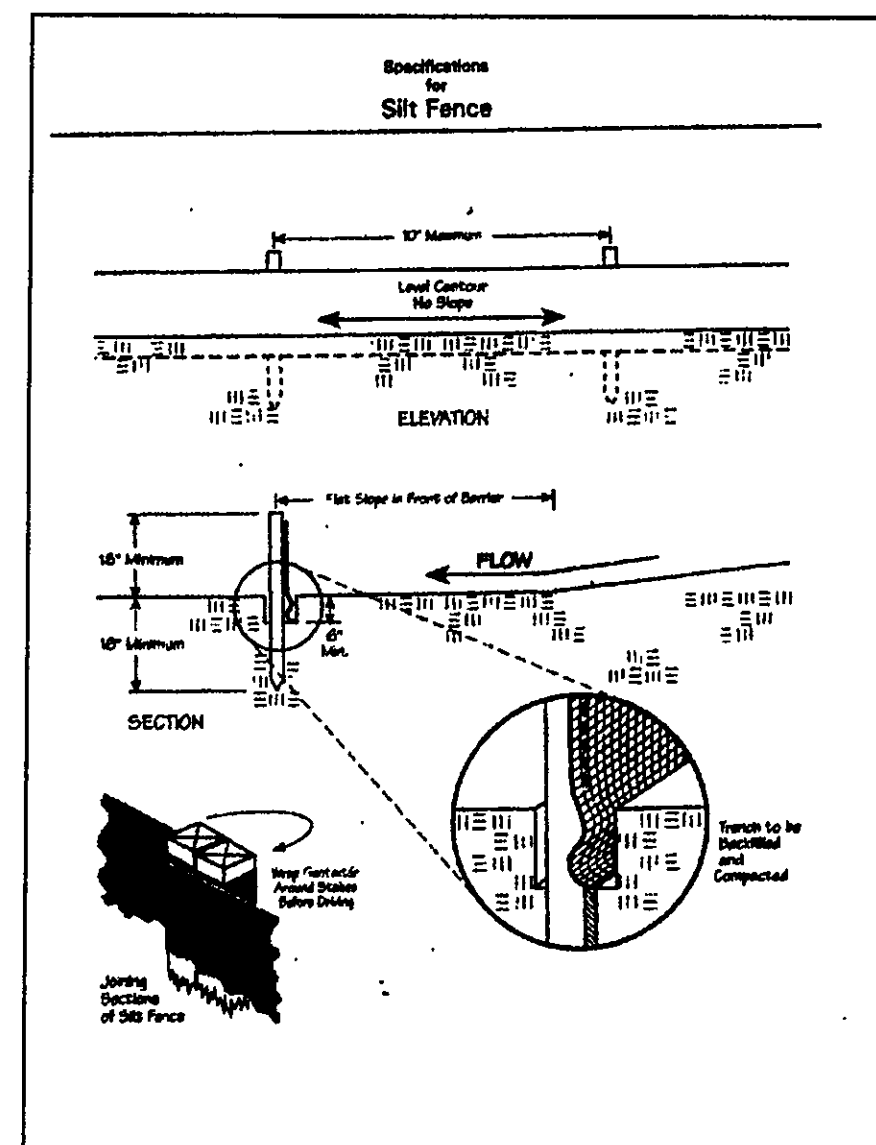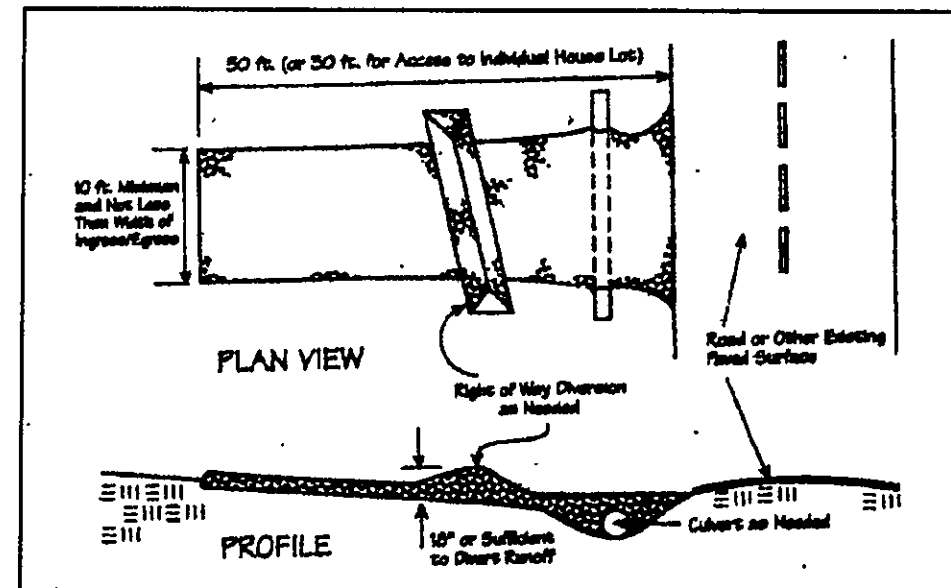

Temporary Seeding Species Selection			
Seeding Dates	Species	Lb./1,000 ft. ²	Per Ac.
March 1 to August 15	Oats	3	4 bushel
	Tall Fescue	1	40 lb.
	Annual Ryegrass	1	40 lb.
	Perennial Ryegrass	1	40 lb.
August 16 to November 1	Tall Fescue	1	40 lb.
	Annual Ryegrass	1	40 lb.
	Wheat	3	2 bushel
	Tall Fescue	1	40 lb.
November 1 to Spring Seeding	Annual Ryegrass	1	40 lb.
	Tall Fescue	1	40 lb.
	Perennial Ryegrass	1	40 lb.
	Wheat	3	2 bushel

Note: Other approved seed species may be substituted.

Erosion and Sediment Control Schedule

Ingress-Egress

A stone access drive complete with under lying geo-textile fabric (20 feet wide and 50 feet long) for ingress and egress at the site shall be installed. This drive shall be the only entrance and exit to the site.

Silt Fence

A silt fence shall be installed prior to any earthwork activities at the site in the locations shown on the site plan as well as along the front of any lot that slopes towards the street.

Temporary Seeding

Disturbed areas of the site that are to remain idle for more than thirty(30) days shall be properly seeded and straw mulched within seven(7) days of completion of initial grading. Temporary seeding and mulching as a thirty(30) foot strip of the entire front of the lot shall be maintained on the site once initial grading is complete.

Stabilization of critical areas within fifty(50) feet of any stream or wetland shall be complete within two(2) days of the disturbance if the site is to remain inactive for longer than fourteen(14) days.

Mulching

Straw-mulch shall be applied at a rate of 1 bale per every ten (10) feet of curb, at a width of thirty(30) feet to the entire length of the lot. Wood chips may also be used but must be spread at a minimum depth of four inches over the thirty-foot width and must be accompanied by a properly installed silt fence.

Maintenance

Erosion and sediment controls shall be inspected every seven(7) days or within 24 hours of a 0.5" or greater rainfall event. Necessary repairs shall be made at this time.

"I, the undersigned hereby certify that this topography indicated by 6", 1', or 2' contours, and elevations shown hereon represent an actual field survey made by me on the 24th day of Sept. 2004 and that the elevations were taken at appropriate intervals and that as of that date they existed as indicated hereon."

Name Harry Jones #6343 Reg. No.

2/2

CORCORAN TOWNSHIP, LAKE COUNTY, OHIO

for: CANTERBILT

CLIENT OWNER
ADDRESS STREET CITY ZIP
SUBDIVISION 45-26 NAME TRACT
LOT 1 STREET TRAVELER LOT 1 STREET
SUBLOT NO. STREET VOL-PG. PERM. PARCEL NO.

LEGEND
SANITARY MANHOLE --- EXIST. ELEV. 100.0 PROP. ELEV. 100.0 ± 2
STORM MANHOLE --- AS BUILT ELEVATION
INLET OR CATCH BASIN --- INDICATES
HYDRANT --- DIRECTION OF
EXISTING CONTOURS --- SURFACE DRAINAGE
PROPOSED CONTOURS ---

REMARKS
ALL BOUNDARY DATA SHOWN WAS OBTAINED FROM (DEEDS, RECORDED SUBDIVISION PLAT OR OTHER PUBLIC RECORDS)
LOCATIONS AS SHOWN OF ADJACENT WELLS AND SEPTIC TANKS OBTAINED FROM LAKE COUNTY HEALTH DEPARTMENT

DESIGN CERTIFICATION
THIS PLAT WAS PREPARED BY ME, AND IS CORRECT TO THE BEST OF MY KNOWLEDGE AND BELIEF.
NAME Harry Jones #6343 SURVEYOR REGISTRATION NO.

CHECK LIST
NO. OF BEDROOMS
DIMENSIONS
SEWERAGE
TIE TO NEAREST STREET
SUBLOT NO. PARCEL NO.
SURROUNDING OWNERS
BLDG. DIMENSIONS FIN OR.
BLDG. TIES PL. R. GRADES
APPROX TYPE WIDTH THICKNESS
SIDEWALK TYPE WIDTH THICKNESS
CULVERT TYPE DIA. LENGTH
ROCK OUTCROPPINGS
WATER MAIN SIZE, LOCATION
SAN. SEWER SIZE & OR. LOC.
SAN. MH. CAST. ELEV. INV. ELEV.
SAN. CONN. SIZE, LOC. DEPTH
STORM SEWER SIZE & OR. LOC.
STORM MH. CAST. ELEV. INV. ELEV.
PAV'T TYPE GRADE CURBS
GAS LINE LOC. SIZE PRESSURE
SEPTIC TANK LOCATION & DUPLICATION AREA
WELL LOCATION
ISOLATION RADIUS FROM WELL

REVISIONS
NO. DATE BY
1
2
3
4
5
PLAN PREPARED BY:
BABCOCK JONES & ASSOCIATES, INC.
PAINESVILLE, OHIO
DRAWN BY BP SCALE --- PHONE NO. 440-357-1811
CHK'D. HT DATE 9/27/04 DRAWING NO. 03-233-1
CREW CHIEF --- APP'D. HT

"AS BUILT" CERTIFICATION
I, HEREBY CERTIFY THAT THE CIRCLED GRADES ARE EXISTING FINISH GRADES CHECKED IN THE FIELD ON 20 AND ARE CORRECT TO THE BEST OF MY KNOWLEDGE AND BELIEF.

REGISTERED SURVEYOR

REG. NO.

EXISTING UTILITIES NOTE:
THE SIZE AND LOCATION, BOTH HORIZONTAL AND VERTICAL OF THE UNDERGROUND UTILITIES SHOWN HEREON, HAVE BEEN OBTAINED BY A SEARCH OF AVAILABLE RECORDS. VERIFICATION BY FIELD OBSERVATION HAS BEEN CONDUCTED WHERE PRACTICAL, HOWEVER, BABCOCK, JONES AND ASSOCIATES INC. DOES NOT GUARANTEE THE COMPLETENESS NOR ACCURACY THEREOF.

