

7-10-66
M. R. Smith
M. R. Smith

SEP 22

for: John K. KENNEDY - Renovation of 2nd floor
CLIENT OWNER


2887 Reeves Road Wrentham, Ohio
ADDRESS STREET CITY ZIP

DEPT. NO.	8	PAR. NO.	4
SUBDIVISION		LOT	
VOLUME	21	STREET	9835 JANDYBACE PIKE

PERMANENT PARCEL NO.

THIS PLAT WAS PREPARED BY ME,
AND IS CORRECT TO THE BEST OF
MY KNOWLEDGE.

1. REFERENCE DESIGN	2. NAME	3. REGISTRATION NO.
		ES 6662

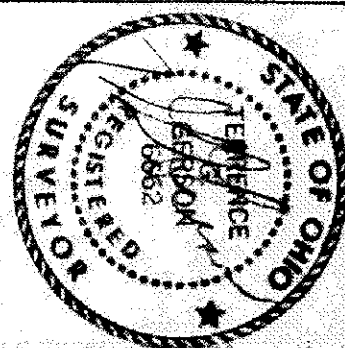

SANITARY	MANHOLE	WATER VALVE (GAS)
STORM	MANHOLE	WATER METER (GAS)
INLET OR CATCH BASIN		AS BUILT ELEVATION
HYDRANT		
EXISTING CONTOURS		
PROPOSED CONTOURS		
EXIST. ELEV.	100.00	
	100.00	
	100.00	
	PROP. ELEV.	

INDICATES DIRECTION OF SURFACE DRAINAGE

SANITARY	MANHOLE	WATER VALVE (GAS)
STORM	MANHOLE	WATER METER (GAS)
INLET OR CATCH BASIN		AS BUILT ELEVATION
HYDRANT		
EXISTING CONTOURS		
PROPOSED CONTOURS		
EXIST. ELEV.	100.00	
	100.00	
	100.00	
	PROP. ELEV.	

INDICATES DIRECTION OF SURFACE DRAINAGE

I, HEREBY CERTIFY THAT THE CIRCLED GRADES ARE
EXISTING FINISHED GRADES CHECKED IN THE FIELD ON
_____, 19____, AND ARE CORRECT TO THE
BEST OF MY KNOWLEDGE.

[illegible]

REVISIONS	DRAWN BY 44	SCALE 1" = 30'	PHONE NO. 446 1616
	CHECKED BY	DATE 16 SEPT 88	DRAWING NO.

NOTE: No BOUNDARY SURVEY PERFORMED