

CONCORD TOWNSHIP ZONING OFFICE  
Zoning Permit # 0906-12913  
Date Issued 9/26/06  
Subject to Approval By:  
☒ Lake Co. Engineer/Storm Water Mgmt.  
☒ Lake Co. Utilities Dept.  
☒ Lake Co. Soil + Water District  
☒ Lake Co. Health District  
☒ Lake Co. Building Dept.

Sanitary Management Plan  
App. checked shown and/or noted  
LANCE R. GILLS, P.E.  
County Drainage Engineer  
By L.S. Date 9/29/06

## SITE PLAN

CONCORD TOWNSHIP, LAKE COUNTY, OHIO

for: PRO BUILT HOMES

CLIENT OWNER ADDRESS STREET CITY ZIP

QUAIL HOLLOW #8  
SUBDIVISION 43-1 NAME TRACT STREET  
241 VOL-PG. LOT  
SUBLOT NO. JUMPERS CROSSING LANE  
STREET VOL-PG. PERM. PARCEL NO.

### LEGEND

SANITARY MANHOLE --- --- EXIST. ELEV. --- 100.0 --- PROP. ELEV.  
STORM MANHOLE --- --- AS BUILT ELEVATION  
INLET OR CATCH BASIN --- --- INDICATES  
HYDRANT --- --- DIRECTION OF  
EXISTING CONTOURS --- --- SURFACE DRAINAGE  
PROPOSED CONTOURS ---

### REMARKS

ALL BOUNDARY DATA SHOWN WAS OBTAINED FROM (DEEDS, RECORDED  
SUBDIVISION PLAT OR OTHER PUBLIC RECORDS)  
LOCATIONS AS SHOWN OF ADJACENT WELLS AND SEPTIC TANKS OBTAINED FROM  
LAKE COUNTY HEALTH DEPARTMENT

### DESIGN CERTIFICATION

THIS PLAT WAS PREPARED BY ME, AND IS CORRECT  
TO THE BEST OF MY KNOWLEDGE AND BELIEF.

NAME Harry S. Jones SURVEYOR REGISTRATION NO. 46313

### CHECK LIST

NO. OF BEDROOMS	WATER MAIN SIZE, LOCATION
DIMENSIONS	SAN. SEWER SIZE & OR. LOC.
BEARINGS	SAN. MH. CAST. ELEV. INV. ELEV.
TIE TO NEAREST STREET	SAN. CONN. SIZE, LOC. DEPTH
SUBLOT NO. PARCEL NO.	STORM SEWER SIZE & OR. LOC.
SURROUNDING OWNERS	STORM MH. CAST. ELEV. INV. ELEV.
BLDG. DIMENSIONS FIN OR.	PAY'T TYPE GRADE CURBS
BLDG. TIES FL'T. GRADES	GAS LINE LOC. SIZE PRESSURE
APRON TYPE WIDTH THICKNESS	SEPTIC TANK LOCATION & DUPLICATION AREA
SIDEWALK TYPE WIDTH THICKNESS	WELL LOCATION
CULVERT TYPE DIA., LENGTH	ISOLATION RADIUS FROM WELL
ROCK OUTCROPPINGS	


REVISIONS			PLAN PREPARED BY:		
NO.	DATE	BY	BABCOCK - JONES & ASSOCIATES, INC.		
1	9/21/06	B.P.	PAINESVILLE, OHIO		
2			DRAWN BY	N.S.	SCALE 1"=30'
3			CHK'D.	H.J.	DATE 9/19/06
4			CHEW	E.W.H.	APP'D H.J.
5					PHONE NO. 440-357-1811
					DRAWING NO. 02-230-241




"AS BUILT" CERTIFICATION  
I, HEREBY CERTIFY THAT THE CIRCLED GRADES ARE EXISTING  
FINISH GRADES CHECKED IN THE FIELD ON 9/26/06, 2006  
AND ARE CORRECT TO THE BEST OF MY KNOWLEDGE AND BELIEF.

REGISTERED SURVEYOR REG. NO.

BM IRON PIN MONUMENT  
ELEV.-913.77

EXISTING UTILITIES NOTE:  
THE SIZE AND LOCATION, BOTH HORIZONTAL AND VERTICAL  
OF THE UNDERGROUND UTILITIES SHOWN HEREON, HAVE BEEN  
OBTAINED BY A SEARCH OF AVAILABLE RECORDS.  
VERIFICATION BY FIELD OBSERVATION HAS BEEN CONDUCTED  
WHERE PRACTICAL, HOWEVER, BABCOCK, JONES AND ASSOCIATES  
INC. DOES NOT GUARANTEE THE COMPLETENESS NOR ACCURACY  
THEREOF.

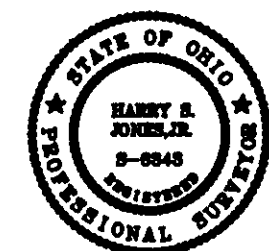

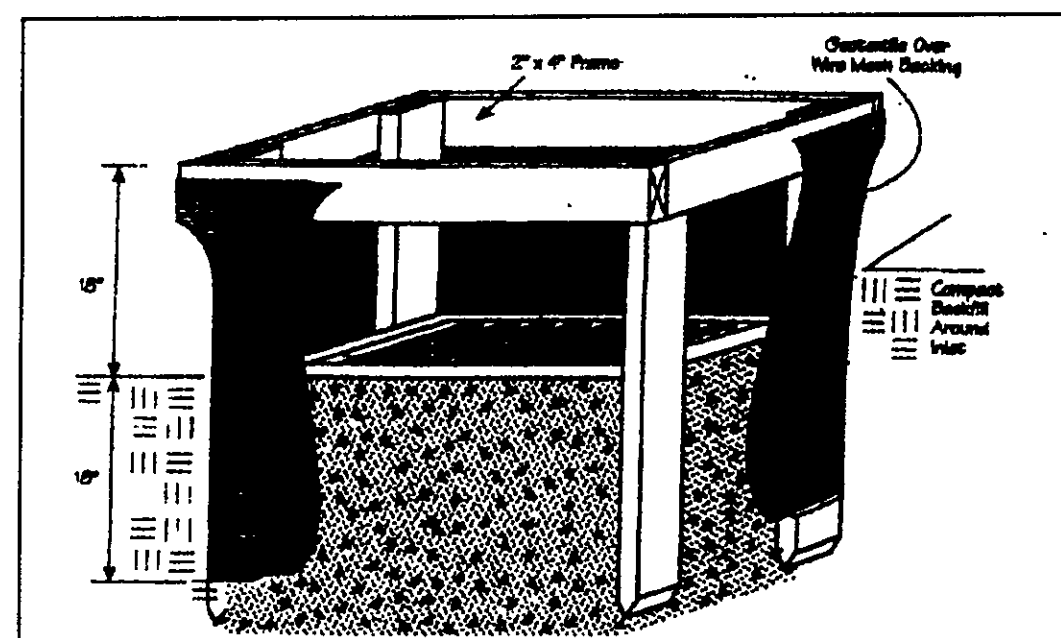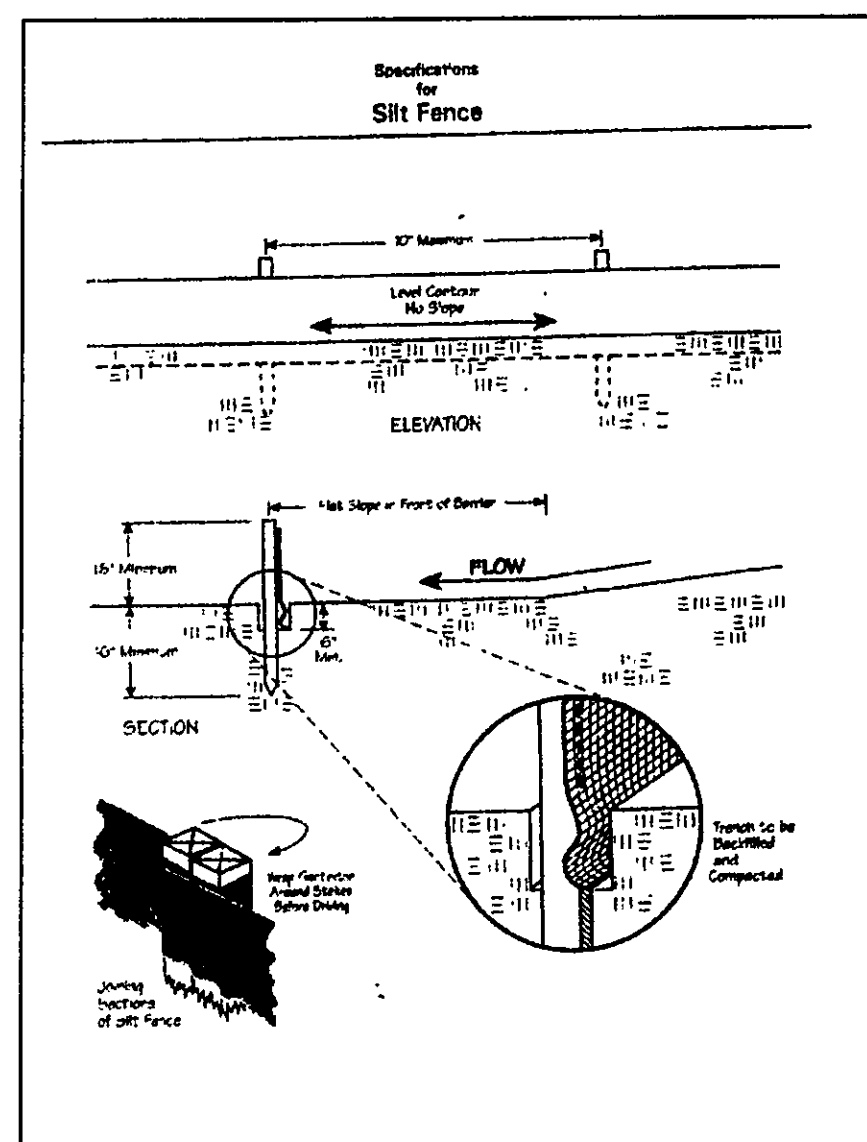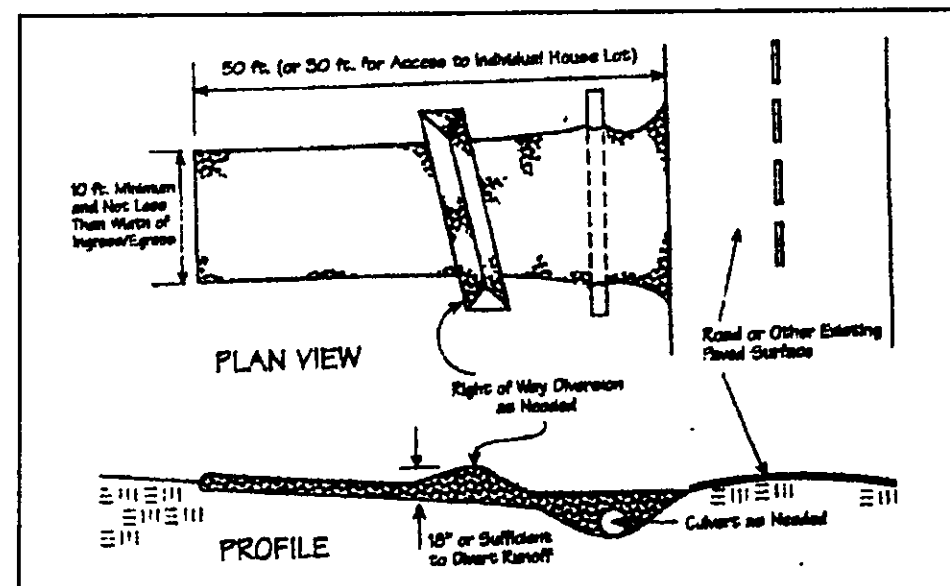

Temporary Seeding Species Selection			
Seeding Dates	Species	Lb./1,000 ft. <sup>2</sup>	Per Ac.
March 1 to August 15	Oats	3	4 bushel
	Tall Fescue	1	40 lb.
	Annual Ryegrass	1	40 lb.
August 16 to November 1	Perennial Ryegrass	1	40 lb.
	Tall Fescue	1	40 lb.
	Annual Ryegrass	1	40 lb.
November 1 to Spring Seeding	Rye	3	2 bushel
	Tall Fescue	1	40 lb.
	Annual Ryegrass	1	40 lb.
November 1 to Spring Seeding	Wheat	3	2 bushel
	Tall Fescue	1	40 lb.
	Annual Ryegrass	1	40 lb.
Use mulch only, sodding practices or dormant seeding.			

Note: Other approved seed species may be substituted.

#### Erosion and Sediment Control Schedule

##### Ingress-Egress

A stone access drive complete with under lying geo-textile fabric (20 feet wide and 50 feet long) for ingress and egress at the site shall be installed. This drive shall be the only entrance and exit to the site.

##### Silt Fence

A silt fence shall be installed prior to any earthwork activities at the site in the locations shown on the site plan as well as along the front of any lot that slopes towards the street.

##### Temporary Seeding

Disturbed areas of the site that are to remain idle for more than twenty one(21) days shall be properly seeded and straw mulched within seven(7) days of completion of initial grading. Temporary seeding and mulching as a thirty(30) foot strip of the entire front of the lot shall be maintained on the site once initial grading is complete.

Stabilization of critical areas within fifty(50) feet of any stream or wetland shall be complete within two(2) days of the disturbance if the site is to remain inactive for longer than fourteen(14) days.

##### Mulching

Straw-mulch shall be applied at a rate of 1 bale per every ten (10) feet of curb, at a width of thirty(30) feet to the entire length of the lot. Wood chips may also be used but must be spread at a minimum depth of four inches over the thirty-foot width and must be accompanied by a properly installed silt fence.

##### Maintenance

Erosion and sediment controls shall be inspected every seven(7) days or within 24 hours of a 0.5" or greater rainfall event. Necessary repairs shall be made at this time.

"I, the undersigned hereby certify that this topography indicated by 6", 1', or 2' contours, and elevations shown hereon represent an actual field survey made by me on the 13th day of Sept, 2006 and that the elevations were taken at appropriate intervals and that as of that date they existed as indicated hereon."

Name Harry Jones #6343 Reg. No.

2/2

CONCORD TOWNSHIP, LAKE COUNTY, OHIO

for: PRO BUILT HOMES

CLIENT OWNER  
ADDRESS STREET CITY ZIP  
SUBDIVISION 43-1 NAME TRACT STREET  
241 VOL-PA JUMPERS C/O 33-25 LOT  
SUBLOT NO. STREET VOL-PA PERM. PARCEL NO.

LEGEND  
SANITARY MANHOLE --- 1 ---  
STORM MANHOLE --- 2 ---  
INLET OR CATCH BASIN --- 3 ---  
HYDRANT --- 4 ---  
EXISTING CONTOURS --- 5 ---  
PROPOSED CONTOURS --- 6 ---  
EAST. ELEV. 5210.00 PROP. ELEV. 1000 ± 2  
AS BUILT ELEVATION  
INDICATES DIRECTION OF SURFACE DRAINAGE

REMARKS  
ALL BOUNDARY DATA SHOWN WAS OBTAINED FROM (DEEDS, RECORDED SUBDIVISION PLAT OR OTHER PUBLIC RECORDS)  
LOCATIONS AS SHOWN OF ADJACENT WELLS AND SEPTIC TANKS OBTAINED FROM LAKE COUNTY HEALTH DEPARTMENT

DESIGN CERTIFICATION  
THIS PLAT WAS PREPARED BY ME, AND IS CORRECT TO THE BEST OF MY KNOWLEDGE AND BELIEF.  
NAME Harry Jones REGISTRATION NO. 6343

CHECK LIST  
NO. OF BEDROOMS  
DIMENSIONS  
BEARINGS  
TIE TO NEAREST STREET  
SUBLOT NO. PARCEL NO.  
SURROUNDING OWNERS  
BLDG. DIMENSIONS FIN OR.  
BLDG. TIES PL'G. GRADES  
APRON TYPE WIDTH THICKNESS  
SIDEWALK TYPE WIDTH THICKNESS  
CULVERT TYPE DIA. LENGTH  
ROCK OUTCROPPINGS  
WATER MAIN SIZE, LOCATION  
SAN. SEWER SIZE & OR. LOC.  
SAN. MAN. CAST. ELEV. INV. ELEV.  
SAN. CONN. SIZE, LOC. DEPTH  
STORM SEWER SIZE & OR. LOC.  
STORM MAN. CAST. ELEV. INV. ELEV.  
PAV'T TYPE GRADE CURBS  
GAS LINE LOC. SIZE PRESSURE  
SEPTIC TANK LOCATION & DUPLICATION AREA  
WELL LOCATION  
ISOLATION RADIUS FROM WELL

REVISIONS  
NO. DATE BY  
1  
2  
3  
4  
5  
PLAN PREPARED BY:  
**BABCOCK · JONES & ASSOCIATES, INC.**  
PAINESVILLE, OHIO  
DRAWN BY --- SCALE --- PHONE NO. 440-367-1811  
CHK'D. --- DATE 9/21/06 DRAWING NO. 02-230-241  
APP'D. --- APP'D. ---

"AS BUILT" CERTIFICATION  
I, HEREBY CERTIFY THAT THE CIRCLED GRADES ARE EXISTING FINISH GRADES CHECKED IN THE FIELD ON 9/21/06, 2006 AND ARE CORRECT TO THE BEST OF MY KNOWLEDGE AND BELIEF.

REGISTERED SURVEYOR

REG. NO.

EXISTING UTILITIES NOTE:  
THE SIZE AND LOCATION, BOTH HORIZONTAL AND VERTICAL OF THE UNDERGROUND UTILITIES SHOWN HEREON, HAVE BEEN OBTAINED BY A SEARCH OF AVAILABLE RECORDS. VERIFICATION BY FIELD OBSERVATION HAS BEEN CONDUCTED WHERE PRACTICAL, HOWEVER, BABCOCK, JONES AND ASSOCIATES INC. DOES NOT GUARANTEE THE COMPLETENESS NOR ACCURACY THEREOF.

