


CONCORD TOWNSHIP ZONING OFFICE

ZONING PERMIT # 0803-11235

ISSUED 8/25/03

SUBJECT TO APPROVAL BY:

- ☒ Lake Co. Engineer  
☒ Lake Co. Eng. Dept.  
☐ Lake Co. Planning Comm.  
☒ Lake Co. Building Dept.  
☒ Lake Co. Soil & Water Cons. Dist.

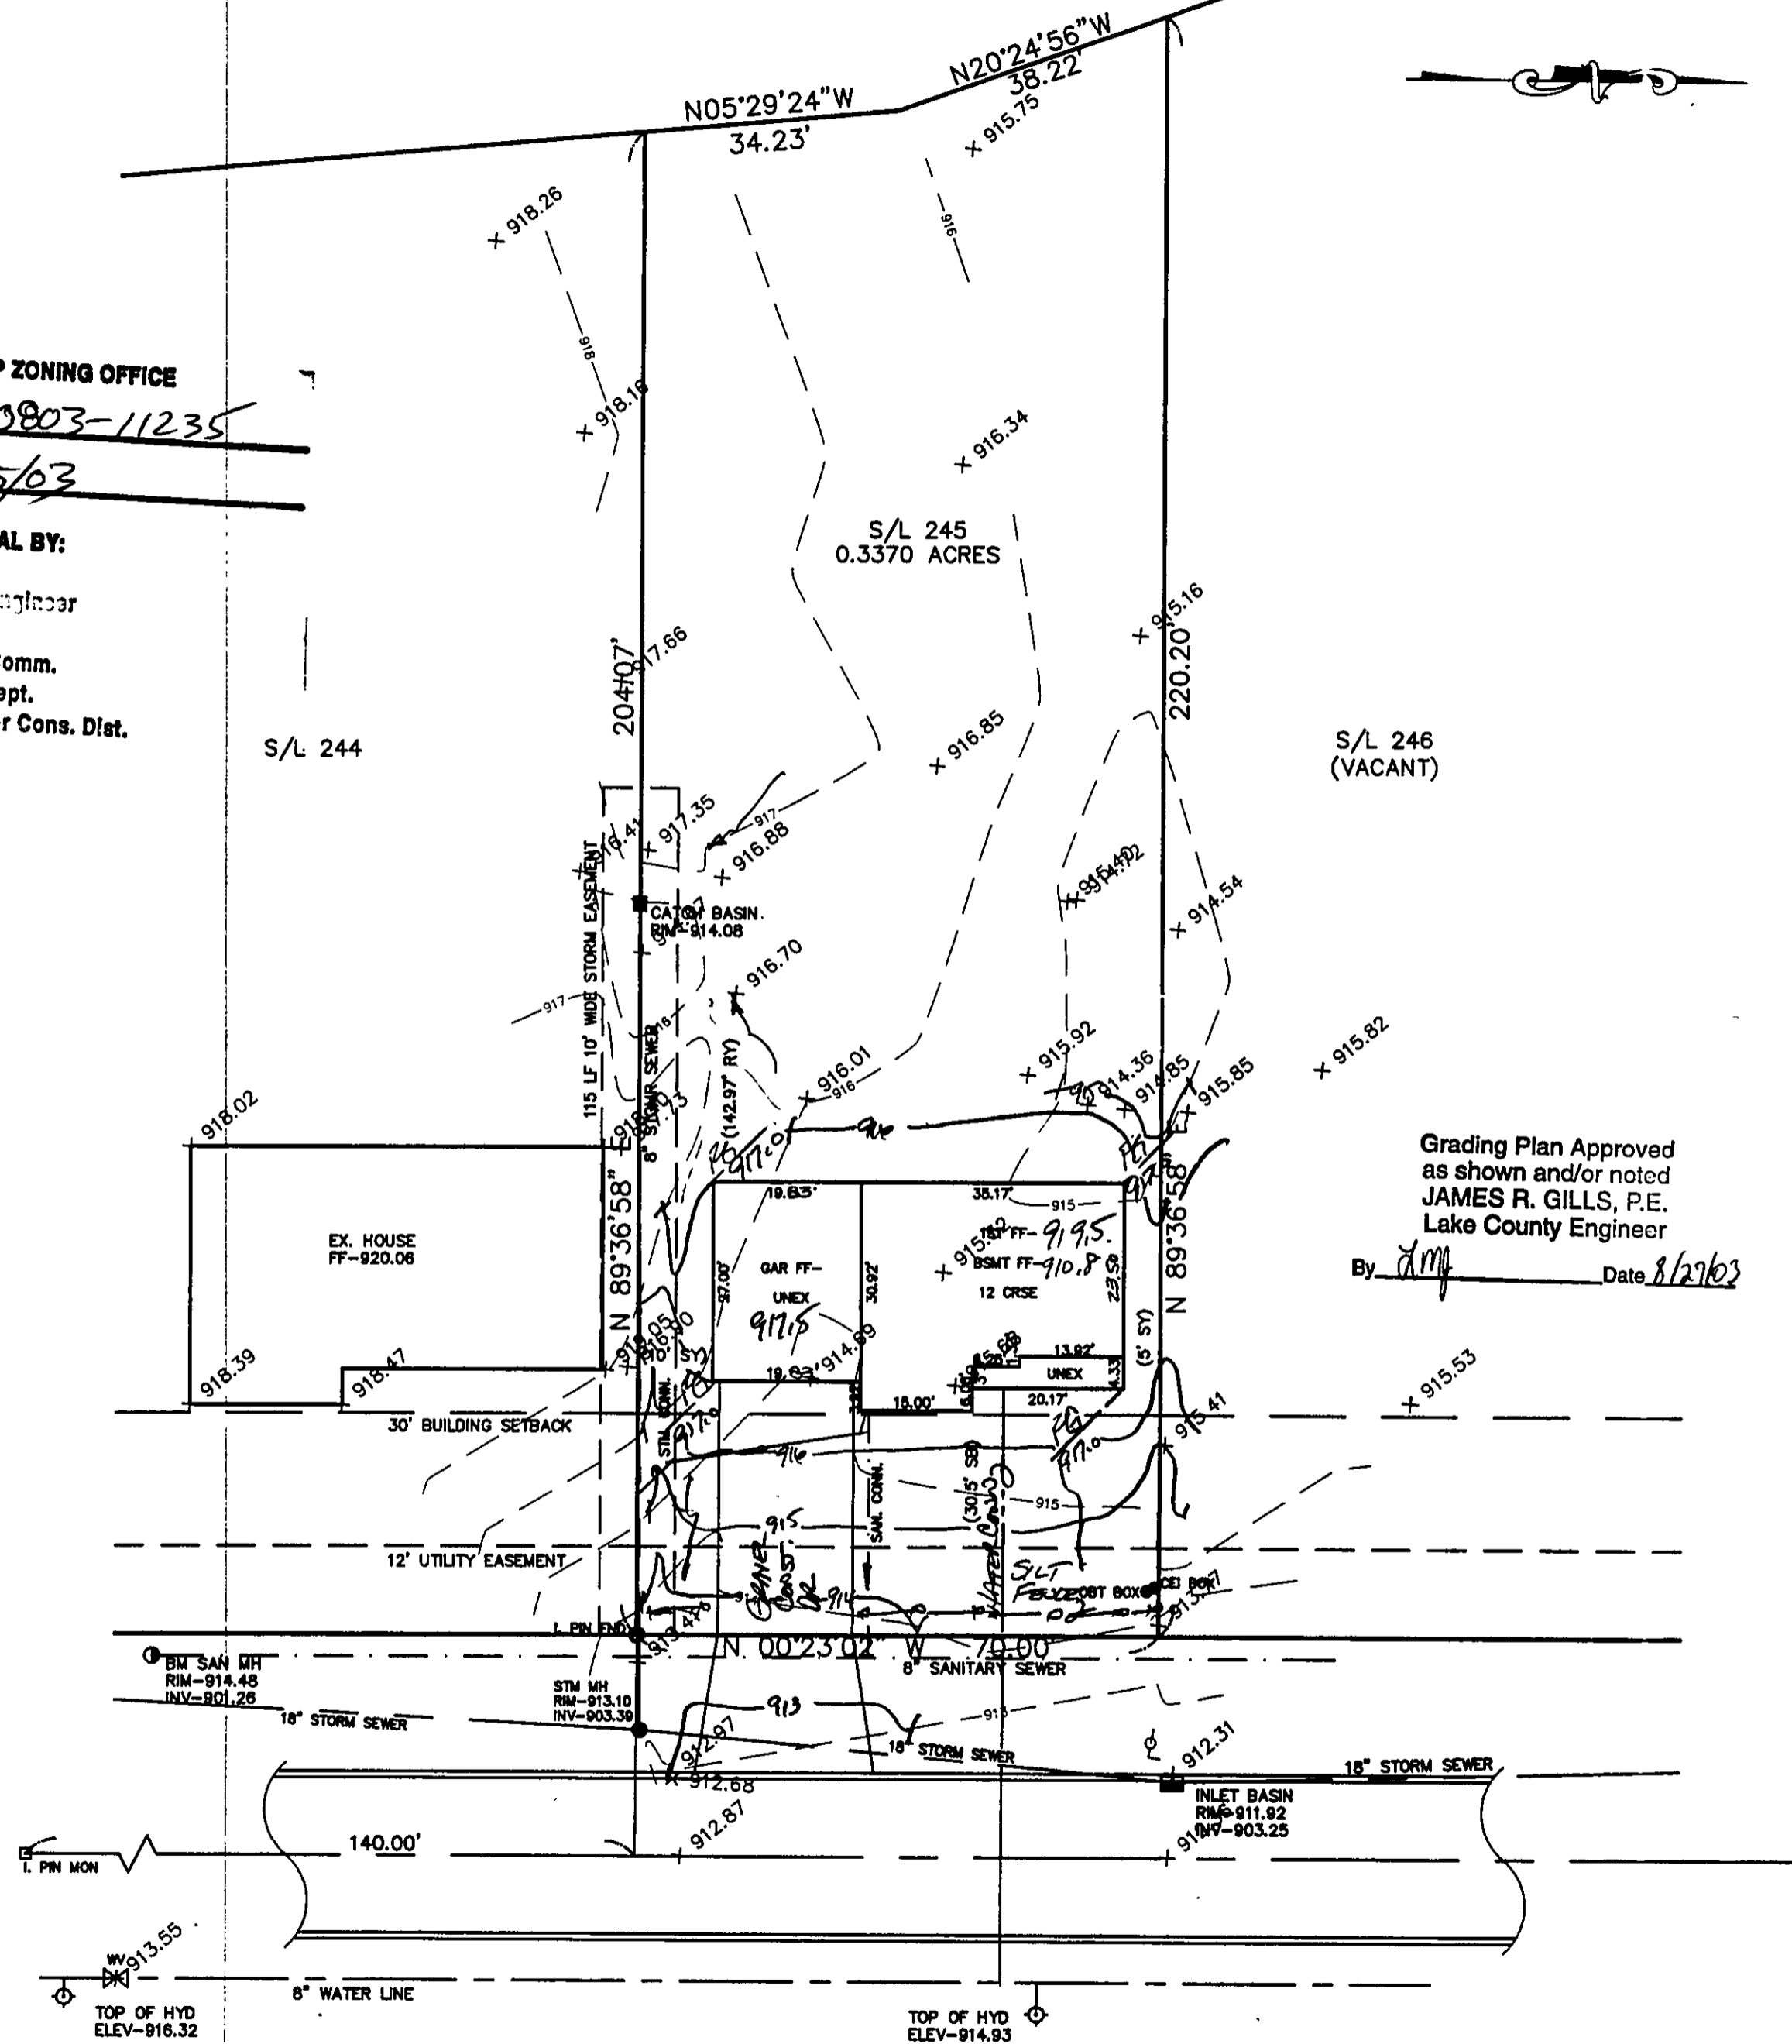

JUMPERS CROSSING LANE - 60'

## SITE PLAN

CONCORD TWP., LAKE COUNTY, OHIO

for: VINTAGE HOMES

CLIENT		OWNER	
ADDRESS	STREET	CITY	ZIP
QUAIL HOLLOW #8			
SUBDIVISION	43-1	NAME	TRACT
245	VOL-PG.	LOT	STREET
SUBLOT NO.		JUMPERS CROSSING LANE	
		VOL-PG.	PARCEL NO.

### LEGEND

SANITARY MANHOLE	---○---	EXIST. ELEV. $\pm 100.0$	PROP. ELEV. $\pm 100.0$
STORM MANHOLE	---●---	AS BUILT ELEVATION	
INLET OR CATCH BASIN	---○---	INDICATES	
HYDRANT	---○---	DIRECTION OF	
EXISTING CONTOURS	---○---	SURFACE DRAINAGE	
PROPOSED CONTOURS	---○---		

### REMARKS

ALL BOUNDARY DATA SHOWN WAS OBTAINED FROM (DEEDS, RECORDED SUBDIVISION PLAT OR OTHER PUBLIC RECORDS)

LOCATIONS AS SHOWN OF ADJACENT WELLS AND SEPTIC TANKS OBTAINED FROM LAKE COUNTY HEALTH DEPARTMENT

### DESIGN CERTIFICATION

THIS PLAT WAS PREPARED BY ME, AND IS CORRECT TO THE BEST OF MY KNOWLEDGE AND BELIEF.

NAME James R. Gills SURVEYOR REGISTRATION NO. 6343

### CHECK LIST

NO. OF BEDROOMS	WATER MAIN SIZE, LOCATION
DIMENSIONS	SAN. SEWER SIZE & OR. LOC.
BEARINGS	SAN. MH. CAST. ELEV. INV. ELEV.
TIE TO NEAREST STREET	SAN. CONN. SIZE, LOC. DEPTH
SUBLOT NO. PARCEL NO.	STORM SEWER SIZE & OR. LOC.
SURROUNDING OWNERS	STORM MH. CAST ELEV. INV. ELEV.
BLDG. DIMENSIONS FIN GR.	PAY'T TYPE GRADE CURBS
BLDG. TIES PL'R. GRADES	GAS LINE LOC. SIZE PRESSURE
APRON TYPE WIDTH THICKNESS	SEPTIC TANK LOCATION & DUPLICATION AREA
SIDEWALK TYPE WIDTH THICKNESS	WELL LOCATION
CULVERT TYPE DIA. LENGTH	ISOLATION RADIUS FROM WELL
ROCK OUTCROPPINGS	

REVISIONS			PLAN PREPARED BY:		
NO.	DATE	BY	BABCOCK JONES & ASSOCIATES, INC.		
1			PAINESVILLE, OHIO		
2			DRAWN BY	N.S.	SCALE 1"=20'
3			CHK'D.	H.J.	DATE 8/21/03
4			APP'D	H.J.	PHONE NO. 440-357-1811
5			CHIEF	W.B.	DRAWING NO. 02-230-245

### "AS BUILT" CERTIFICATION

I, HEREBY CERTIFY THAT THE CIRCLED GRADES ARE EXISTING FINISH GRADES CHECKED IN THE FIELD ON 8/21/03, 2003 AND ARE CORRECT TO THE BEST OF MY KNOWLEDGE AND BELIEF.

REGISTERED SURVEYOR

REG. NO.

BM SANITARY MANHOLE  
ELEV-914.48

NOTE: TEMPORARY SEEDING REQUIRED IN DISTURBED AREAS.

EXISTING UTILITIES NOTE:  
THE SIZE AND LOCATION, BOTH HORIZONTAL AND VERTICAL OF THE UNDERGROUND UTILITIES SHOWN HEREON, HAVE BEEN OBTAINED BY A SEARCH OF AVAILABLE RECORDS. VERIFICATION BY FIELD OBSERVATION HAS BEEN CONDUCTED WHERE PRACTICAL. HOWEVER, BABCOCK, JONES AND ASSOCIATES INC. DOES NOT GUARANTEE THE COMPLETENESS NOR ACCURACY THEREOF.

