


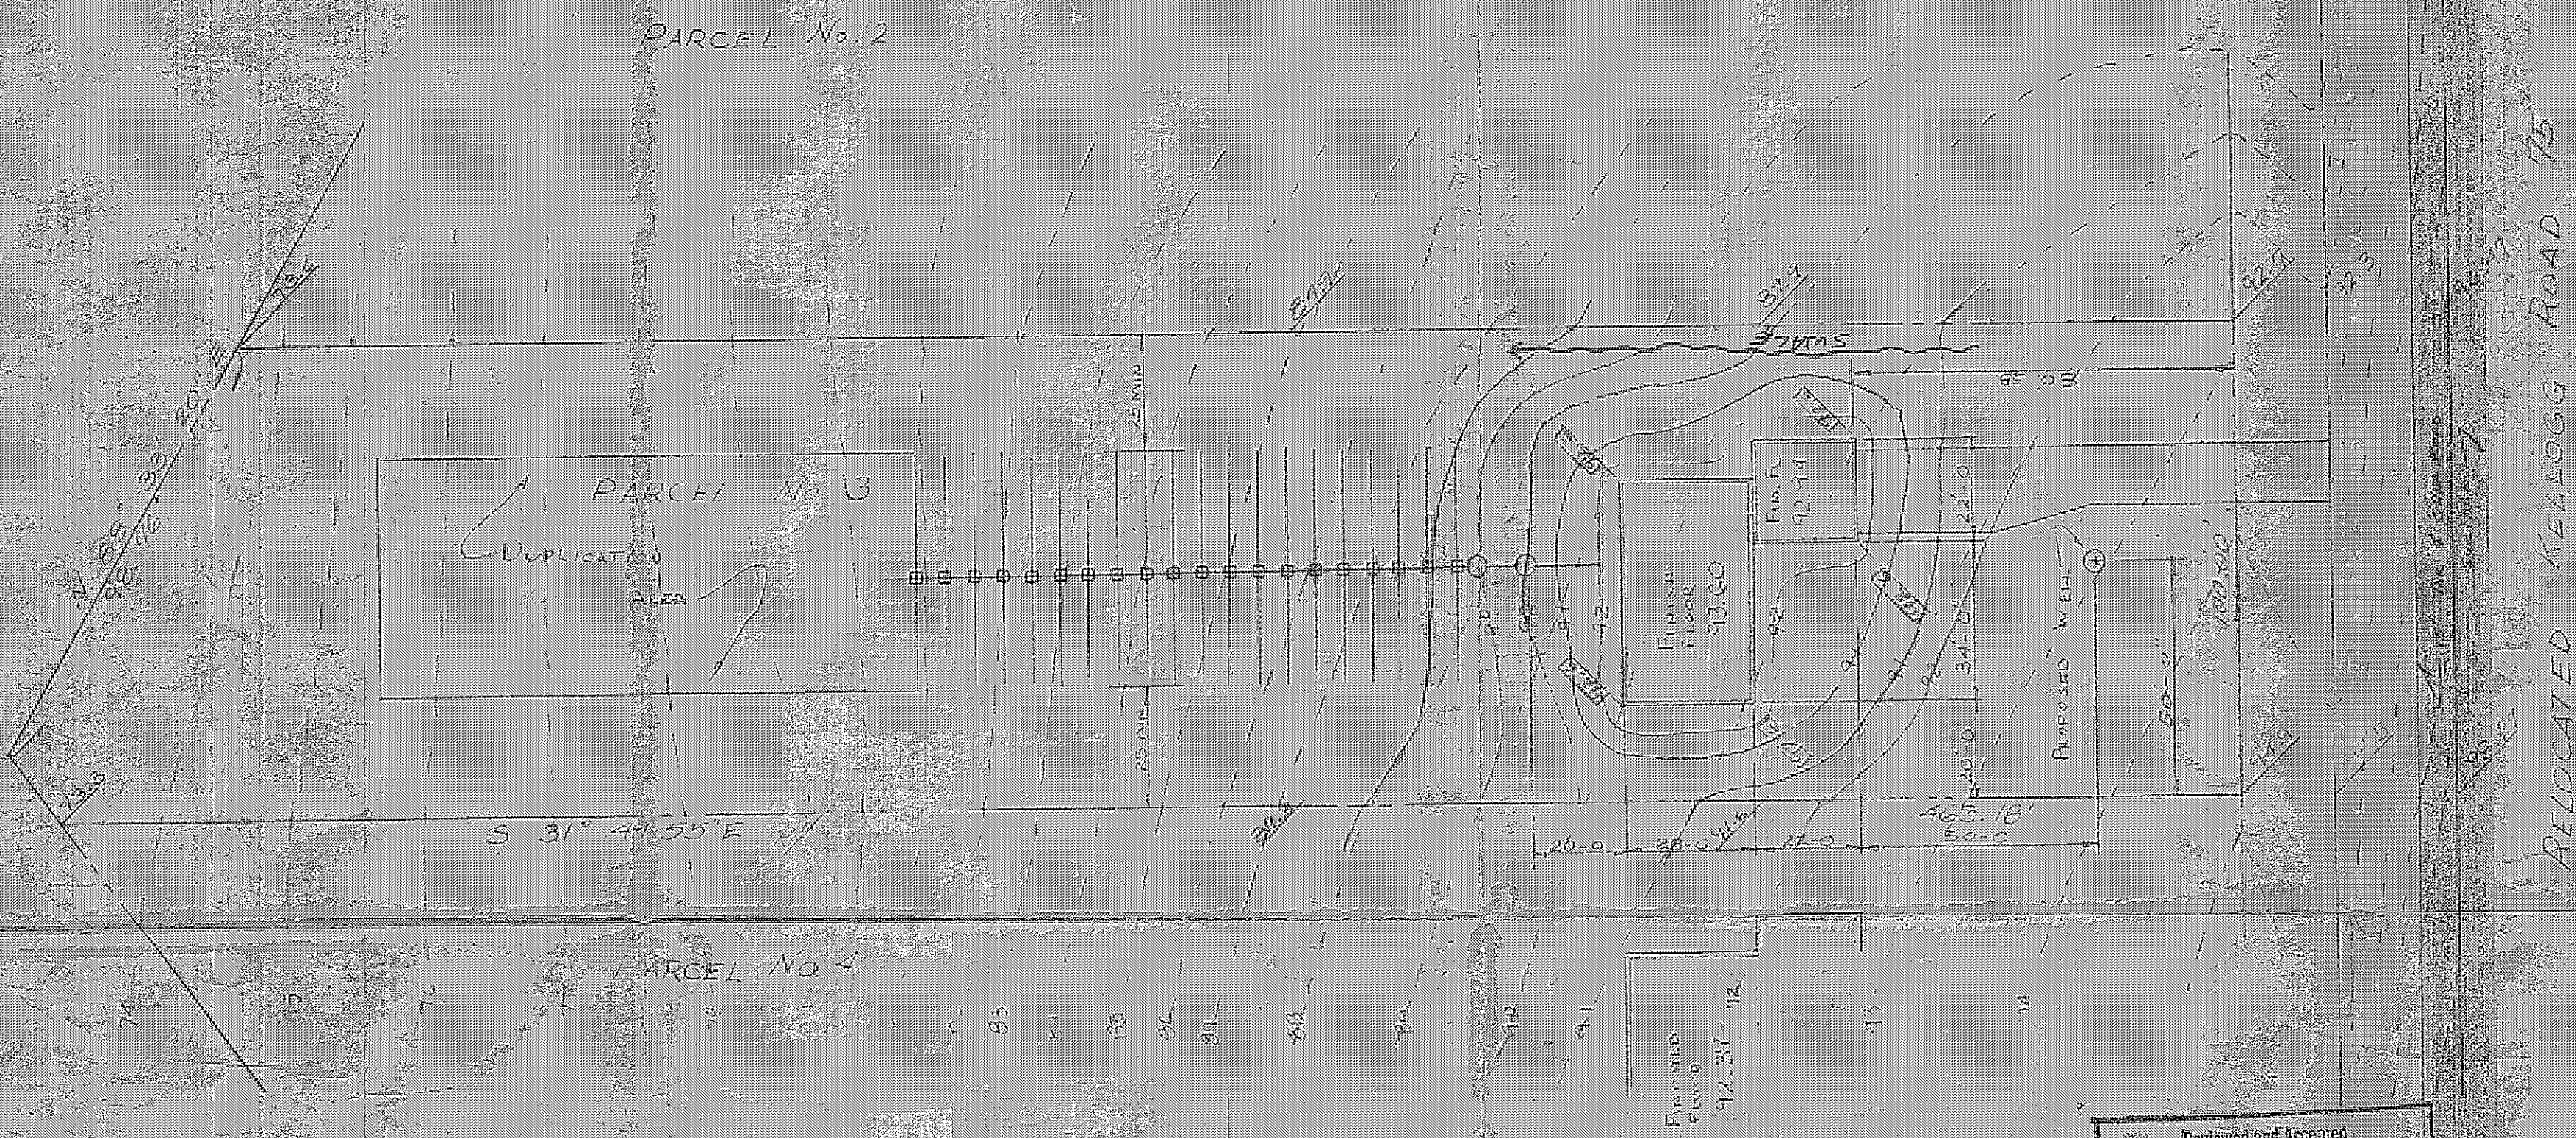

- A. To be brought to finished grade
1. Septic tank manhole covers
 2. Splitter box cover
 3. Distribution box cover
 4. Vent Pipes
- B. No footer drains or downspouts to be discharged into septic tanks
- C. All waste water to be discharged into septic tanks

Reviewed and Accepted
LAKE COUNTY COMBINED GENERAL
DISTRICT DEPARTMENT OF HEALTH
Date 8-18-77
FRED C. KLUTH, M.D.
Health Commissioner
By: [Signature]

ZONING PERMIT
Approved 8-18-77
[Signature]

SITE PLAN FOR
CHUCK RUDOLF
10311 PAGE DRIVE
MENTOR, OHIO

PREPARED BY:
WM R GRAY ASSOC INC
1547 MENTOR AVE
MENTOR, OHIO

DATE AUG 9 1977 SCALE 1"=30'

BEING PARCELS NUMBER 3
ON RELOCATED KELLOGG ROAD IN
CONCORD TWP, OHIO

CERTIFICATION
I HEREBY CERTIFY THAT THIS
PLAT IS CORRECT TO THE BEST OF
MY KNOWLEDGE
By: [Signature]
Dennis D. Brewster Reg. Surv. # 5243
Wm. R. Gray, Reg. Surv. # 2752

9-19-77
[Signature]

