


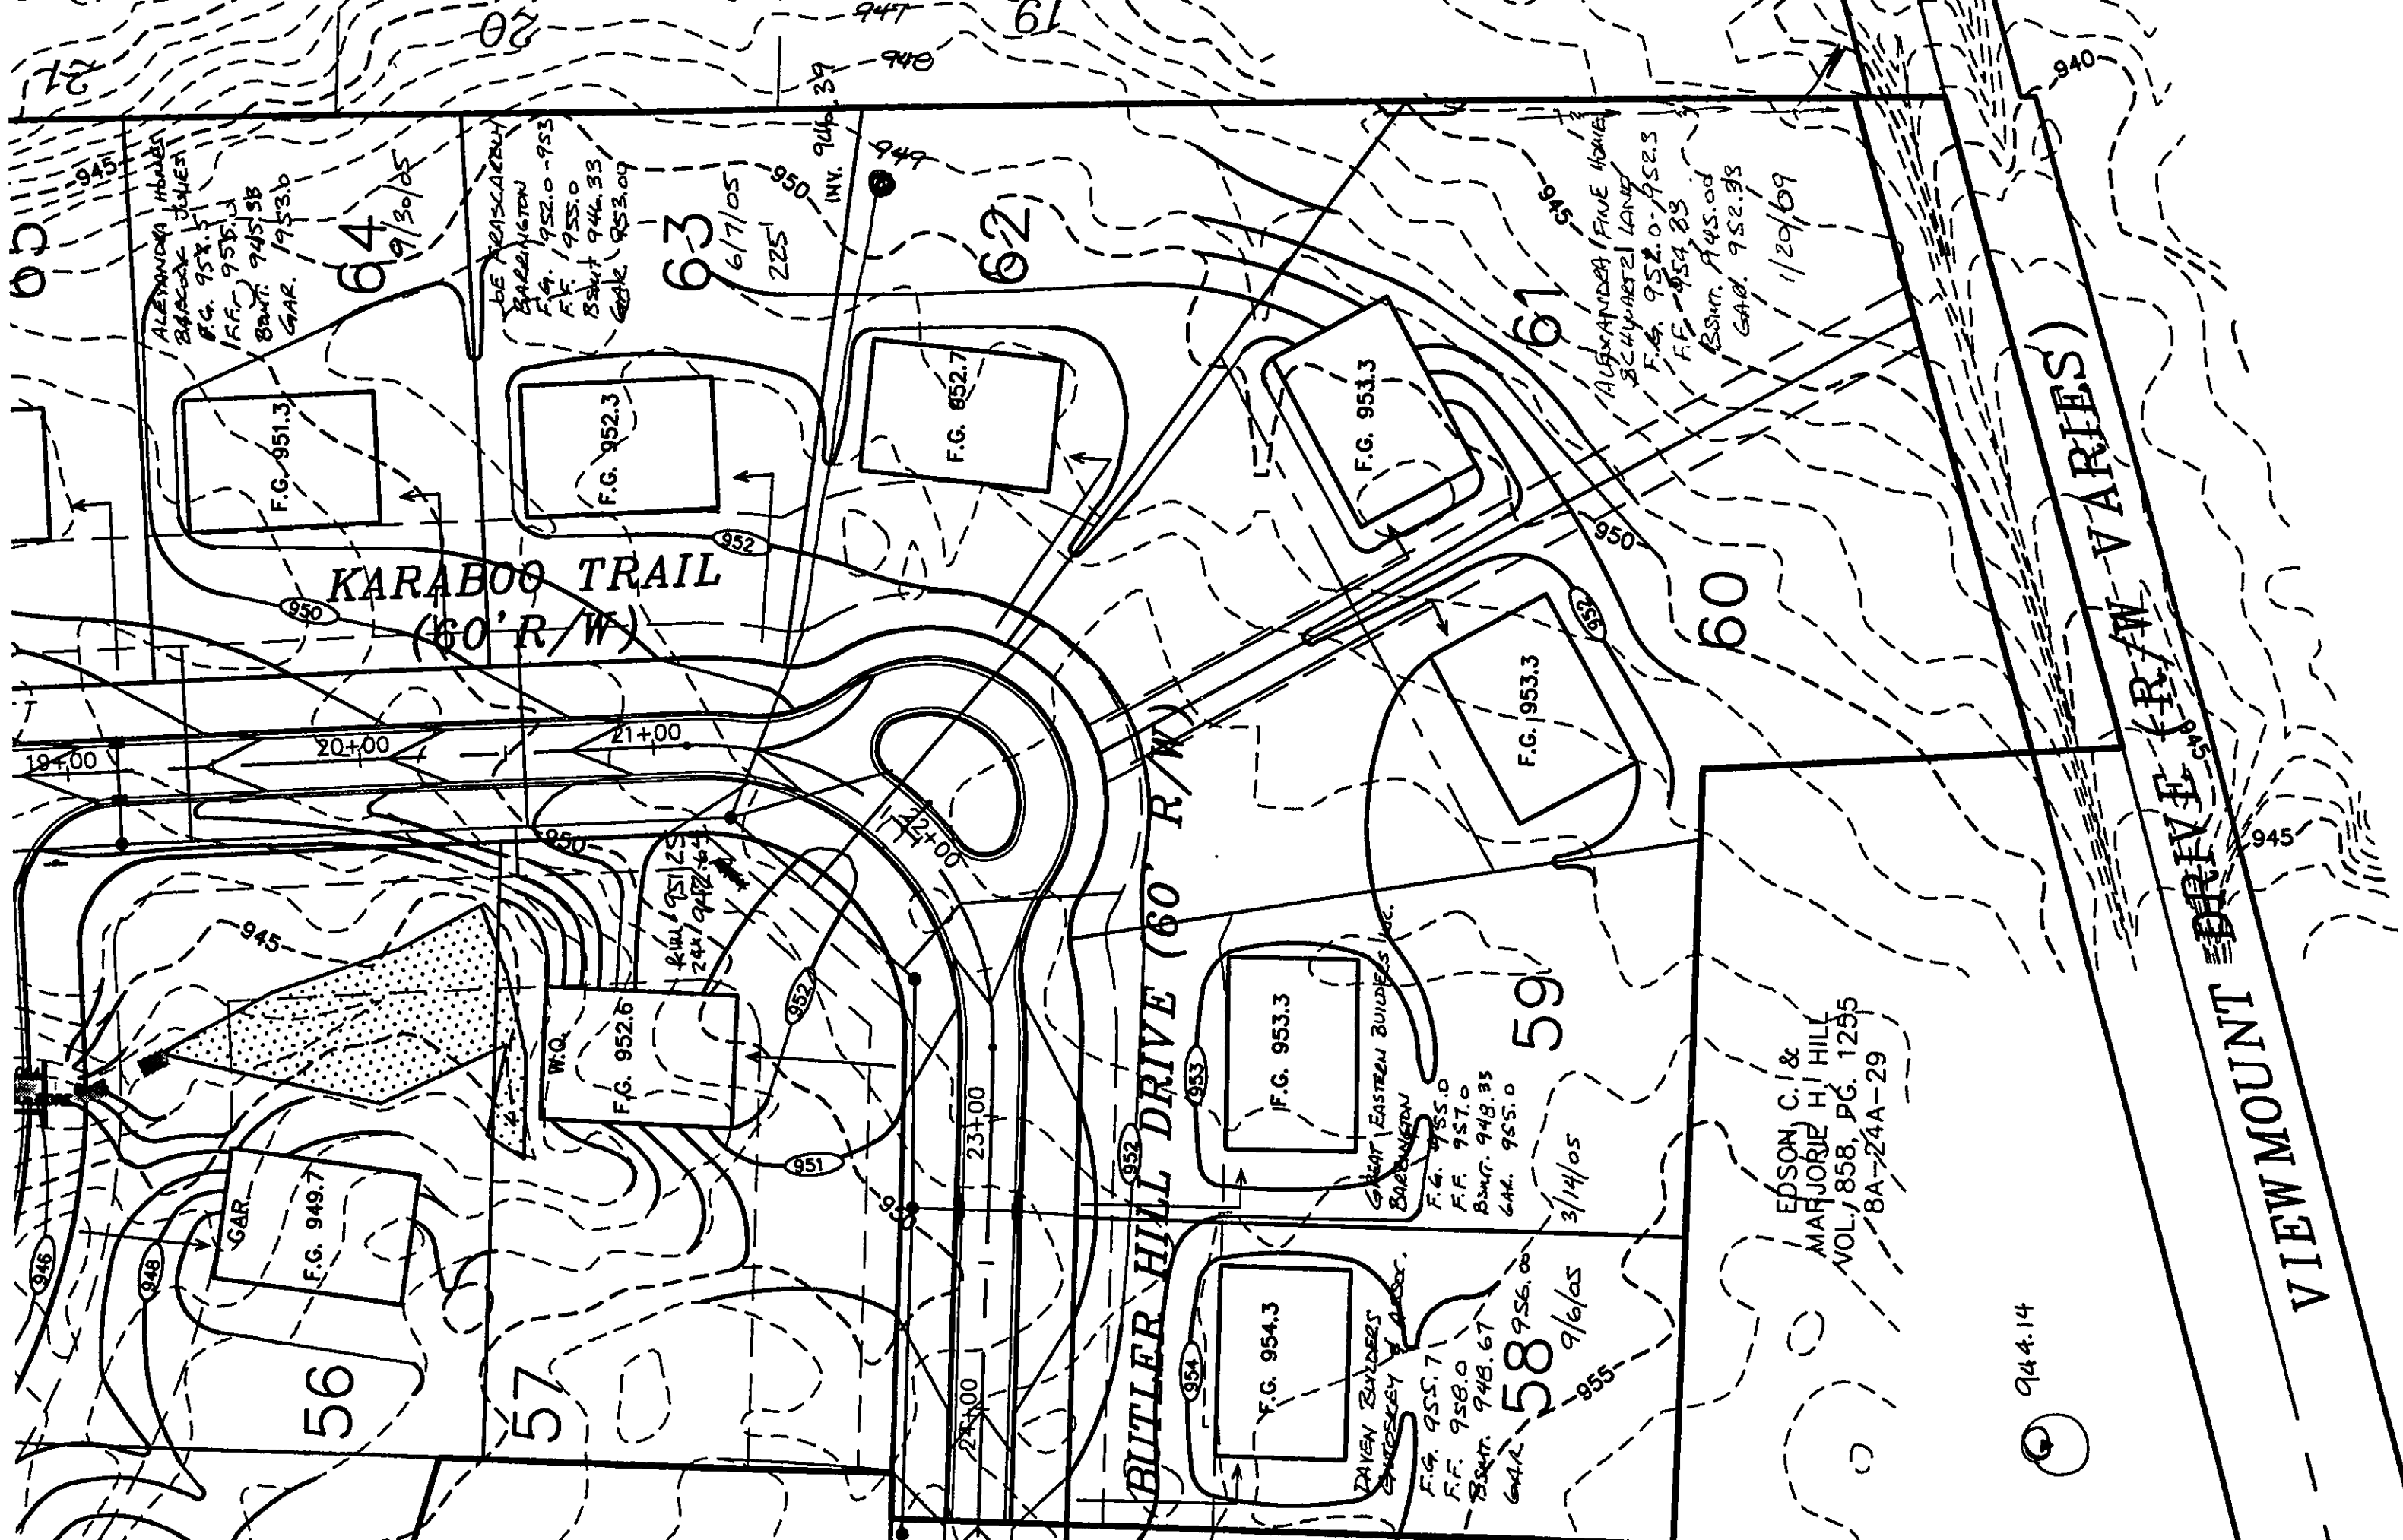

ALEXANDRA HENDER
BARACK JONES
F.G. 952.5
F.F. 955.3
BSMT. 945.98
GAR. 953.6
9/30/05

DE PRASCARBY
BARRINGTON
F.G. 952.0-953
F.F. 955.0
BSMT. 944.33
GAR. 953.09
6/7/05

ALEXANDRA FINE HOME
SCHYARTZ LAND
F.G. 952.0-952.3
F.F. 954.83
BSMT. 945.04
GAR. 952.38
1/29/09

GREAT EASTERN BUILDERS, INC.
BARRINGTON
F.G. 955.0
F.F. 957.0
BSMT. 948.33
GAR. 955.0
3/14/05

DAVEN BUILDERS
CHESNEY & ASSOC.
F.G. 955.7
F.F. 958.0
BSMT. 948.67
GAR. 956.00
9/6/05

EDSON, C. I &
MARJORIE HILL
VOL. 858, PG. 1255
8A-24A-29

944.14

VIEW MOUNT DRIVE (R/W VARIES)