


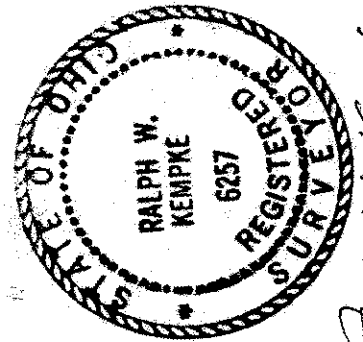

Ralph W. Kempke

SITE PLAN
FOR RE. AND RES. CURTIS
OF A 2.00 ACRE PARCEL LOCATED IN CONCORD TOWNSHIP
LOT NO 23 TRACT NO 4 IN SAID TOWNSHIP. MAY 1989
PREPARED BY RALPH W. KEMPKE 1749 KAPET DR. ELUCID OH.

NOTES

- 1. PROPOSED GROUND GRADES
- 2. OVERLAND DRAINAGE FLOW
- 3. EXISTING GROUND CONTOURS
- 4. PROPOSED GROUND CONTOURS
- 5. BEVEL MARK TOP OF F.R. BY S.W. COR.
- 6. = TIE IN PLUS FOUND
- 7. ALL WORK TO BE DONE PER LAKE COUNTY HEALTH DEPT. STANDARDS
- 8. ALL FINISH FLOOR ELEVATIONS AND DEPTH, SIZE AND LOCATIONS OF ALL UTILITY CONNECTIONS TO BE VERIFIED BY OWNER.

Grading Plan Approved
as shown and/or noted
THOMAS P. GILLES, P.E.
Lake County Engineer

Date: 5-15-89

Stamp: *Seal of Surveyor*


ZONING PERMIT 6155
MAINTAINED 5-15-89

- ☐ Lake County Sanitary Eng.
- ☒ Lake County Dept.
- ☒ Lake County Planning Comm.
- ☒ Lake County Bldg. Dept.

PEOPLE OF EVAPRO-TRANSPO SYSTEM (NOT TO SCALE)

1000' OF EVAPRO-TRANSPO

DISTRIBUTION

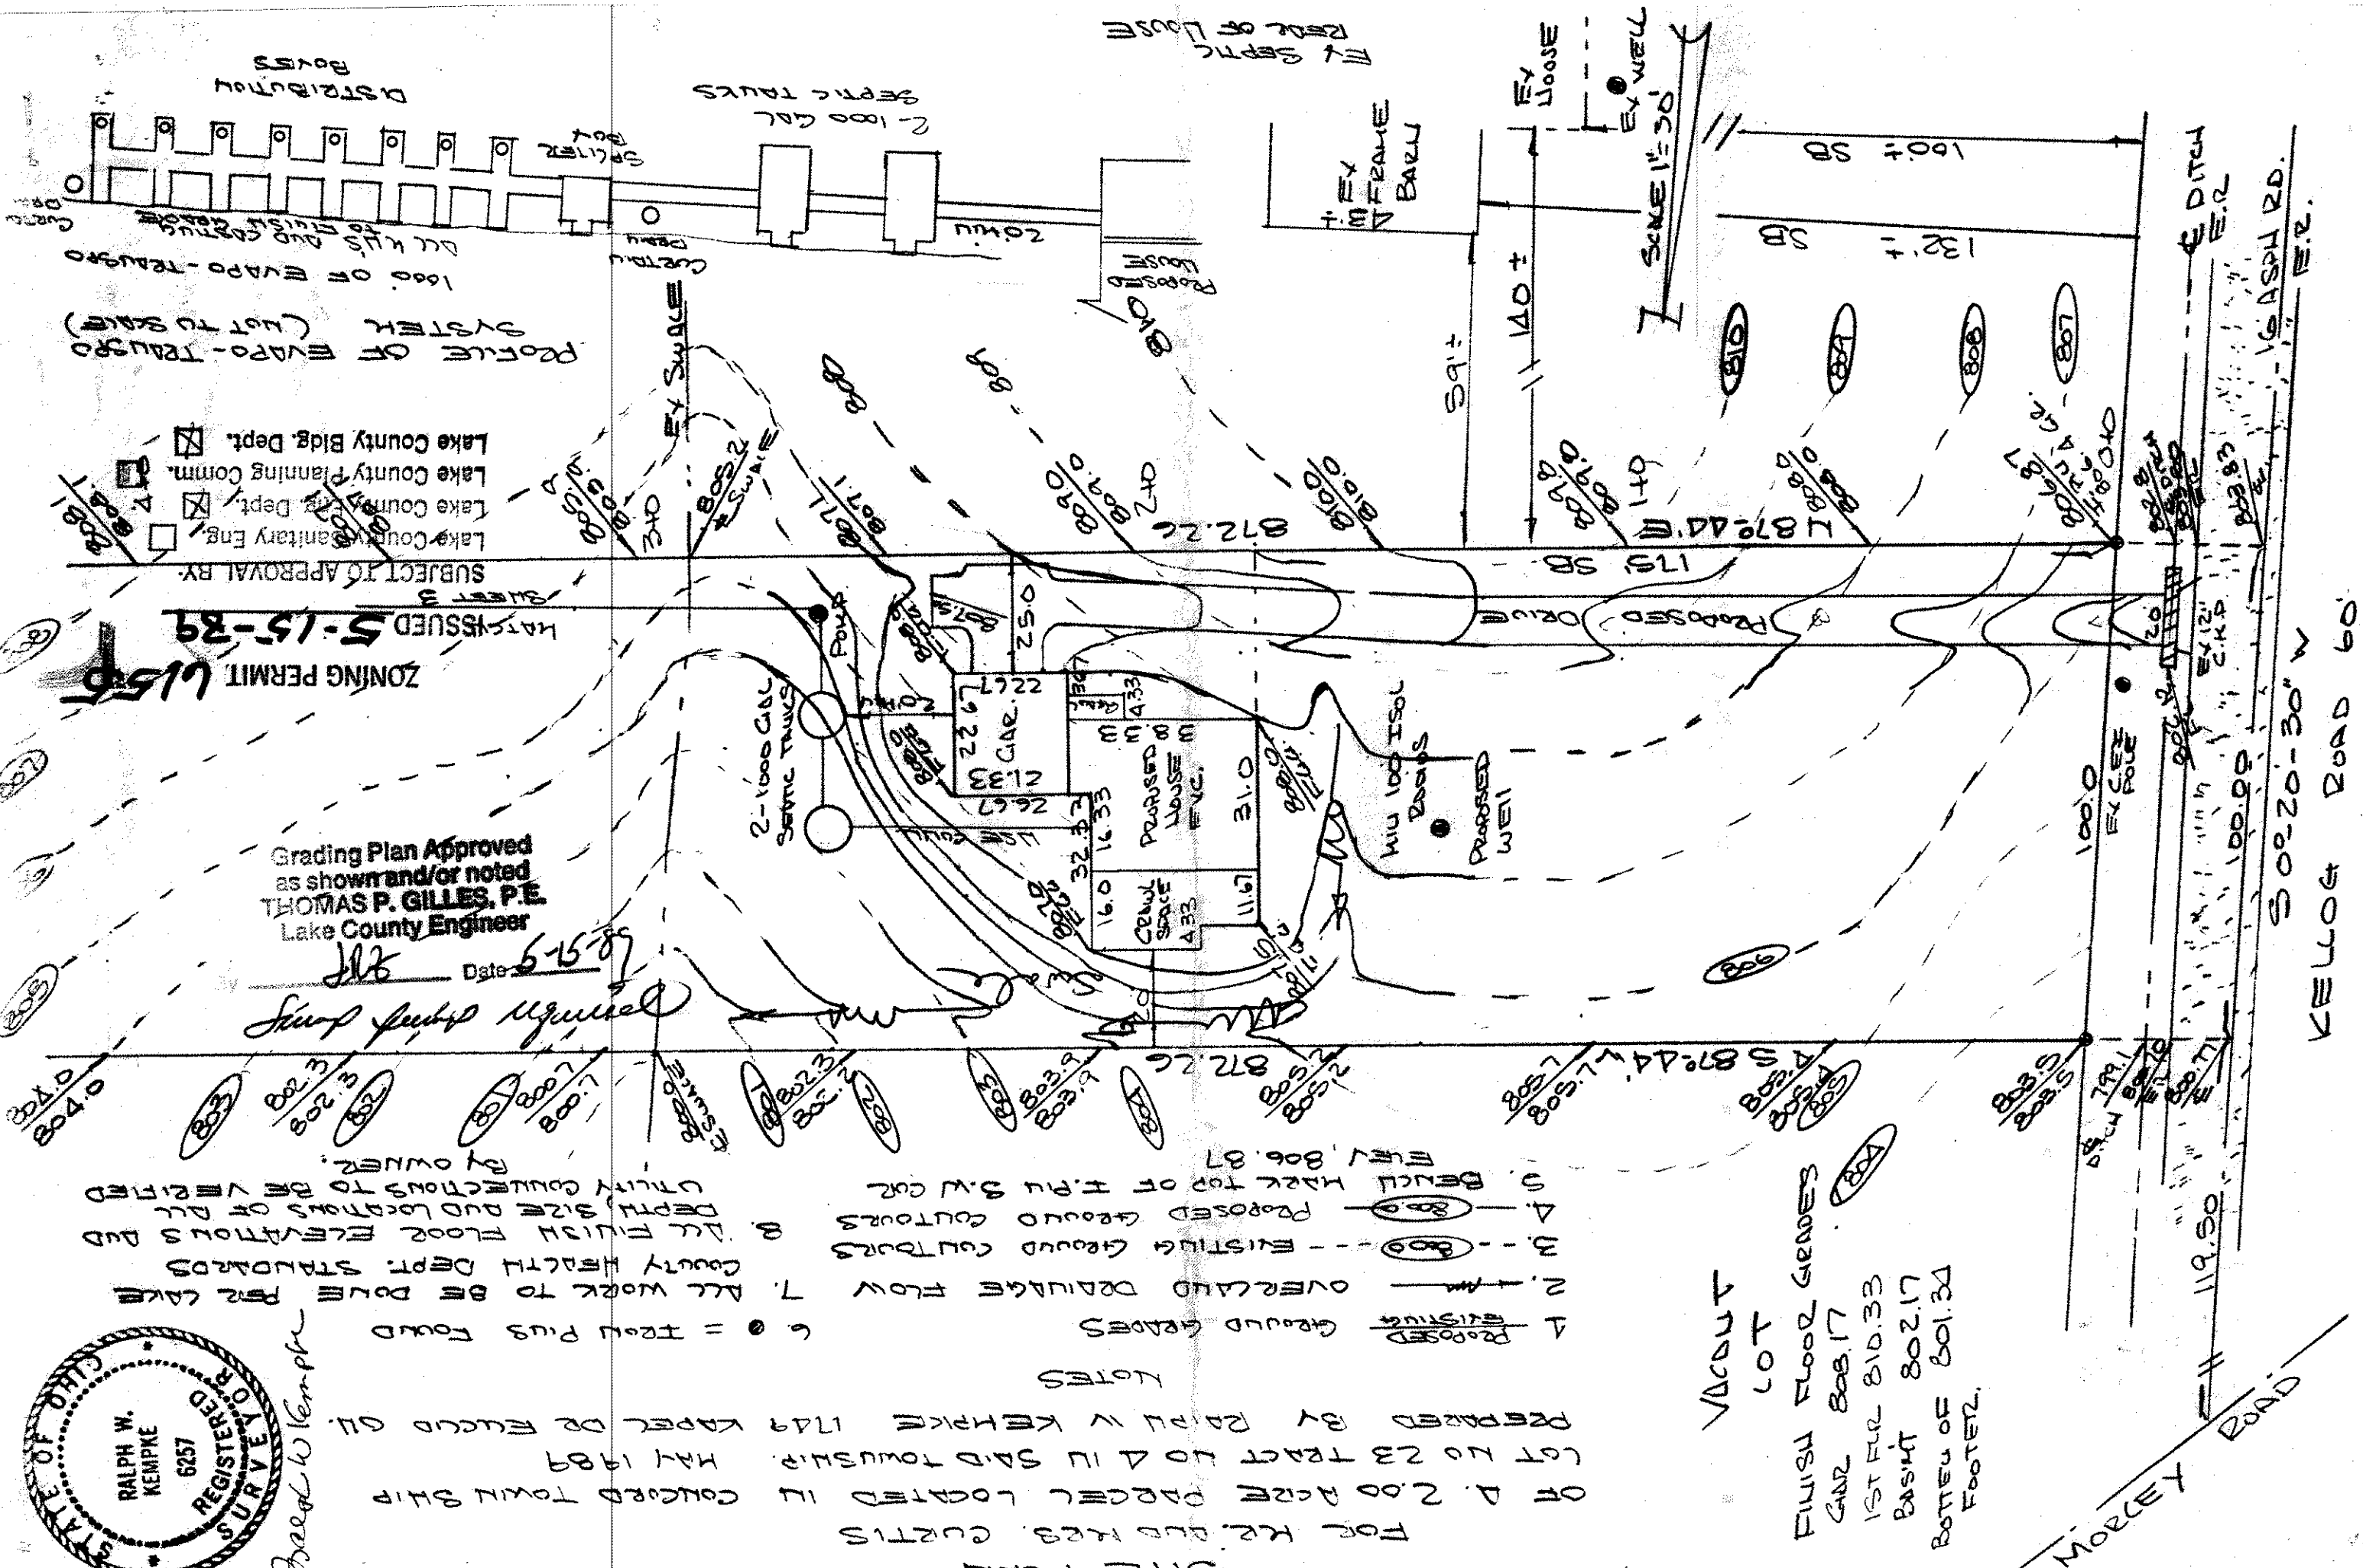

VACUUM
LOT
FINISH FLOOR GRADES
GAR. 808.17
1ST FLR 810.33
BASMT 802.17
BOTTOM OF 801.34
FOOTER.

MORLEY ROAD

500' 20'-30" W
KELLOGG ROAD 60'

DITCH
E.R.

16' ASPH RD.

E.R.