


By TAM Date 11/9/00  
Swak as shown  
Enter drain to storm conn

SUBJECT:

- ☐ Lake Co. Sanitary Engineer
- ☒ Lake Co. Eng. Dept.
- ☐ Lake Co. Planning Comm.
- ☒ Lake Co. Building Dept.
- ☒ Lake Co. Soil & Water Cons. Dist.

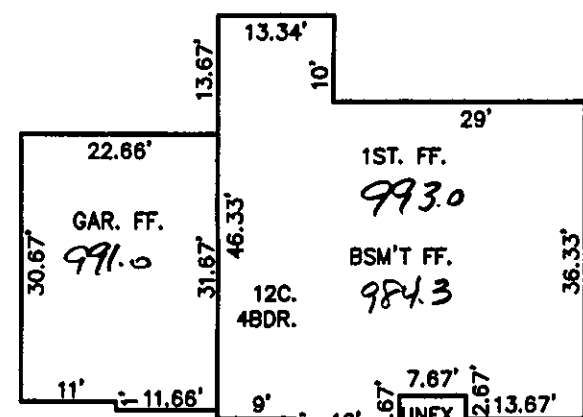

REVIEWED AND ACCEPTED  
LAKE COUNTY GENERAL  
HEALTH DISTRICT

Date 11-6-01 by D. J. [Signature]

SEWAGE DISPOSAL PERMIT MUST BE  
OBTAINED BY A LAKE COUNTY LICENSED  
INSTALLER BEFORE INSTALLATION IS  
COMPLETED

NO. OF BEDROOMS DIMENSIONS BEARINGS TIE TO NEAREST STREET SUBLOT NO. PARCEL NO. SURROUNDING OWNERS BLDG. DIMENSIONS FIN GR. BLDG. TIES FL'R. GRADES APRON TYPE WIDTH THICKNESS SIDEWALK TYPE WIDTH THICKNESS CULVERT TYPE DIA., LENGTH ROCK OUTCROPPINGS			WATER MAIN SIZE, LOCATION SAN. SEWER SIZE & GR. LOC. SAN. M&I. CAST. ELEV. INV. ELEV. SAN. CONN. SIZE, LOC. DEPTH STORM SEWER SIZE & GR. LOC. STORM M&I. CAST ELEV. INV. ELEV. PAV'T TYPE GRADE CURBS GAS LINE LOC. SIZE PRESSURE SEPTIC TANK LOCATION & DUPLICATION AREA WELL LOCATION ISOLATION RADIUS FROM WELL		
---	--	--	--	--	--

**"AS BUILT" CERTIFICATION**  
I, HEREBY CERTIFY THAT THE CIRCLED GRADES ARE EXISTING  
FINISH GRADES CHECKED IN THE FIELD ON \_\_\_\_\_, 20\_\_\_\_  
AND ARE CORRECT TO THE BEST OF MY KNOWLEDGE AND BELIEF.

REGISTERED SURVEYOR	REF. NO.
BM-NAIL IN TREE S/L 17 ELEV.=980.06	C1: R=372.28' L=34.42' T=17.22' D=05°17'50" C=34.41' N07°03'03"E

"I, the undersigned hereby certify that this topography indicated by 6", 1", or 2" contours, and elevations shown hereon represent an actual field survey made by me on the 25th day of Oct, 2000 and that the elevations were taken at appropriate intervals and that as of that date they existed as indicated hereon."

Name James Jones #6343 Reg. No.

