


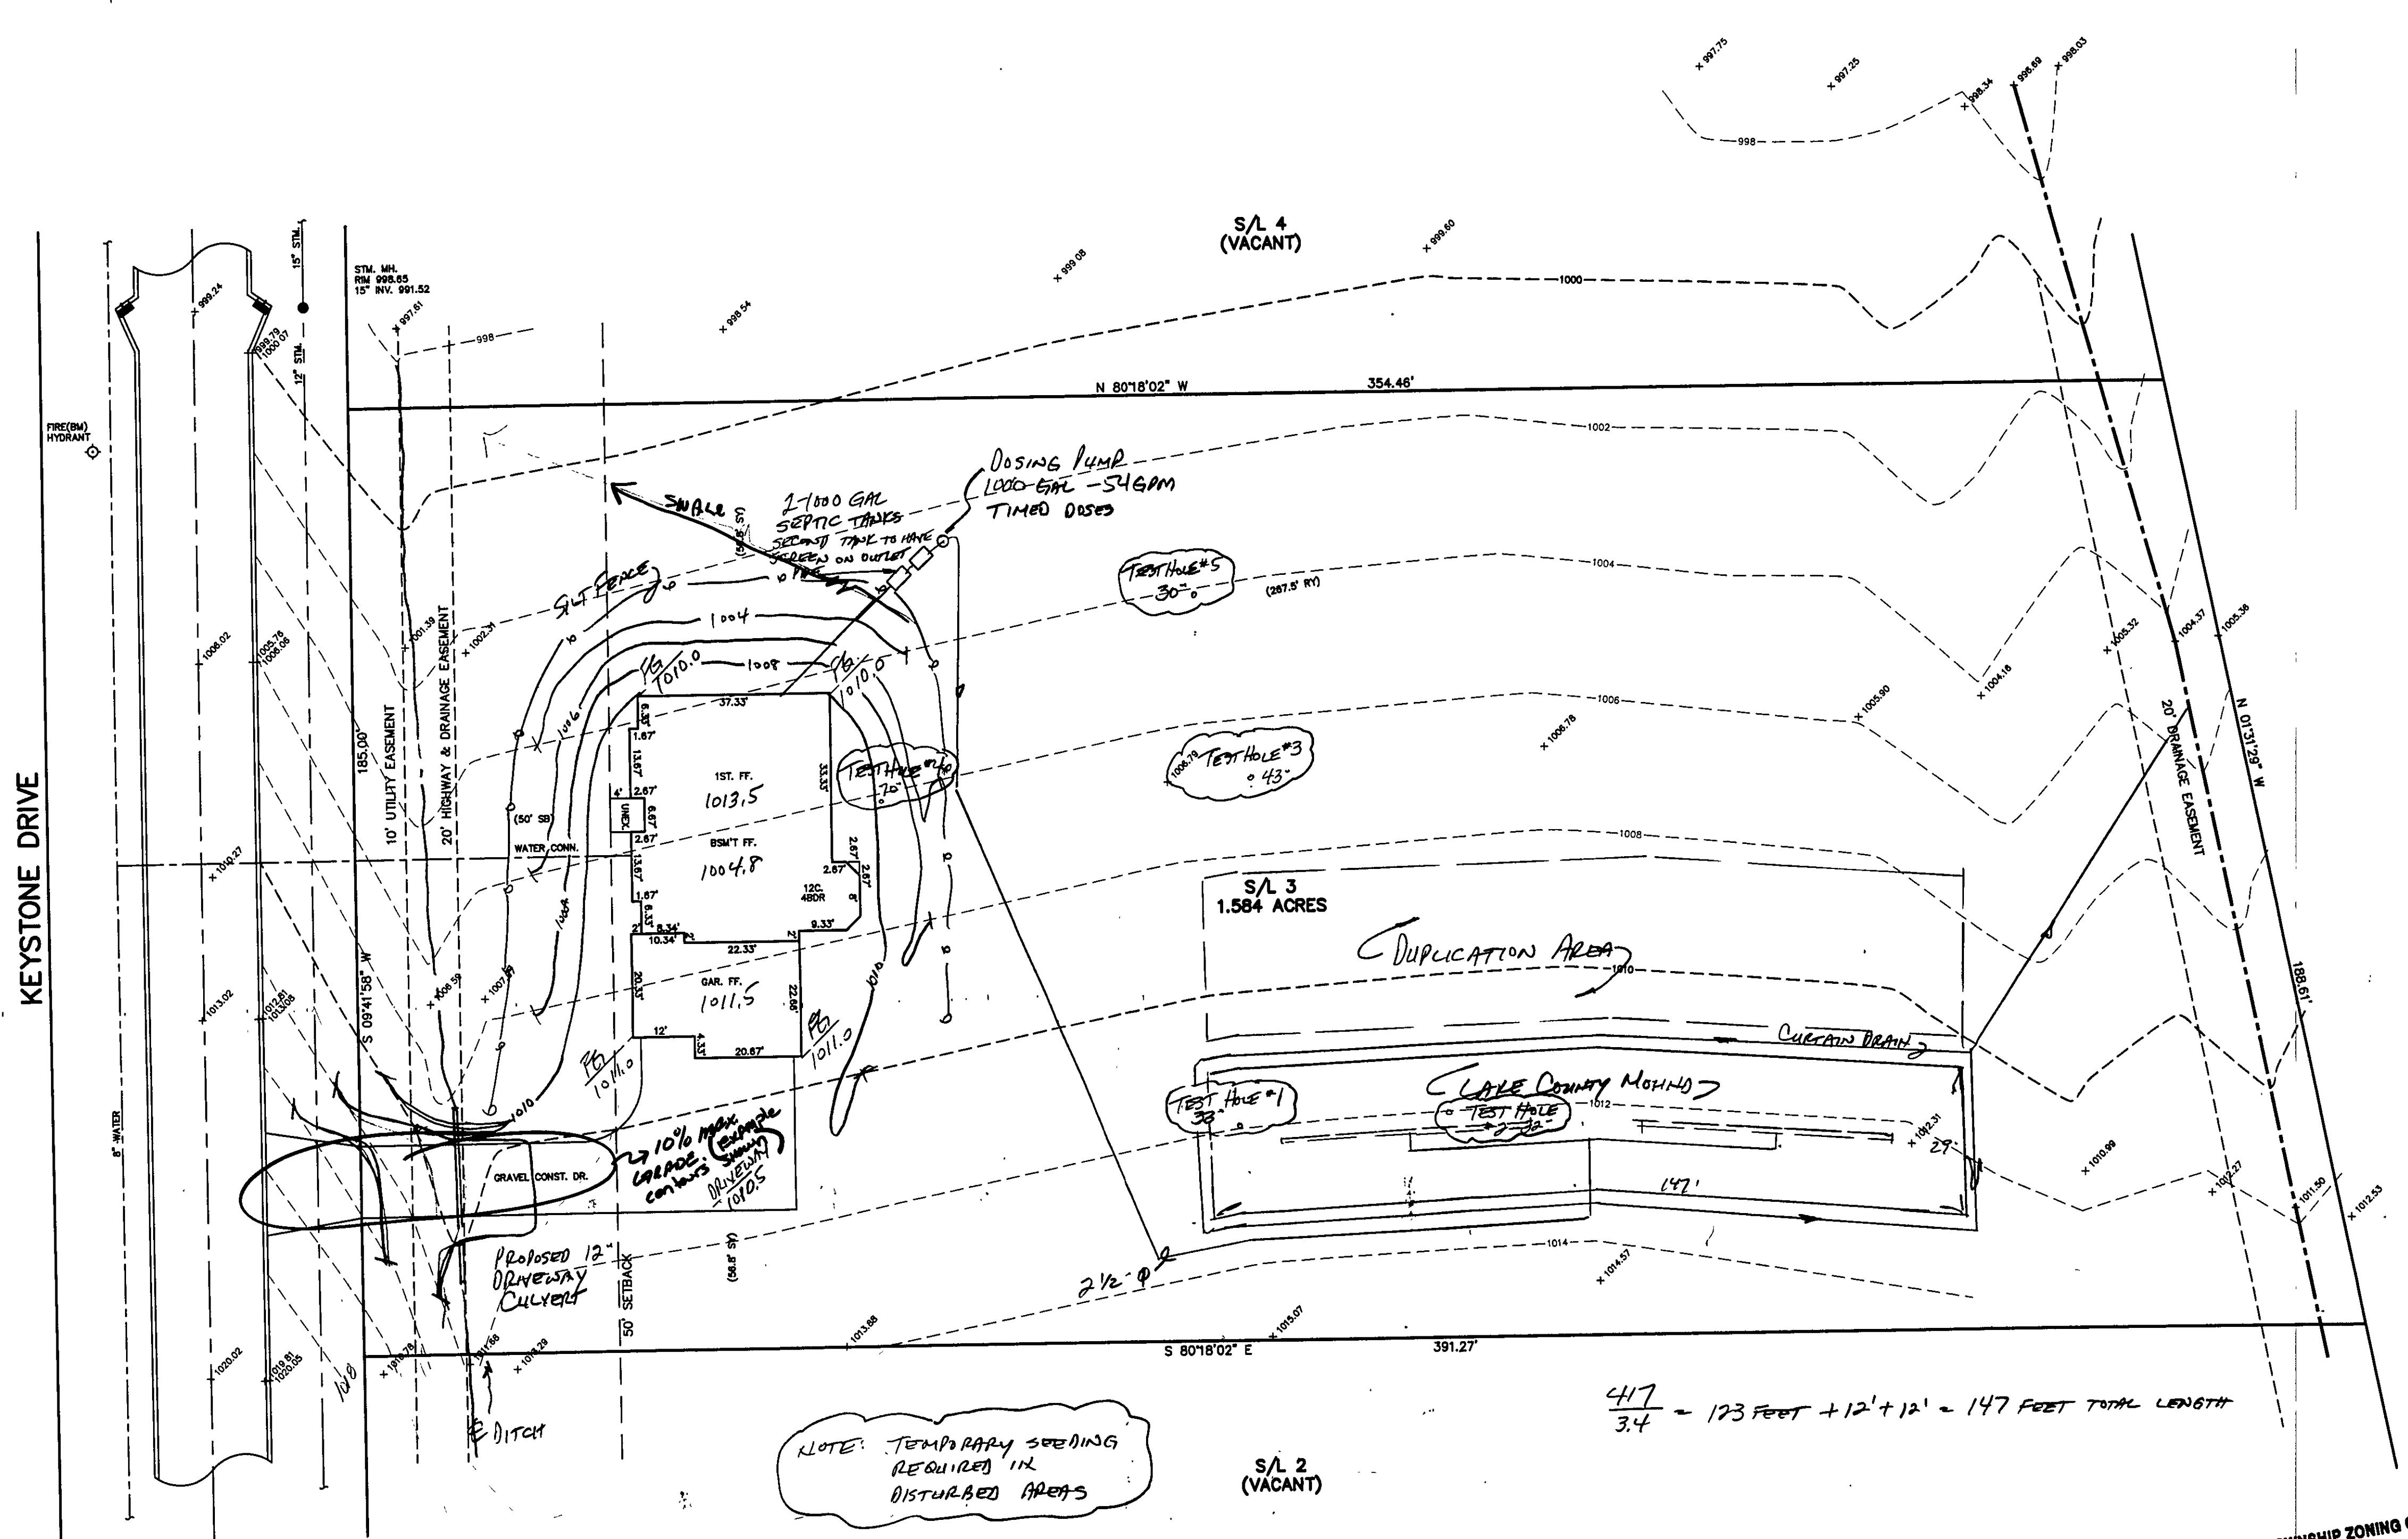

REVIEWED AND ACCEPTED
LAKE COUNTY GENERAL
HEALTH DISTRICT
Date 2-2-01 BY dal

SEWAGE DISPOSAL PERMIT MUST BE
OBTAINED BY A LAKE COUNTY LICENSED
INSTALLER BEFORE INSTALLATION IS
STARTED

NOTE: TEMPORARY SEEDING
REQUIRED IN
DISTURBED AREAS

417
3.4 = 123 FEET + 12' + 12' = 147 FEET TOTAL LENGTH

Grading Plan Approved
as shown and/or noted
JAMES R. GILLS, P.E.
Lake County Engineer

By TAM Date 2/8/01

1. Swale as shown
2. 10% maximum driveway grade
3. ROOF DRAINS
SHALL DISCHARGE
TO SPLASH BLOCKS.


CONCORD TOWNSHIP ZONING OFFICE
ZONING PERMIT # 0201-10028
ISSUED 2/6/2001
SUBJECT TO APPROVAL BY:

- ☐ Lake Co. Sanitary Engineer
- ☒ Lake Co. Eng. Dept.
- ☐ Lake Co. Planning Comm.
- ☐ Lake Co. Building Dept.
- ☒ Lake Co. Soil & Water Cons. Dist.

"I, the undersigned hereby certify that
this topography indicated by 6", 1", or 2"
contours, and elevations shown hereon
represent an actual field survey made by
me on the 14th day of Nov., 2000
and that the elevations were taken at
appropriate intervals and that as of that
date they existed as indicated hereon."

Name Harry Jones #16343
Reg. No.

BM-TOP OF HYDRANT
ELEV.=1004.49

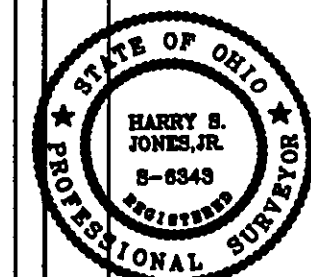

REV. NO.	DESCRIPTION	DATE	BY	CHK'D
1	REVISED MOUND	2/1/01	HJ	HJ

BABCOCK, JONES AND ASSOCIATES, INC.
CIVIL ENGINEERS - SURVEYORS - LAND PLANNERS
PAINESVILLE OHIO 44077

DATE 12/17/00
DESIGN BY H.J.
DRAWN BY T.R.
APPROVED BY H.J.

SITE PLAN
FOR
M.B. HOMES, INC.
S/L 3 WOODCREST SUBDIVISION
CONCORD TOWNSHIP LAKE COUNTY

SCALE 1"=20'
JOB NO. 99-166-03
SHEET 2 OF 2