


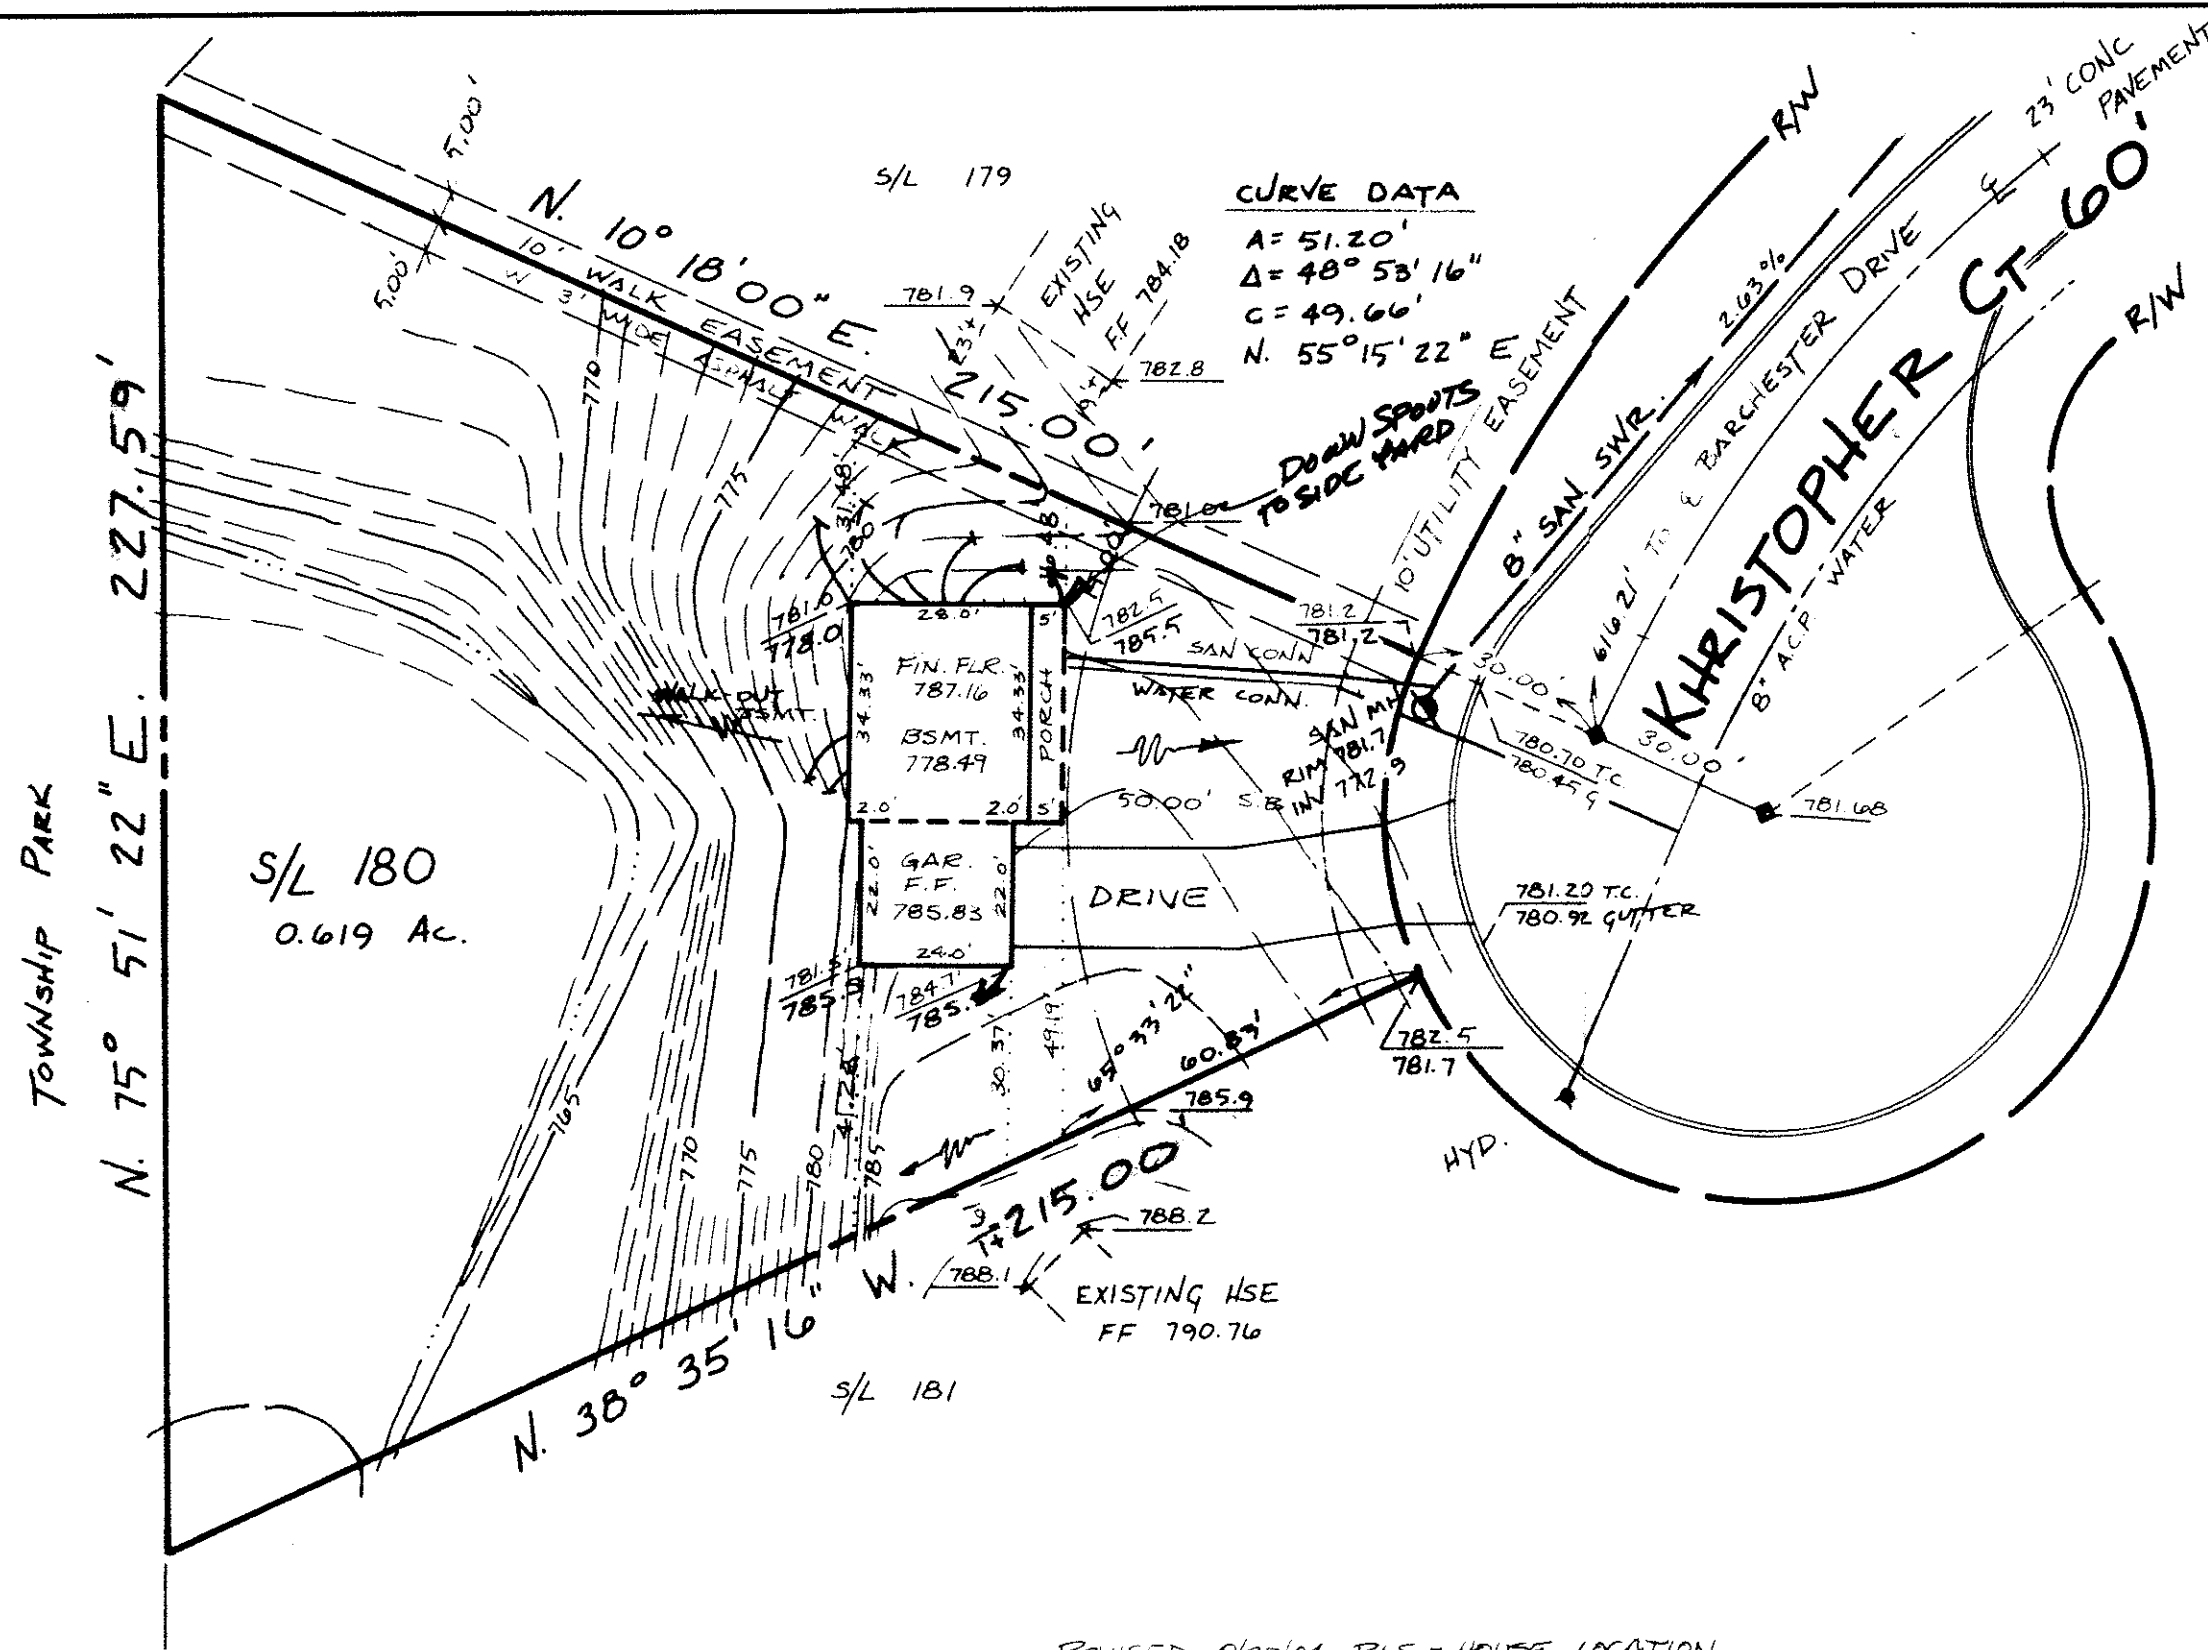

2P# 4710
REVISED

ZONING PERMIT #4918
ISSUED 8-24-84

SUBJECT TO APPROVAL BY:
 Lake County Sanitary Eng. ☐
 Lake County Eng. Dept. ☒
 Lake County Planning Comm. ☐
 Lake County Bldg. Dept. ☒

Teno J. Marano

Grading Plan Approved
as shown and/or noted
THOMAS P. GILLES, P.E.
Lake County Engineer

By D. Mitchell Date 8-24-84

BENCHMARK - TOP SAN MH. S/L 180
ELEV. 781.68

REVISED 8/23/84 RLS - HOUSE LOCATION

DESIGN CERTIFICATION

THIS PLAT WAS PREPARED BY ME,
AND IS CORRECT TO THE BEST OF
MY KNOWLEDGE AND BELIEF.

AS BUILT CERTIFICATION

I HEREBY CERTIFY THAT THE CIRCLED GRADES
ARE EXISTING FINISH GRADES CHECKED IN THE
FIELD ON _____ AND THAT
SURVEY IS CORRECT TO THE BEST OF MY
KNOWLEDGE AND BELIEF.



COLPETZER · WOODS
CONSULTANTS, INC.

9470 MENTOR AVENUE • MENTOR, OHIO 44066 • (216) 357-7569

DATE 6/1/83

SCALE $1'' = 30'$

DRAWN BY B.M.M

CHKD BY

JOB NO 83-456

FB PG 133

SITE PLAN

for KEN SOWUL

S/L 180 CONCORD HILLS SUBDIVISION N^o 4
ORIGINAL LOTS 22, 23, 28, 29 CONCORD TWP.
LAKE COUNTY, OHIO

REG. SURVEYOR NO

REG. SURVEYOR NO.

5239-3-40