



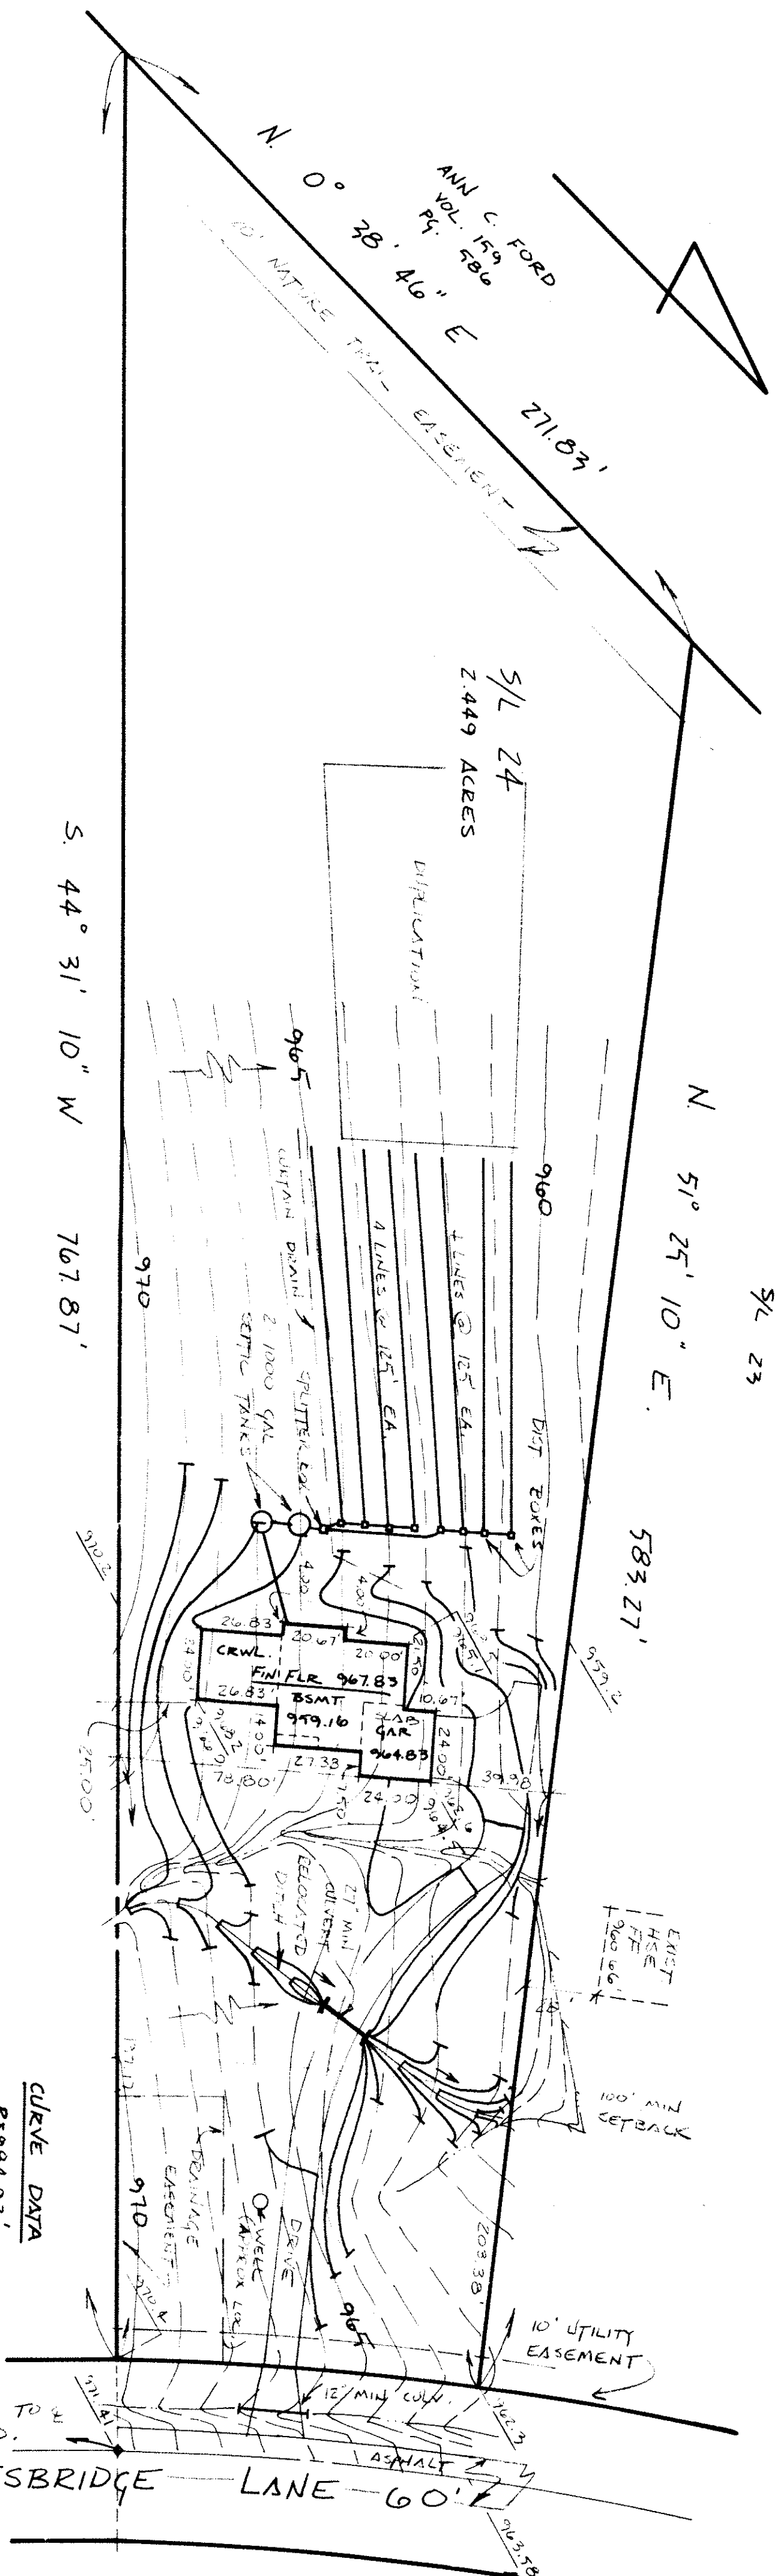

CURVE DATA
R=984.93'
A=118.61'
Δ=60°54'00"
C=118.54'
S 42° 01' 50" E.

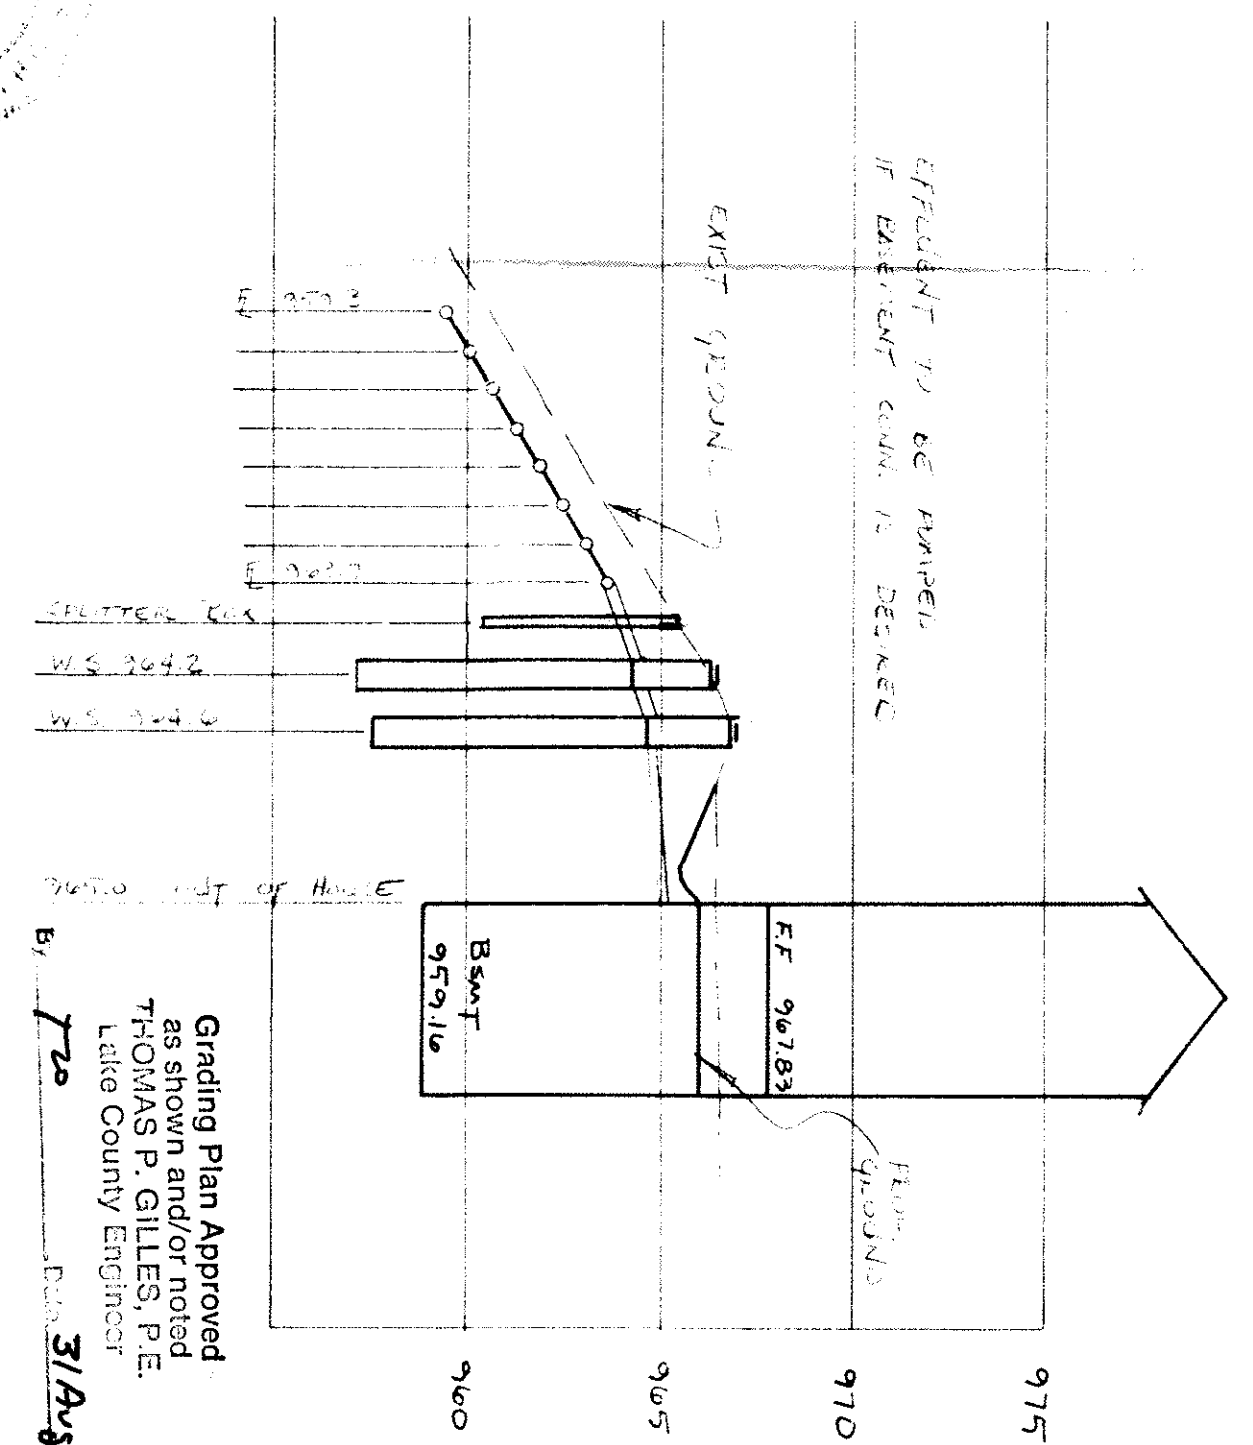

TRENCH DETAIL
ZONING PERMIT #4697
ISSUED 8-29-83
SUBJECT TO APPROVAL BY:
Lake County Sanitary Eng. ☐
Lake County Eng. Dept. ☒
Lake County Planning Comm. ☐
Lake County Bldg. Dept. ☒
Tens & Mearns MARC NGL IN 20"
SURFACE TEE 5770 55' BT 968.44

HYDRAULIC PROFILE
1"=40' HORIZ
1"=5' VERT.

Site Plan
FOR BETTELEY BUILDERS

S/L 24 KNIGHTSBRIDGE SUB'D N# 1 VOL. Y P4 52
CONCORD TOWNSHIP, LAKE COUNTY, STATE OF OHIO

COLPETZER WOODS
CONSULTANTS, INC.
MENTOR, OHIO 44060

DESIGN CERTIFICATION
THIS PLAN WAS PREPARED BY ME AND IS CORRECT TO THE BEST OF MY KNOWLEDGE AND BELIEF.
Thomas P. Gilles, P.E.
REG. SURVEYOR NO. PS 25244

AS BUILT CERTIFICATION
I HEREBY CERTIFY THAT THE CIRCLED GRADES ARE EXISTING FINISH GRADES CHECKED IN THE SURVEY'S CORRECT TO THE BEST OF MY KNOWLEDGE AND BELIEF.
REG. SURVEYOR NO.

DATE 8-2-83
SCALE 1"=40'
DRAWN BY EJA
CHKD BY
F.B.# 4471 PG.

8208

SHEET 1 OF 1

CONTRACT NO. 83-225