


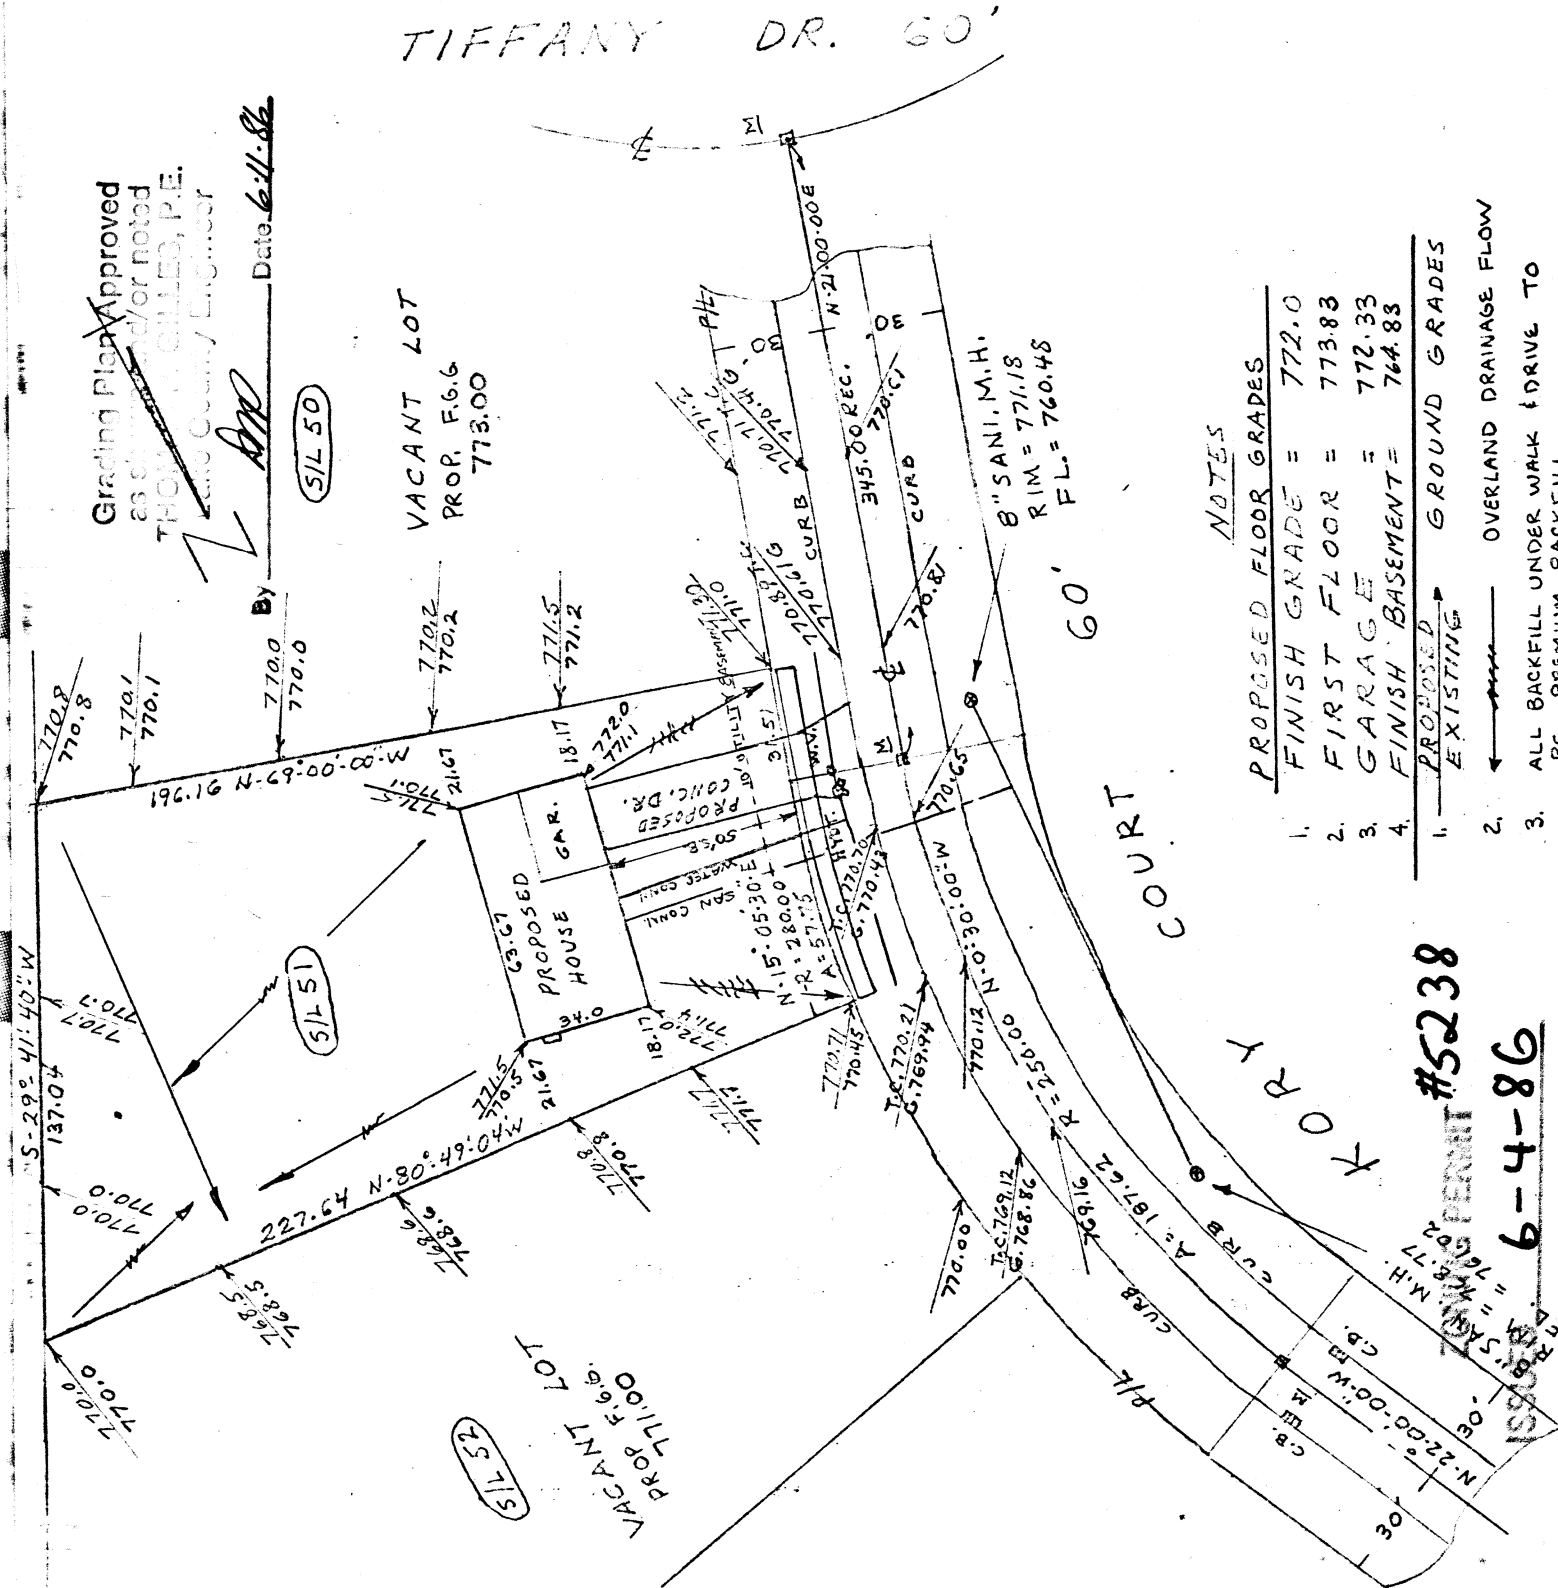

- NOTES**
- | PROPOSED FLOOR GRADES | PROPOSED GROUND GRADES |
|-----------------------------|---|
| 1. FINISH GRADE = 772.0 | 1. OVERLAND DRAINAGE FLOW |
| 2. FIRST FLOOR = 773.83 | 2. ALL BACKFILL UNDER WALK & DRIVE TO BE PREMIUM BACKFILL |
| 3. GARAGE = 772.33 | 3. BENCH MARK TOP HYD. FRONT OF 9/4-51 ELEV. 773.81 |
| 4. FINISH BASEMENT = 764.83 | 5. HYDRANT TO BE RELOCATED OUT OF DRIVE APRON |

SUBJECT TO APPROVAL BY:
Lake County Survey Eng. ☐
Lake County Eng. Dept. ☒
Lake County Planning Comm. ☐
Lake County Eng. Dept. ☒

STEVEN VANJO - SIL 51 - LANCASTER RIDGE SUB. NO. 5
ORIGINAL CONCORD TOWNSHIP LOT NO. 29 TRACT NO. 4.
CONCORD TOWNSHIP, LAKE COUNTY, OHIO.

SCALE 1" = 50'
MARCH 29-1986

Peter J. Knezovic
REGISTERED OHIO SURVEYOR - 4499.
WICKLIFFE, OHIO.

