

**SITE PLAN**

Calvin Township Lake County, Ohio  
 for: RL Moore Builders, Inc.  
 CLIENT OWNER

ADDRESS STREET CITY ZIP

DATE: 10-22-90  
 SURVEYOR: Harry S. Jones, Jr.  
 SHEET NO. 1 OF 1

**LEGEND**

○	WATER VALVE (GAS)	---	INDICATES DIRECTION OF SURFACE DRAINAGE
●	WATER METER (GAS)	---	
○	AS BUILT ELEVATION	---	
○	HYDRANT	---	
○	EXISTING CONTOURS	---	
○	PROPOSED CONTOURS	---	
○	EXIST. ELEV.	---	
○	PROP. ELEV.	---	

**REMARKS**


ALL BOUNDARY DATA SHOWN WAS OBTAINED FROM DEEDS, RECORDED SUBDIVISION PLAT OR OTHER PUBLIC RECORDS.

LOCATIONS AS SHOWN OF ADJACENT WELLS AND SEPTIC TANKS OBTAINED FROM LAKE COUNTY HEALTH DEPARTMENT

**DESIGN CERTIFICATION**

THIS PLAN WAS PREPARED BY ME, AND IS CORRECT TO THE BEST OF MY KNOWLEDGE AND BELIEF.

NAME: Harry S. Jones, Jr.  
 SURVEYOR REGISTRATION NO. 5-6343

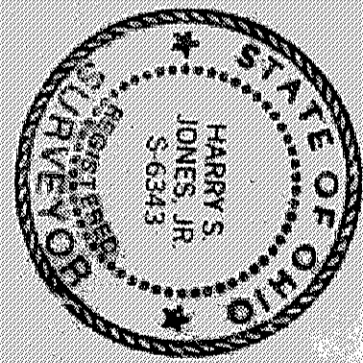

**CHECK LIST**

NO. OF BEDROOMS	WATER MAIN SIZE, LOCATION
DIMENSIONS	SAN. SEWER SIZE % GR. LOC.
BEHINDINGS	SAN. MH, CAST. ELEV., INV., ELEV.
THE TO NEAREST STREET	SAN. CONN. SIZE, LOC. DEPTH
SUBJECT NO. PARCEL NO.	STORM SEWER SIZE % GR. LOC.
SURROUNDING OWNERS	STORM MH, CAST. ELEV., INV., ELEV.
BLDG. DIMENSIONS FIN. OR	PAV'T TYPE, GRADE CURVES
BLDG. TIEB. FLR. GRADIES	GAS LINE LOC. SIZE PRESSURE
ADJACENT TYPE WIDTH THICKNESS	SEPTIC TANK LOCATION, DUPLICATION AREA
BIDENVALT TYPE WIDTH THICKNESS	WELL LOCATION
HOOK OUTSTROPPINGS	ISOLATION RADIUS FROM WELL

**REVISIONS**

NO.	DATE	BY
1		
2		
3		
4		
5		

**PLAN PREPARED BY:**  
 BABCOCK • JONES & ASSOCIATES, INC.  
 PAINESVILLE, OHIO

DRAWN BY: [Signature] SCALE: 1" = 30' PHONE NO. 357-1811  
 CHK'D. [Signature] DATE: 10/22/90 DRAWING NO. 18-188-08  
 CREW CHIEF: [Signature] APP'D. [Signature]

"AS BUILT" CERTIFICATION

I, HEREBY CERTIFY THAT THE CIRCLED GRADES ARE EXISTING FINISH GRADES CHECKED IN THE FIELD ON 10/22/90 AND ARE CORRECT TO THE BEST OF MY KNOWLEDGE AND BELIEF.


REGISTERED SURVEYOR REG. NO. \_\_\_\_\_

TSM - L.M. SMITH - SL 89  
 ELEV. = 892.53

ZONING PERMIT # 6353  
 ISSUED 1-30-90

SUBJECT TO APPROVAL BY:  
 Lake County Sanitary Eng.  
 Lake County Eng. Dept.  
 Lake County Planning Comm.  
 Lake County Bldg. Dept.

Dino J. Marano

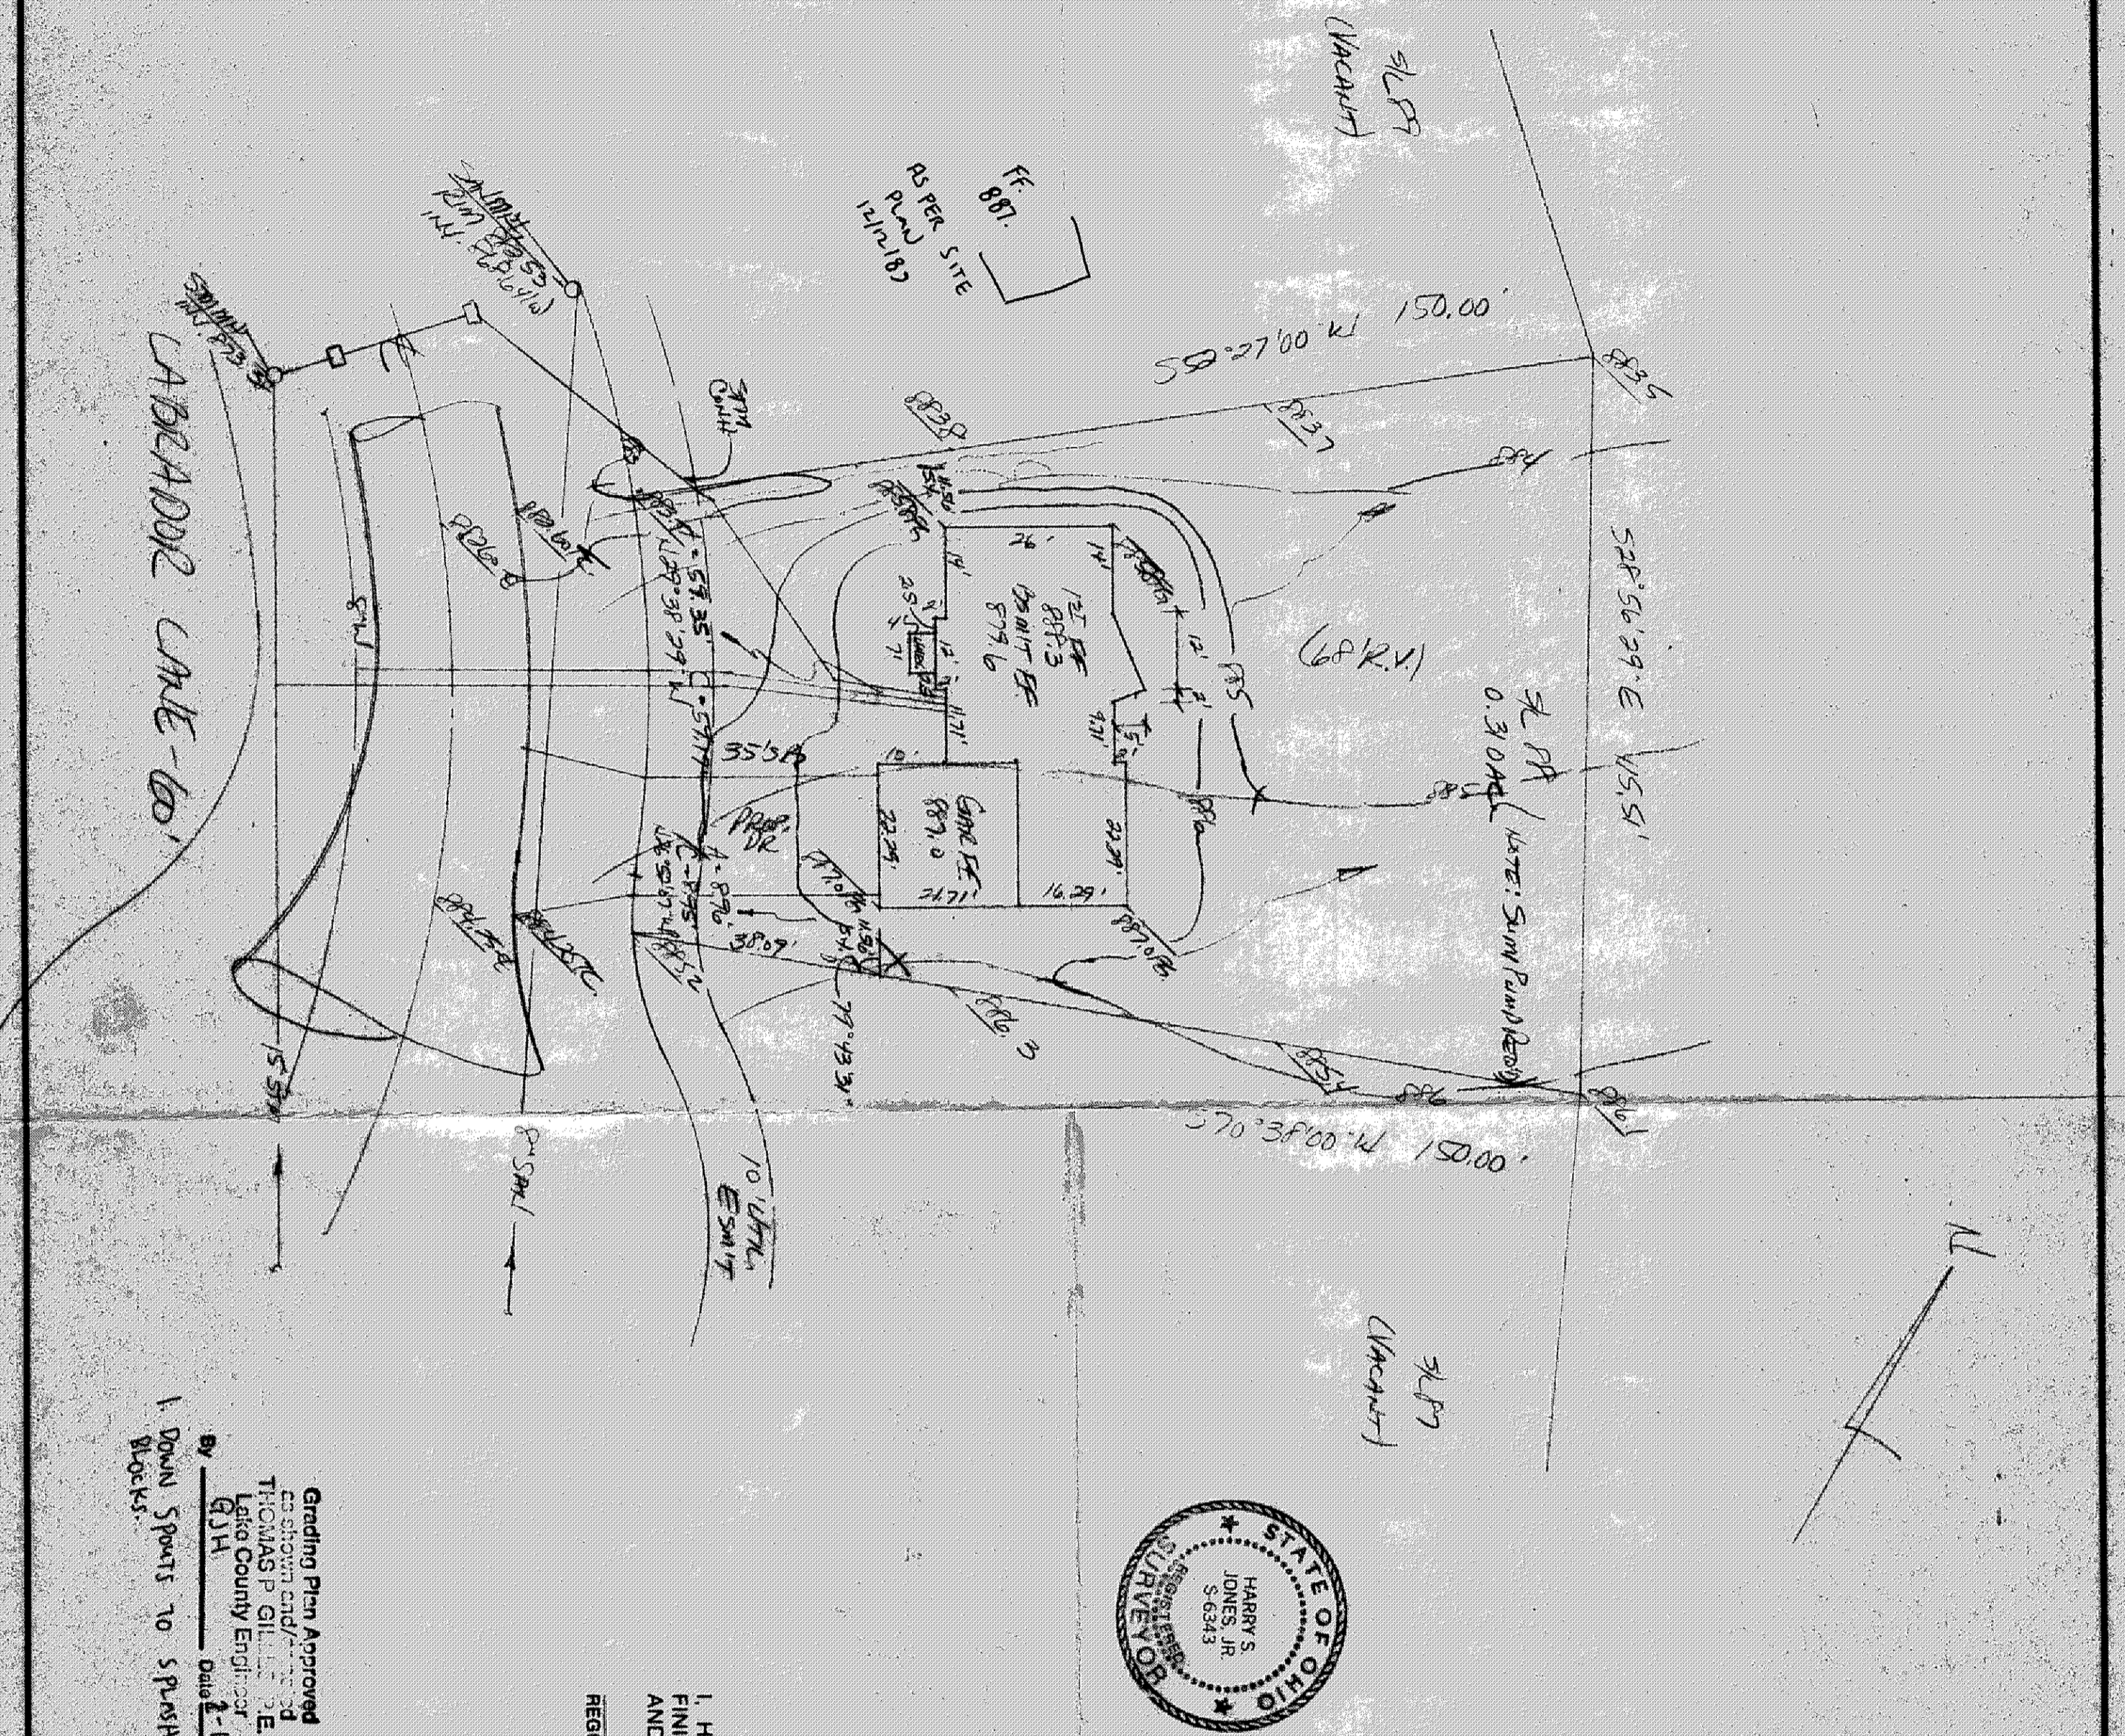

Grading Plan Approved  
 as shown and/...  
 THOMAS P. GILL...  
 Lake County Engineer  
 Date 1-1-90

1. Down Spouts to Splash Blocks.