


Grading Plan Approved
as shown and/or noted
THOMAS P. GILLES, P.E.
Lake County Engineer

By TAM Date 7/20/99
Lower F.G. as NOTED
Same as shown

ROOF DRAINS
SHALL DISCHARGE
TO SPLASH BLOCKS.

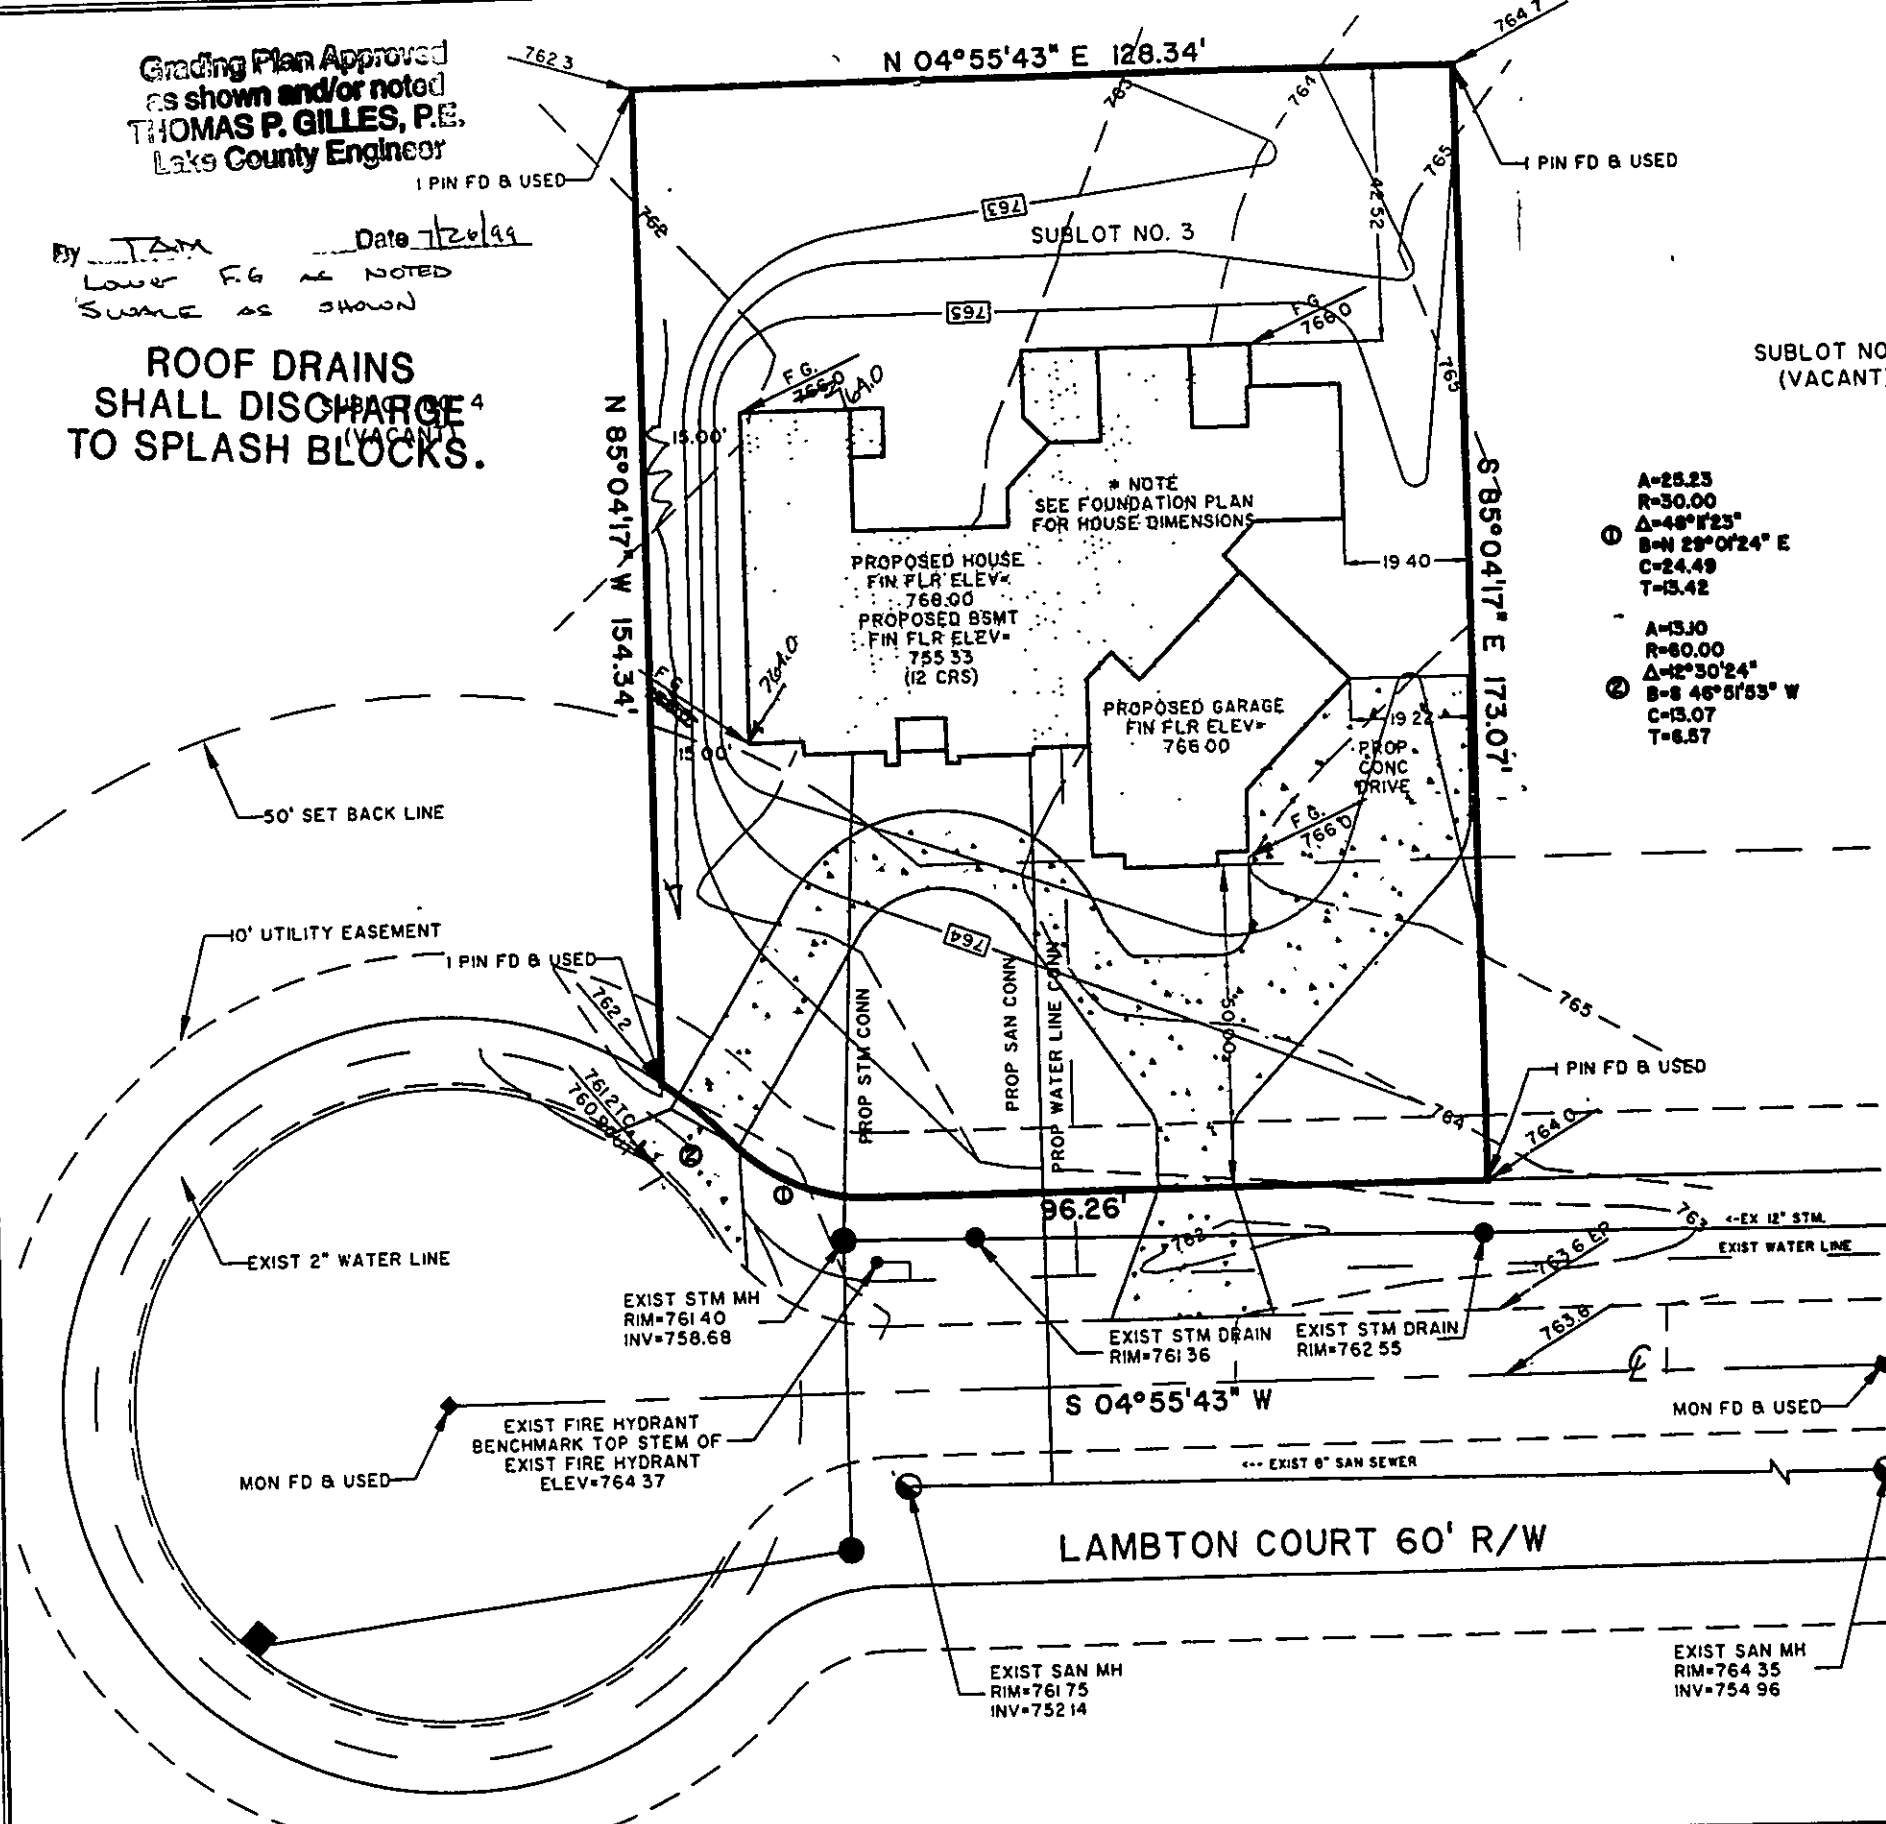

ZONING PERMIT #0799. 9500

ISSUED 7/23/99

SUBJECT TO APPROVAL BY:
Lake County Sanitary Eng. ☐
Lake County Eng. Dept. ☒
Lake County Planning Comm. ☐
Lake County Bldg. Dept. ☒



GENERAL NOTES:

1. DRIVEWAY APRON TO BE 6" THICK
2. BENCHMARK - TOP STEM OF FIRE HYDRANT LOCATED IN FRONT OF SUBLOT No. 3, ELEV. = 764.37

LEGEND

- EXISTING CONTOUR
- PROPOSED CONTOUR
- EXISTING ELEVATION
- PROPOSED ELEVATION

CERTIFICATION

"I THE UNDERSIGNED HEREBY CERTIFY THAT THIS TOPOGRAPHY INDICATED BY '1' CONTOURS AND ELEVATIONS SHOWN HEREON REPRESENTS AN ACTUAL SURVEY MADE BY ME ON THE 15TH DAY OF JUNE, 1999 AND THE ELEVATIONS WERE TAKEN AT APPROPRIATE INTERVALS AND AS OF THAT DAY THEY EXISTED AS INDICATED HEREON.

"I HEREBY CERTIFY THAT THIS PLAN WAS PREPARED BY ME AND IS CORRECT TO THE BEST OF MY KNOWLEDGE"


David W. Novak
DAVID W. NOVAK, P.S. No. 7507

GRAPHIC SCALE



(IN FEET)
1 inch = 30 ft.

REV	DESCRIPTION	DATE	BY	CHK'D
A	REVISED HOUSE	07/22/99	DWN	

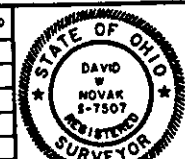

Himebaugh and Novak
Surveyors and Site Consultants
38342 Western Parkway, Unit 10
Willoughby, Ohio 44094
(440) 946-1761, (440) 918-0486 Fax.

THE ROSS RESIDENCE
6380 KING MEMORIAL ROAD, MENTOR, OH. 44060

DATE:	JUNE 15, 1999
DRAWN BY:	C.R. KRAFT
CHECKED BY:	DWN
APPROVED BY:	

SITE PLAN
SUBLOT NO. 3 LAMBTON COURT, CONCORD, OH. 44077
STERLING HILLS SUBDIVISION

SCALES:	
HORIZ. 1" = 30'	
VERT. NONE	
CONTRACT NO.	
99071	
SHEET NO.	OF