

Grading Plan Approved  
as shown and/or noted  
THOMAS P. GILLES, P.E.  
Lake County Engineer

ZONING PERMIT # 0798-9/144

ISSUED 7-16-98

By GJH Date 7.28.98  
House cannot be built  
until plat is recorded.

SUBJECT TO APPROVAL BY:  
Lake County Sanitary Eng.   
Lake County Eng. Dept.   
Lake County Planning Comm.   
Lake County Bldg. Dept.



**GENERAL NOTES:**

1. DRIVEWAY APRON TO BE 6" THICK
2. BENCHMARK - TOP STEM OF FIRE HYDRANT LOCATED IN FRONT OF SUBLOT No. 3 , ELEV. = 764.37

**LEGEND**

- EXISTING CONTOUR
- PROPOSED CONTOUR
- EXISTING ELEVATION
- PROPOSED ELEVATION

**CERTIFICATION**

"I THE UNDERSIGNED HEREBY CERTIFY THAT THIS TOPOGRAPHY INDICATED BY 1' CONTOURS AND ELEVATIONS SHOWN HEREON REPRESENTS AN ACTUAL SURVEY MADE BY ME ON THE 24th DAY OF JUNE, 1998 AND THE ELEVATIONS WERE TAKEN AT APPROPRIATE INTERVALS AND AS OF THAT DAY THEY EXISTED AS INDICATED HEREON.


"I HEREBY CERTIFY THAT THIS PLAN WAS PREPARED BY ME AND IS CORRECT TO THE BEST OF MY KNOWLEDGE"

DAVID W. NOVAK, P.S. No. 7507

**GRAPHIC SCALE**



( IN FEET )  
1 inch = 30 ft.

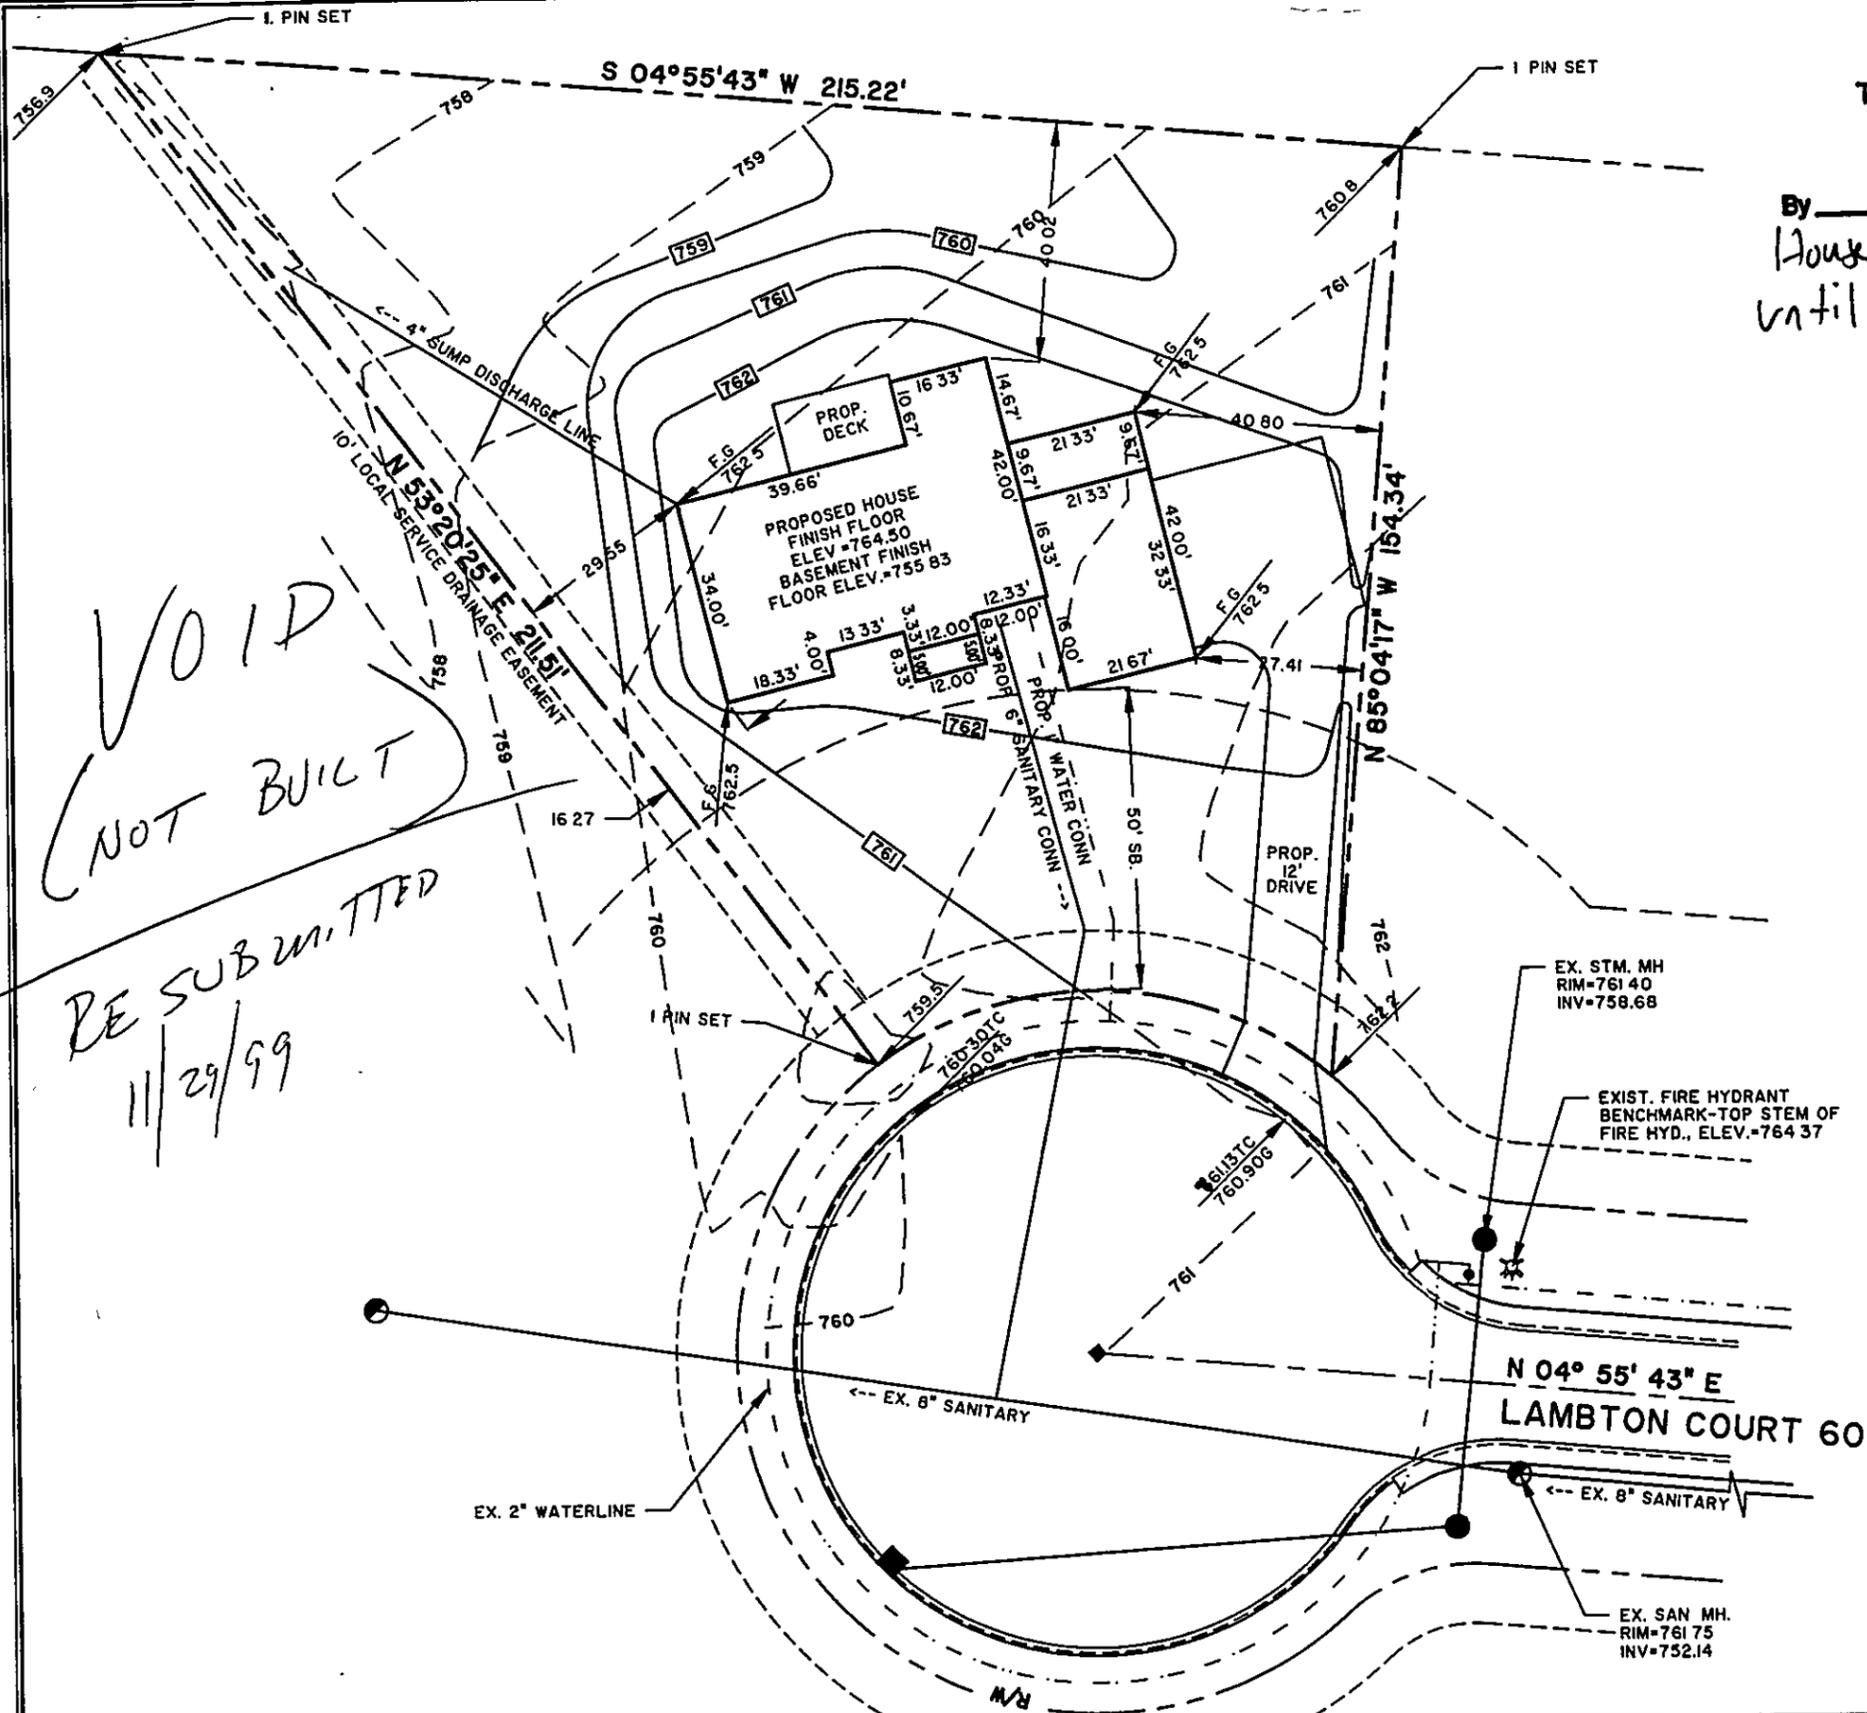

VOID  
NOT BUILT  
BE SUBMITTED  
11/29/99

REV No.	DESCRIPTION	DATE	BY	CHKD.
A	CHANGED HOUSE LOCATION	07/13/98	DWN	



**Himebaugh and Novak**  
Surveyors and Site Consultants  
38342 Western Parkway, Unit 10  
Willoughby, Ohio 44094  
(440) 946-1761, (440) 918-0486 Fax.

**JOHN RUPLE, INC.**  
9445 HEADLANDS RD., MENTOR, OH 44060

DATE	JULY 01, 1998
DRAWN BY	C.R. KRAFT
CHECKED BY	DWN
APPROVED BY	
P.E. No.	

**SITE PLAN**  
SUBLOT 4, STERLING HILLS, CONCORD

SCALE:	
HORIZ. 1" = 30'	
VERT. NONE	
CONTRACT No.	
98060-4	
SHEET No.	OF