

SITE PLAN

CONCORD TOWNSHIP, LAKE COUNTY, OHIO

FOR: J. H. BETTERLEY BUILDING

ADDRESS: STREET CITY ZIP

DATE: 10-16-89
BY: J. H. BETTERLEY
SHEET NO. 30

LEGEND

WATER VALVE (GAS)
WATER METER (GAS)
AS BUILT ELEVATION
INDICATES DIRECTION OF SURFACE DRAINAGE

REMARKS

ALL BOUNDARY DATA SHOWN WAS OBTAINED FROM IDEEDS, RECORDED
LAKESIDE PLAT OR OTHER PUBLIC RECORDS
LOCATIONS AS SHOWN OF ADJACENT WELLS AND SEPTIC TANKS OBTAINED FROM
LAKE COUNTY HEALTH DEPARTMENT

DESIGN CERTIFICATION

THIS PLAN WAS PREPARED BY ME, AND IS CORRECT
TO THE BEST OF MY KNOWLEDGE AND BELIEF

CHECK LIST

NO. OF BEDROOMS
NO. OF BATHS
NO. OF TOILETS
NO. OF SHOWER HEADS
NO. OF CATCH BASINS
EXISTING CONTOURS
PROPOSED CONTOURS
EXIST. ELEV.
PROV. ELEV.

WATER MAIN SIZE, LOCATION
SEWER SIZE, LOCATION
SAN. MAN. CAST. ELEV. INV. ELEV.
SAN. CORR. SIZE, LOC. DEPTH
STORM SEWER SIZE, LOC. DEPTH
STORM MAN. CAST. ELEV. INV. ELEV.
DRAIN TYPE, GRADE CURVES
SEPTIC TANK LOC. SIZE PRESSURE
WELL LOCATION
ISOLATION RADII FROM WELL

PLAN PREPARED BY:
BARCOCK & JONES & ASSOCIATES, INC.
PAINESVILLE, OHIO

NO. DATE BY
1 21/4/89
2 21/4/89
3 21/4/89
4 21/4/89
5 21/4/89

"AS BUILT" CERTIFICATION

I, HEREBY CERTIFY THAT THE CIRCLED GRADES ARE EXISTING
FINISH GRADES CHECKED IN THE FIELD ON 19
AND ARE CORRECT TO THE BEST OF MY KNOWLEDGE AND BELIEF.

REGISTERED SURVEYOR REG. NO.


Reviewed and Accepted
LAKE COUNTY GENERAL HEALTH DISTRICT
Date 3-16-89
JOEL LUDIA, R. S. M. P. H.
Health Commissioner

BY: J. H. BETTERLEY
LAKE COUNTY ENGINEER

Grading Plan Approved
as shown and/or noted
THOMAS P. JONES, JR.
LAKE COUNTY ENGINEER

BY: J. H. BETTERLEY
Date 2/1/89

LITTLE MOUNTAIN ROAD - CO.

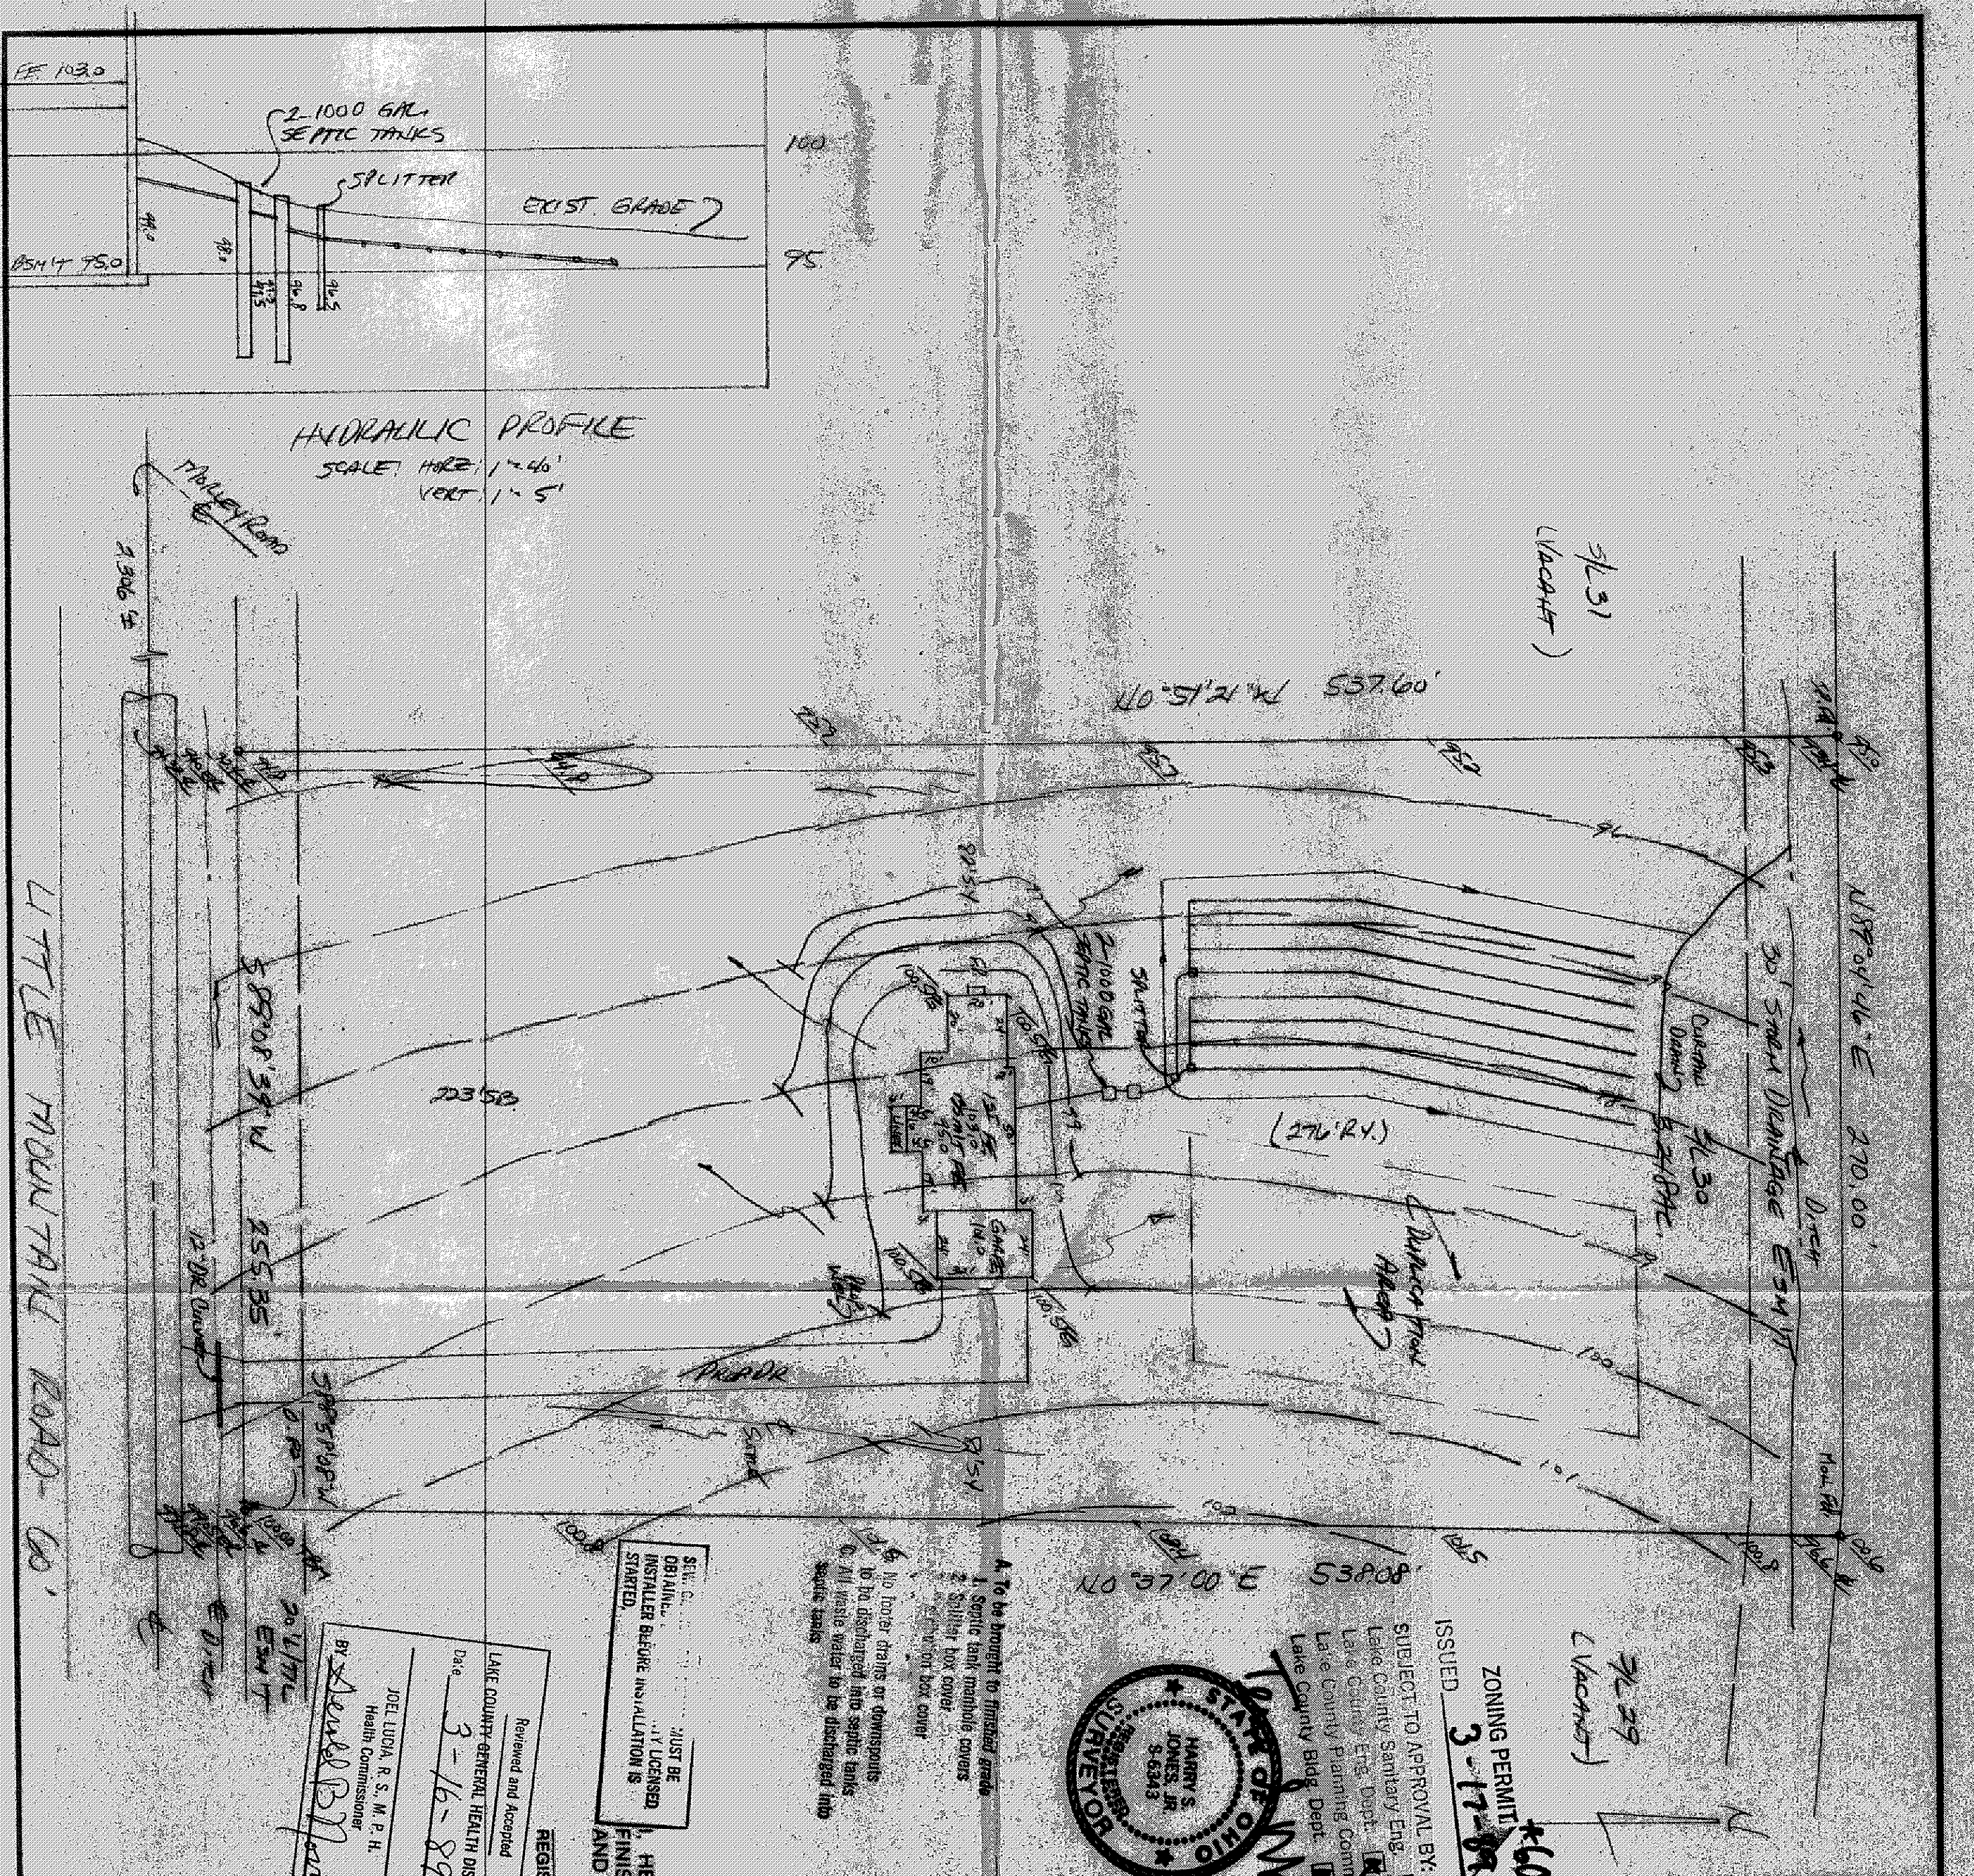

FF 103.0
ASH 17.50

HYDRAULIC PROFILE
SCALE: HORIZ. 1" = 40'
VERT. 1" = 5'

