


CONCORD TOWNSHIP ZONING OFFICE
Permit # 0605-17405
Issued 8/18/05
Subject to Approval by:
Lake Co. Engineering & Water Mgmt.
Lake Co. Utilities Dept.
Lake Co. Soil & Water District
Lake Co. Health District
Lake Co. Building Dept.

SHEET 1 OF 1


NOT TO SCALE

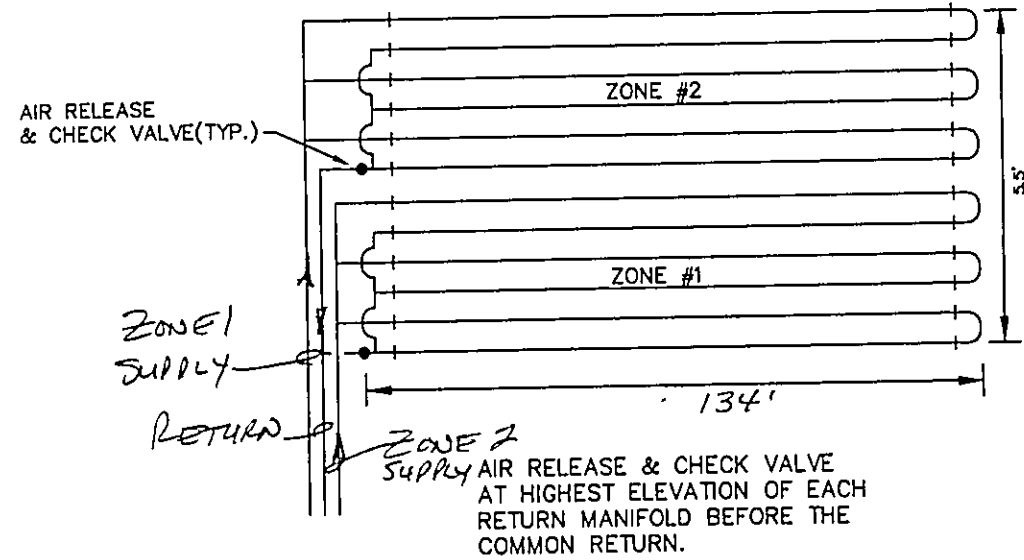

"I CERTIFY THIS SEWAGE SYSTEM DESIGN MEETS THE MINIMUM REQUIREMENTS ESTABLISHED BY THE LCGHD IN THE HSTS GUIDANCE MANUAL, AND THE REQUIREMENTS AND RECOMMENDATIONS OF THE SYSTEM MANUFACTURER."

Name: Harry S. Gills Reg. No. 56343

PARCEL 9

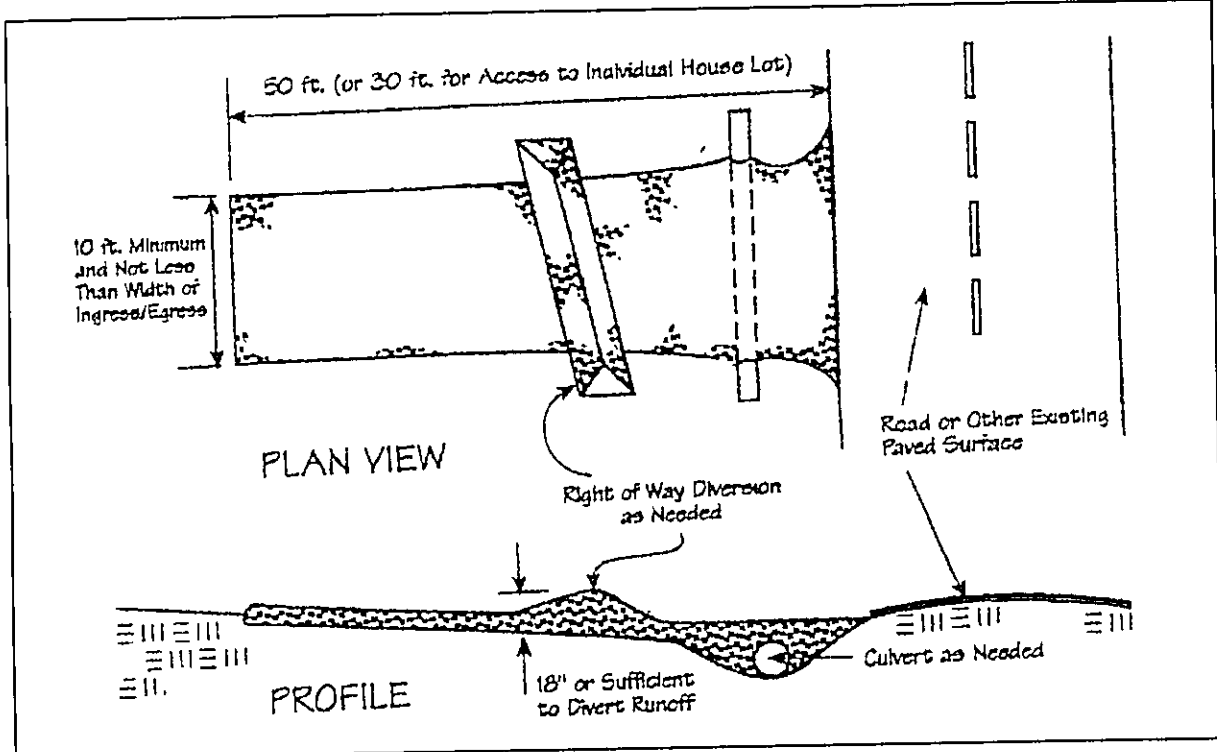

Erosion and Sediment Control Schedule

Ingress-Egress

A stone access drive complete with under lying geo-textile fabric (20 feet wide and 50 feet long) for ingress and egress at the site shall be installed. This drive shall be the only entrance and exit to the site.

Silt Fence

A silt fence shall be installed prior to any earthwork activities at the site in the locations shown on the site plan as well as along the front of any lot that slopes towards the street.

Temporary Seeding

Disturbed areas of the site that are to remain idle for more than thirty(30) days shall be properly seeded and straw mulched within seven(7) days of completion of initial grading. Temporary seeding and mulching as a thirty(30) foot strip of the entire front of the lot shall be maintained on the site once initial grading is complete.


Stabilization of critical areas within fifty(50) feet of any stream or wetland shall be complete within two(2) days of the disturbance if the site is to remain inactive for longer than fourteen(14) days.

Mulching

Straw-mulch shall be applied at a rate of 1 bale per every ten (10) feet of curb, at a width of thirty(30) feet to the entire length of the lot. Wood chips may also be used but must be spread at a minimum depth of four inches over the thirty-foot width and must be accompanied by a properly installed silt fence.

Maintenance


Erosion and sediment controls shall be inspected every seven(7) days or within 24 hours of a 0.5" or greater rainfall event. Necessary repairs shall be made at this time.

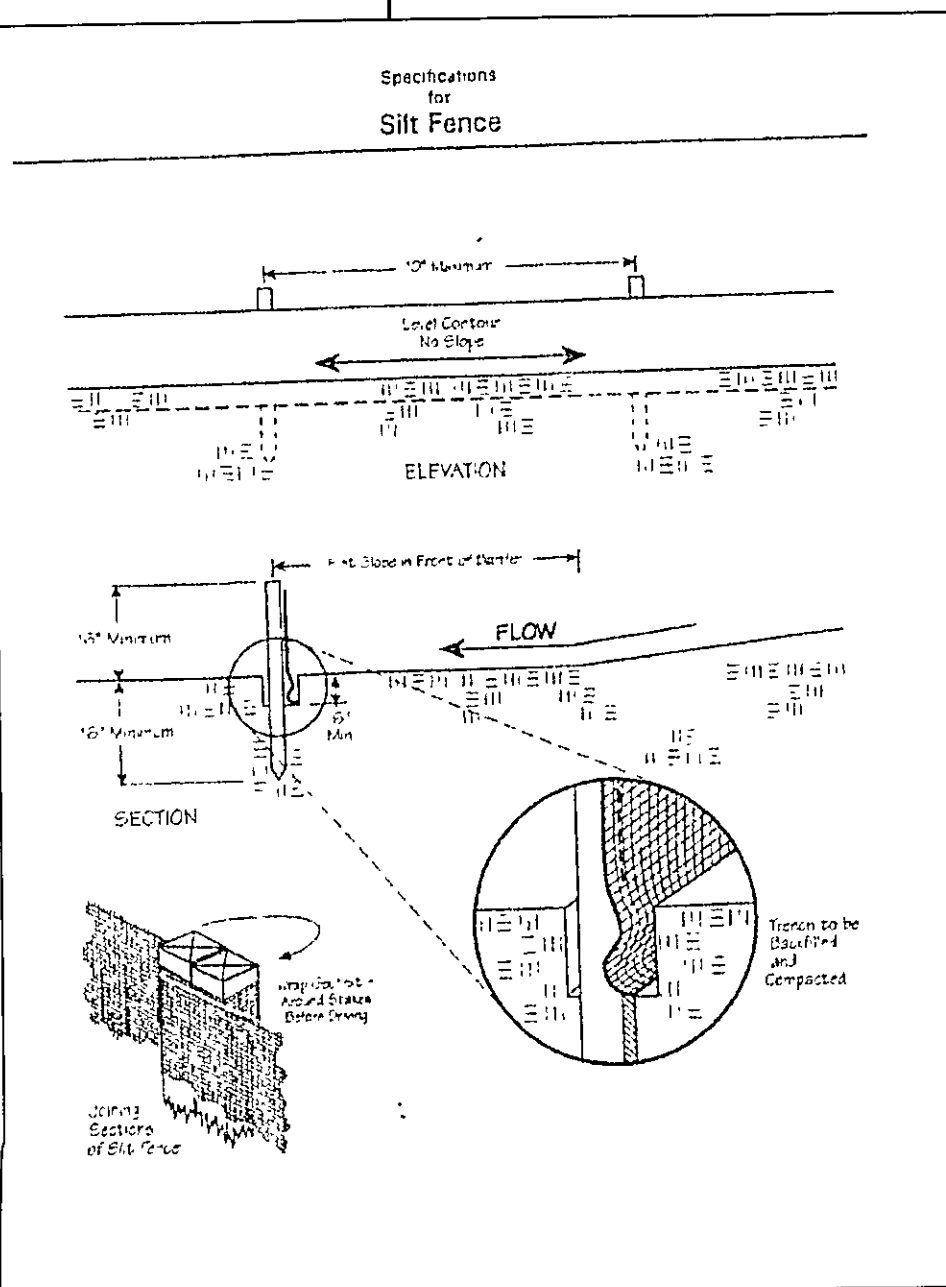

Drip Distribution Plan Submittal Review


Date	Items
7/1/05	Initial Review
8/18/05	Final Review
9/13/05	Final Review

Drip distribution area has been field verified and protected with marking tape

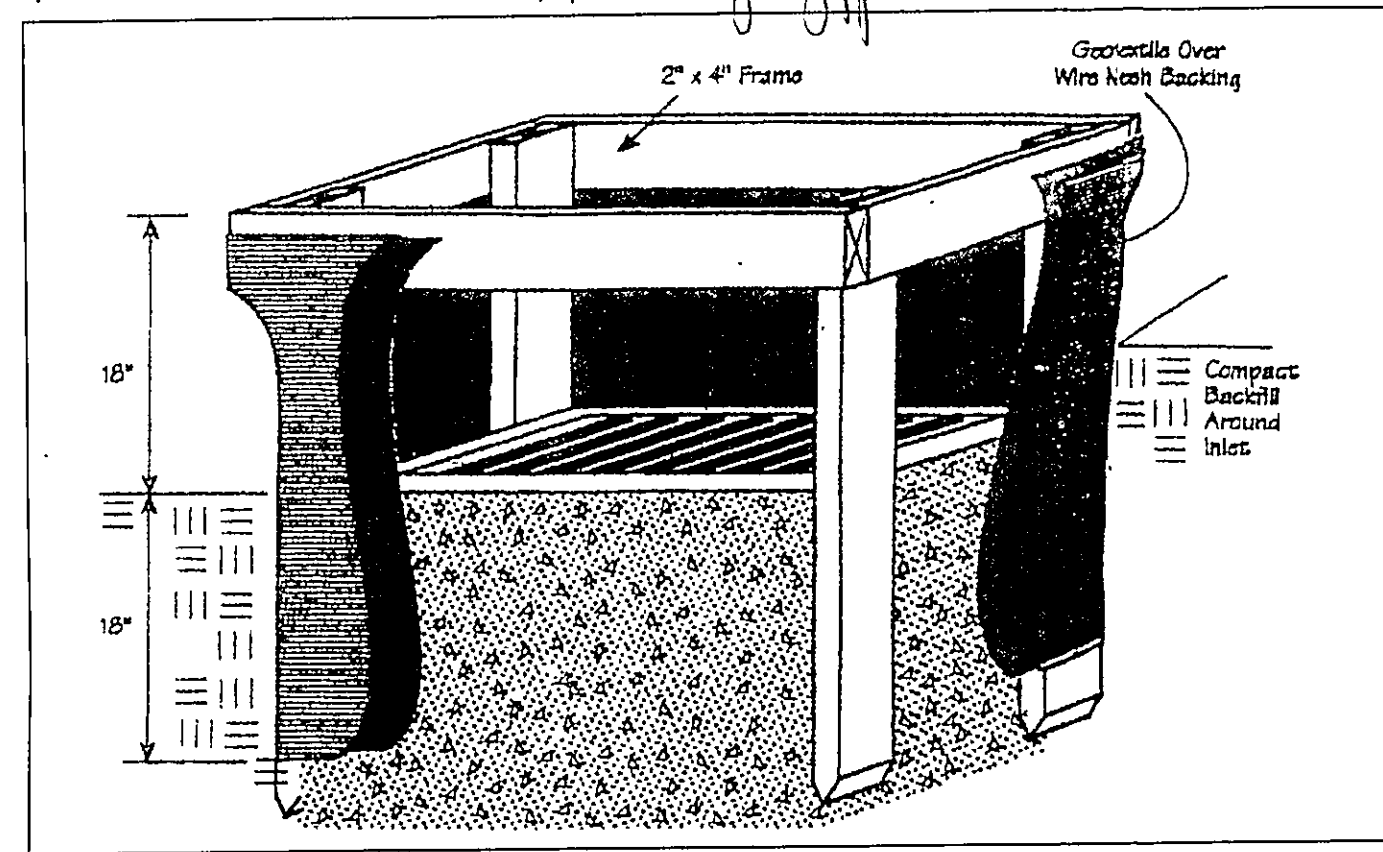

Temporary Seeding Species Selection			
Seeding Dates	Species	Lb./1,000 ft. ²	Per Ac
March 1 to August 15	Oats	3	4 bushel
	Tall Fescue	1	40 lb.
	Annual Ryegrass	1	40 lb.
	Perennial Ryegrass	1	40 lb.
August 16 to November 1	Rye	3	2 bushel
	Tall Fescue	1	40 lb.
	Annual Ryegrass	1	40 lb.
	Wheat	3	2 bushel
November 1 to Spring Seeding	Tall Fescue	1	40 lb.
	Annual Ryegrass	1	40 lb.
	Perennial Ryegrass	1	40 lb.
	Wheat	1	40 lb.

Note: Other approved seed species may be substituted.

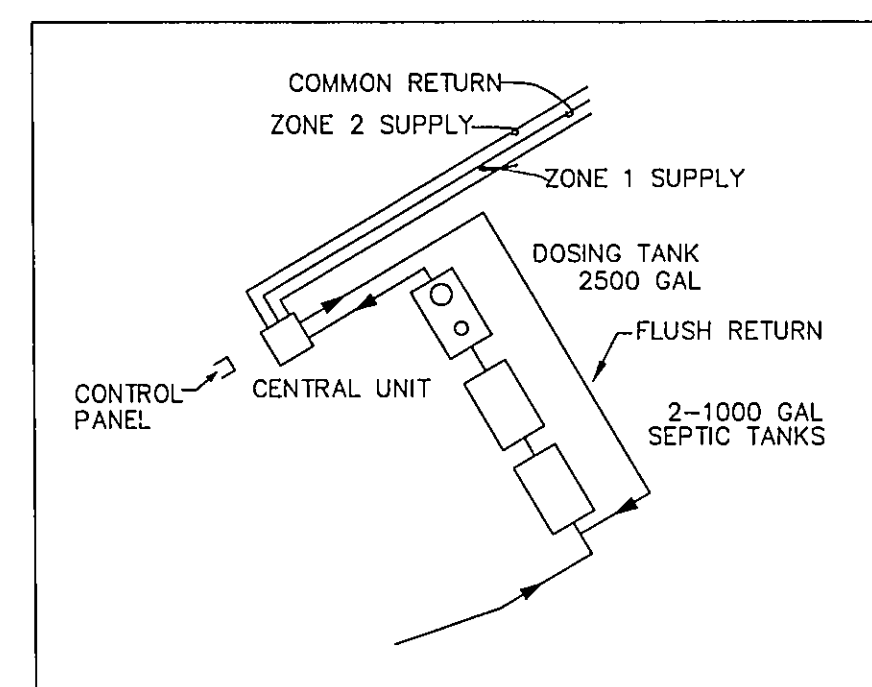

EXISTING UTILITIES NOTE: THE SIZE AND LOCATION, BOTH HORIZONTAL AND VERTICAL OF THE UNDERGROUND UTILITIES SHOWN HEREON, HAVE BEEN OBTAINED BY A SEARCH OF AVAILABLE RECORDS. BABCOCK, JONES & ASSOCIATES, INC. HAS CONDUCTED FIELD VERIFICATION BY FIELD OBSERVATION HAS BEEN CONDUCTED WHERE PRACTICAL, HOWEVER, BABCOCK, JONES & ASSOCIATES, INC. DOES NOT GUARANTEE THE COMPLETENESS NOR ACCURACY THEREOF.

Concord Township Water Management Plan
Approved as shown and/or noted
JAMES R. GILLS, P.E.
County Drainage Engineer
By A.S. Date 9/13/05

REV NO.	DESCRIPTION	DATE	BY	CHK'D
1	ADDED NEW HOUSE	7/18/05	B.P.	H.J.
2	REVISED LOCATION OF HSE	8/18/05	B.P.	H.J.
3	REVISIONS TO SITE PLAN	9/11/05	H.J.	H.J.
4	REVISIONS TO SITE PLAN	9/17/05	H.J.	H.J.
5	REVISIONS TO SITE PLAN	9/19/05	H.J.	H.J.



BABCOCK, JONES AND ASSOCIATES, INC
CIVIL ENGINEERS - SURVEYORS - LAND PLANNERS
PAINESVILLE OHIO 44077

DATE	1/22/05
DESIGN BY	H.J.
DRAWN BY	B.P.
APPROVED BY	H.J.
CREW CHIEF	E.H.

SITE PLAN
FOR
DAVID KNOTT
LITTLE MOUNTAIN ROAD (P.P.#10A-22E-14)
CONCORD TOWNSHIP LAKE COUNTY STATE OF OHIO

SCALE	1"=20'
JOB NO.	97-066-D
SHEET	1
OF	2

LITTLE MOUNTAIN ROAD - 60'