


RYAN HOMES
28600 MERCANTILE RD.
BEACHWOOD, OHIO

PREPARED BY:

WM. R. GRAY ASSOC. INC.
75 47 MENTOR AVE.
MENTOR, OHIO
DATE JULY 16, 1975
REV'D OCT 6, 1975
SCALE: 1" = 20'

REVISED
Grading Plan Approved
as shown and/or noted
THOMAS P. GILLES, P.E.
Lake County Engineer

JK 10-15-75

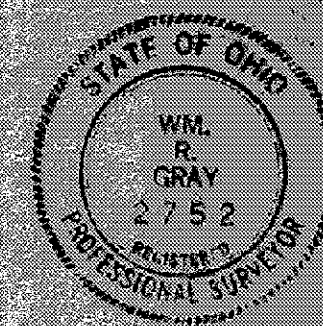

I HEREBY CERTIFY THAT
THIS PLAT IS CORRECT TO THE
BEST OF MY KNOWLEDGE.

BY: Wm. R. Gray (CMB)
WM. R. GRAY PERS. SURV # 2752

