

RYAN HOMES
23600 MERCANTILE
BEACHWOOD, OHIO
BEING SUBLOT NO 2. IN
THE MARTINIQUE ESTATES
SUBD. LOCATED IN CONCORD
TWP., OHIO.

W.M. R. GRAY ASSOC. INC.
7547 MENTOR AVE.
MENTOR, OHIO


DATE: July 23, 1975 SCALE 1"=20'
REV'D. July 28, 1975

I HEREBY CERTIFY
THAT THIS PLAT IS CORRECT
TO THE BEST OF MY KNOWLEDGE.

WM R. GRAY REG. SURV. #2752.



UTILITIES SHOWN ARE
SUBJECT TO AS-BUILT CONDITIONS.

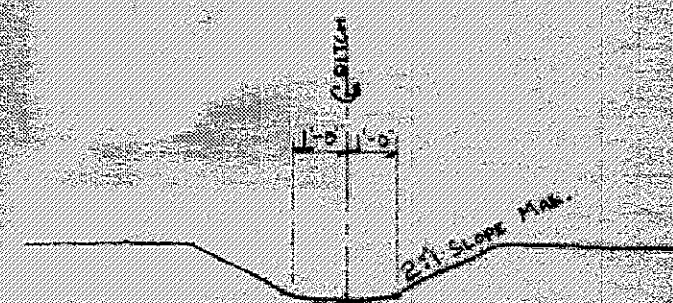

TYPICAL RD. DITCH SECTION
No SCALE



CURVE DATA

RAD. 300.00' A= 85.17'
CH. 84.89' S 76° 10' 27" E

REVISED
Grading Plan Approved
as shown and/or noted
THOMAS P. GILLES, P.E.
Lake County Engineer

Ex. gwk Date 7-28