


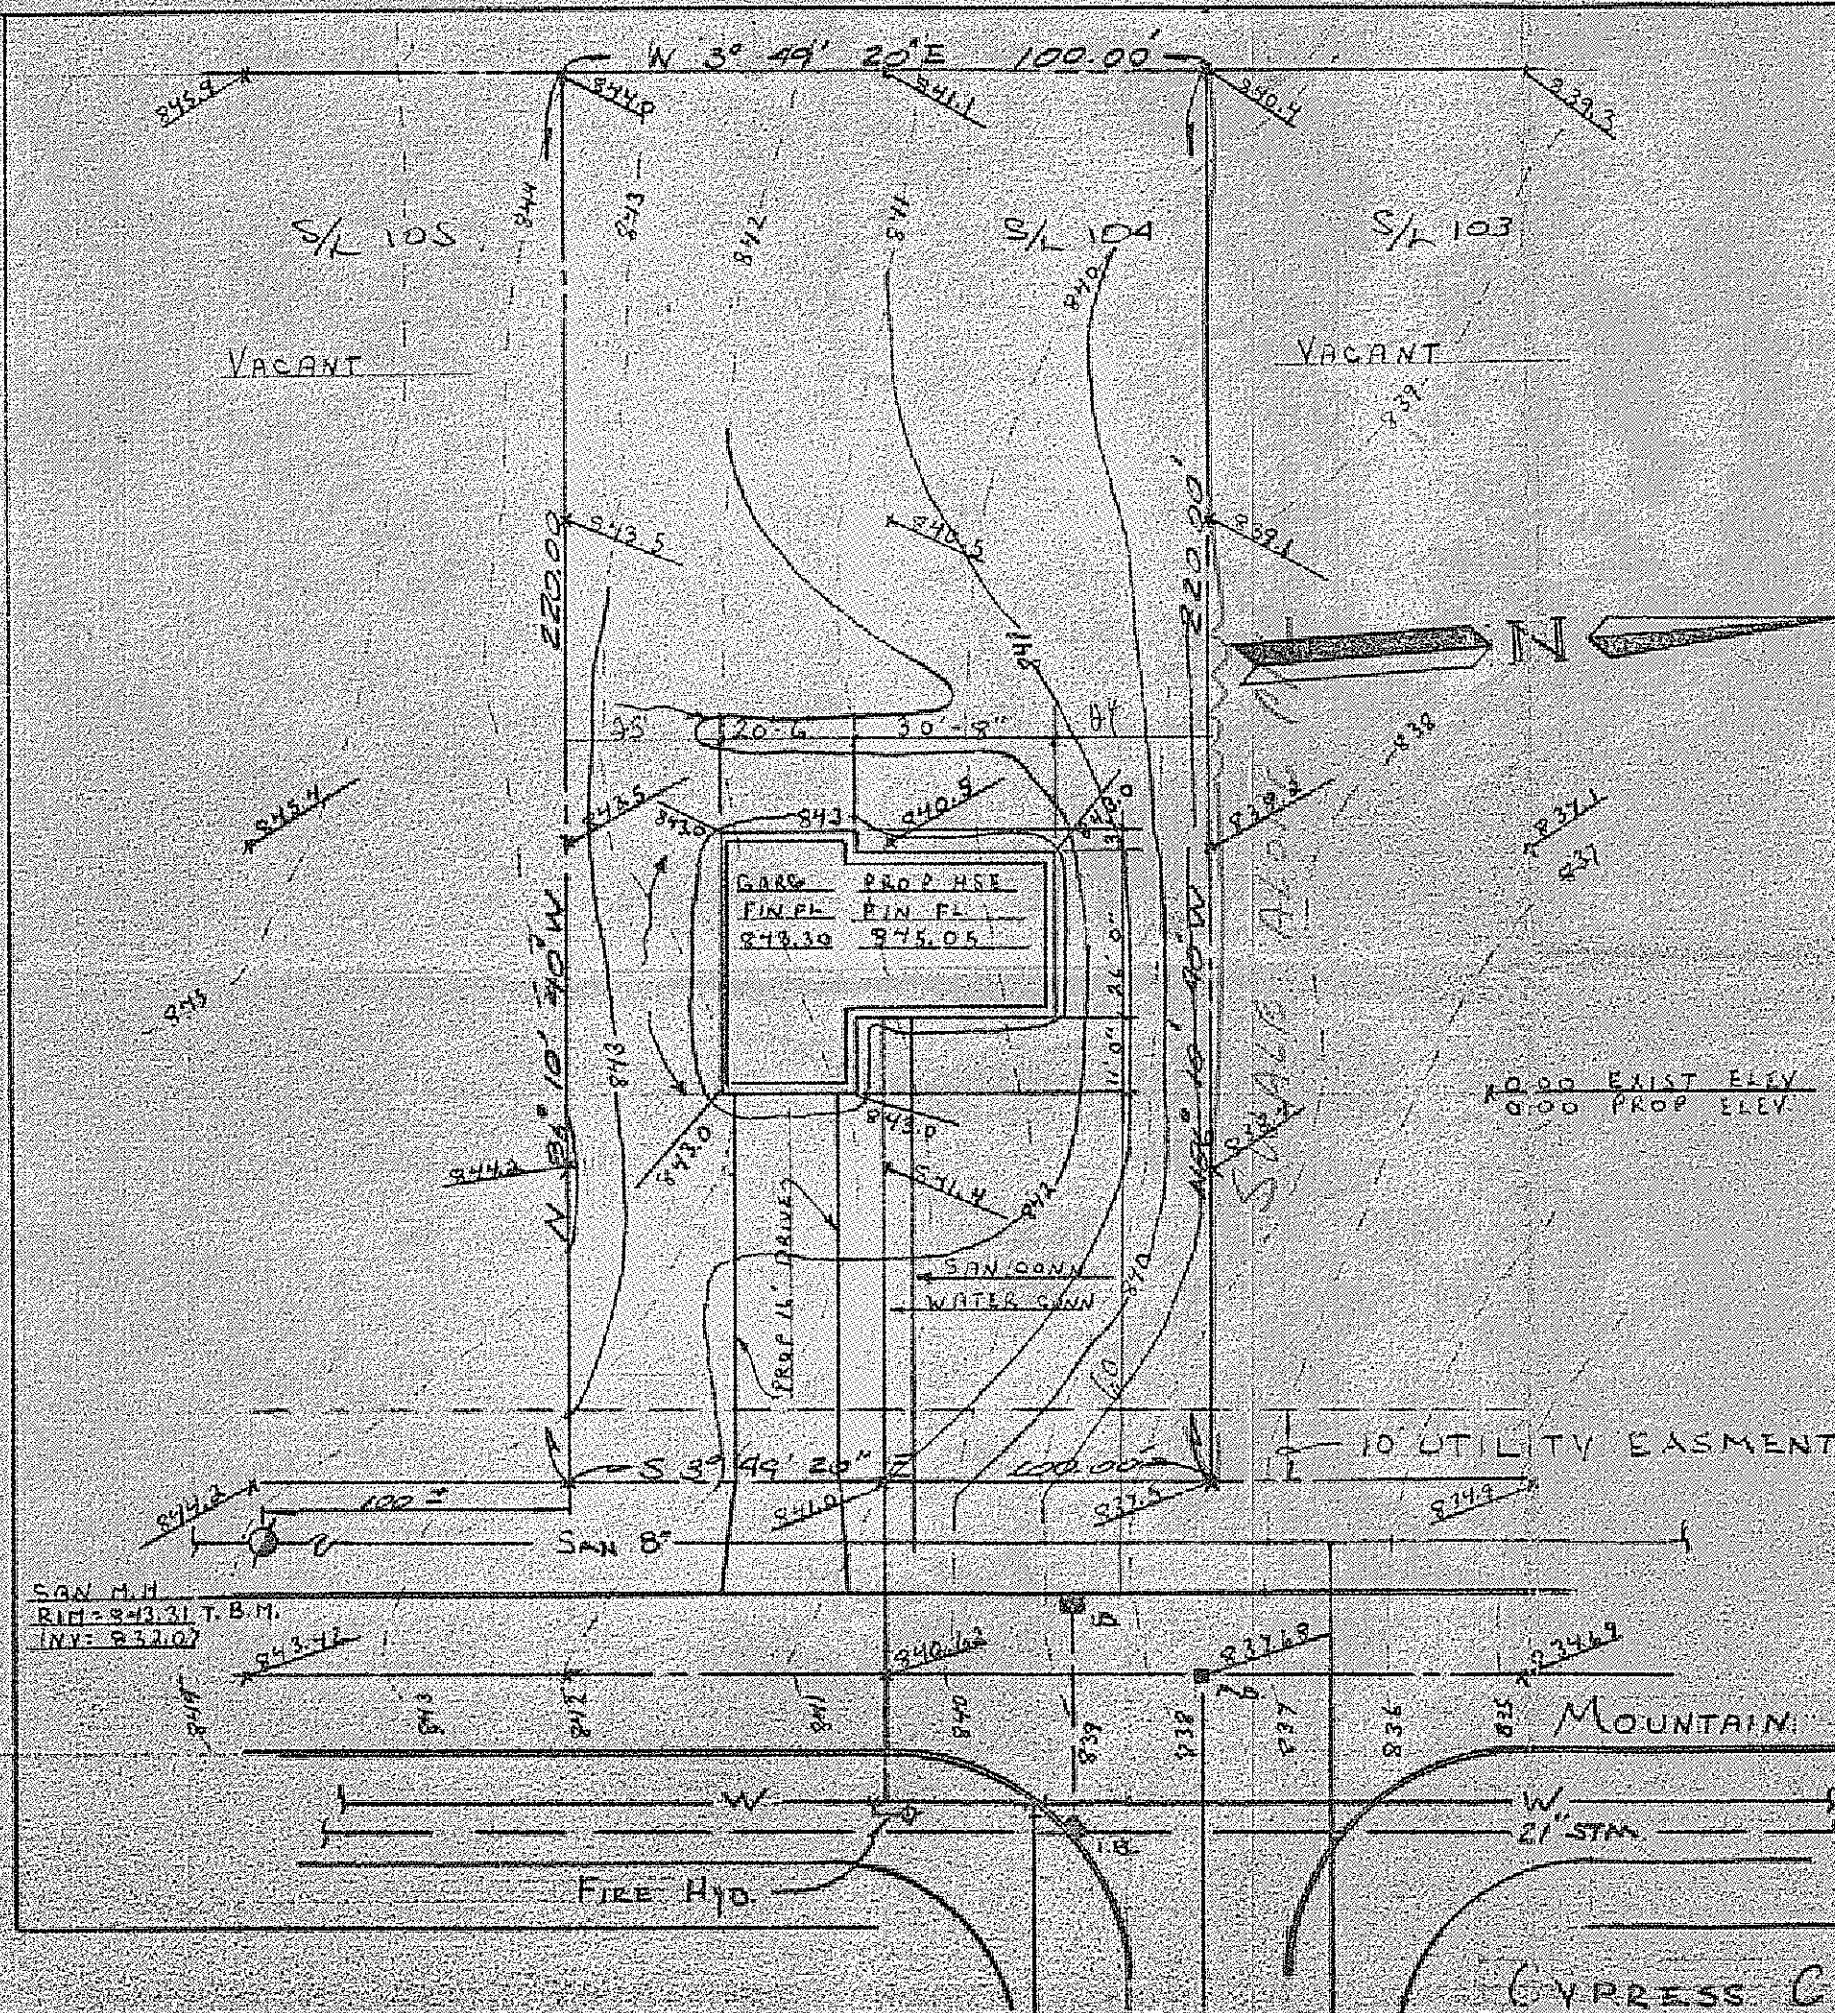

SITE PLAN

SHANDLE CONSTRUCTION

8353 MENTOR AVE.
MENTOR OHIO

BEING SUBLT NO. 104 IN
MORLEY HILLS ESTATES NO. 3
IN CONCORD TWP., OHIO

Grading Plan Approved
as shown and/or noted
THOMAS P. GILLES, P. E.
Lake County Engineer

By 7-20 - Date 10 APR 27 8

PREPARED BY:

WM. R. GRAY ASSOC. INC.

7547 MENTOR AVE
MENTOR OHIO

SCALE: 1" = 30'

DATE: MARCH 17, 1978

1st Floor 1160 sqft
2nd Floor 1000 sqft
Garage 420 sqft

7780

CERTIFICATION:

I HEREBY CERTIFY THAT THIS
PLAN IS CORRECT TO THE BEST
OF MY KNOWLEDGE

BY: Wm. R. Gray

WM. R. GRAY REG. SURV. #2752

#3552

ZONING PERMIT

ISSUED: 4-5-78


SUBJECT TO APPROVAL BY:

Lake County Sanitary Eng.

Lake County Eng. Dept. ☒

Lake County Planning Comm. ☒

Lake County Bldg. Dept. ☒

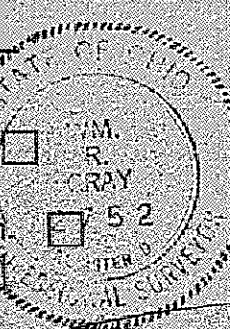

Wm. R. Gray

Mountain Ash Drive (60')
Cypress Circle (60')