

*** CURVE DATA**

R = 1255.97'
 Δ = 100.50'
 C = 100.47'
 T = 50.25'
 Δ = 4° 36' 09"
 S = 0° 13' 53" W

SITE PLAN FOR:

SHANDLE CONSTRUCTION
 8353 MENTOR AVE
 MENTOR, OHIO
 BEING SUBLT No 157
 IN MORLEY HILLS ESTATES
 No 3 IN CONCORD, OHIO

PREPARED BY:

WM GRAY ASSOC INC
 7547 MENTOR AVE
 MENTOR, OHIO
 SCALE: 1" = 30'
 DATE: 22 AUG, 1977

Grading Plan Approved
 as shown and/or noted
 THOMAS P. GILLES, P.E.
 Lake County Engineer
 Date: 14 Sept 77
 No STM. Comm.

Grading Plan
 as shown and/or noted
 THOMAS P. GILLES, P.E.
 Lake County Engineer

CERTIFICATION:

I HEREBY CERTIFY THAT
 THIS PLAN IS CORRECT TO THE
 BEST OF MY KNOWLEDGE

By: Wm R. Gray
 WM GRAY REG SURV #2752




ZONING PERMIT

#3413

Approved 8-31-77
 W.E. van Dine

MOUNTAIN ASH DRIVE 60'

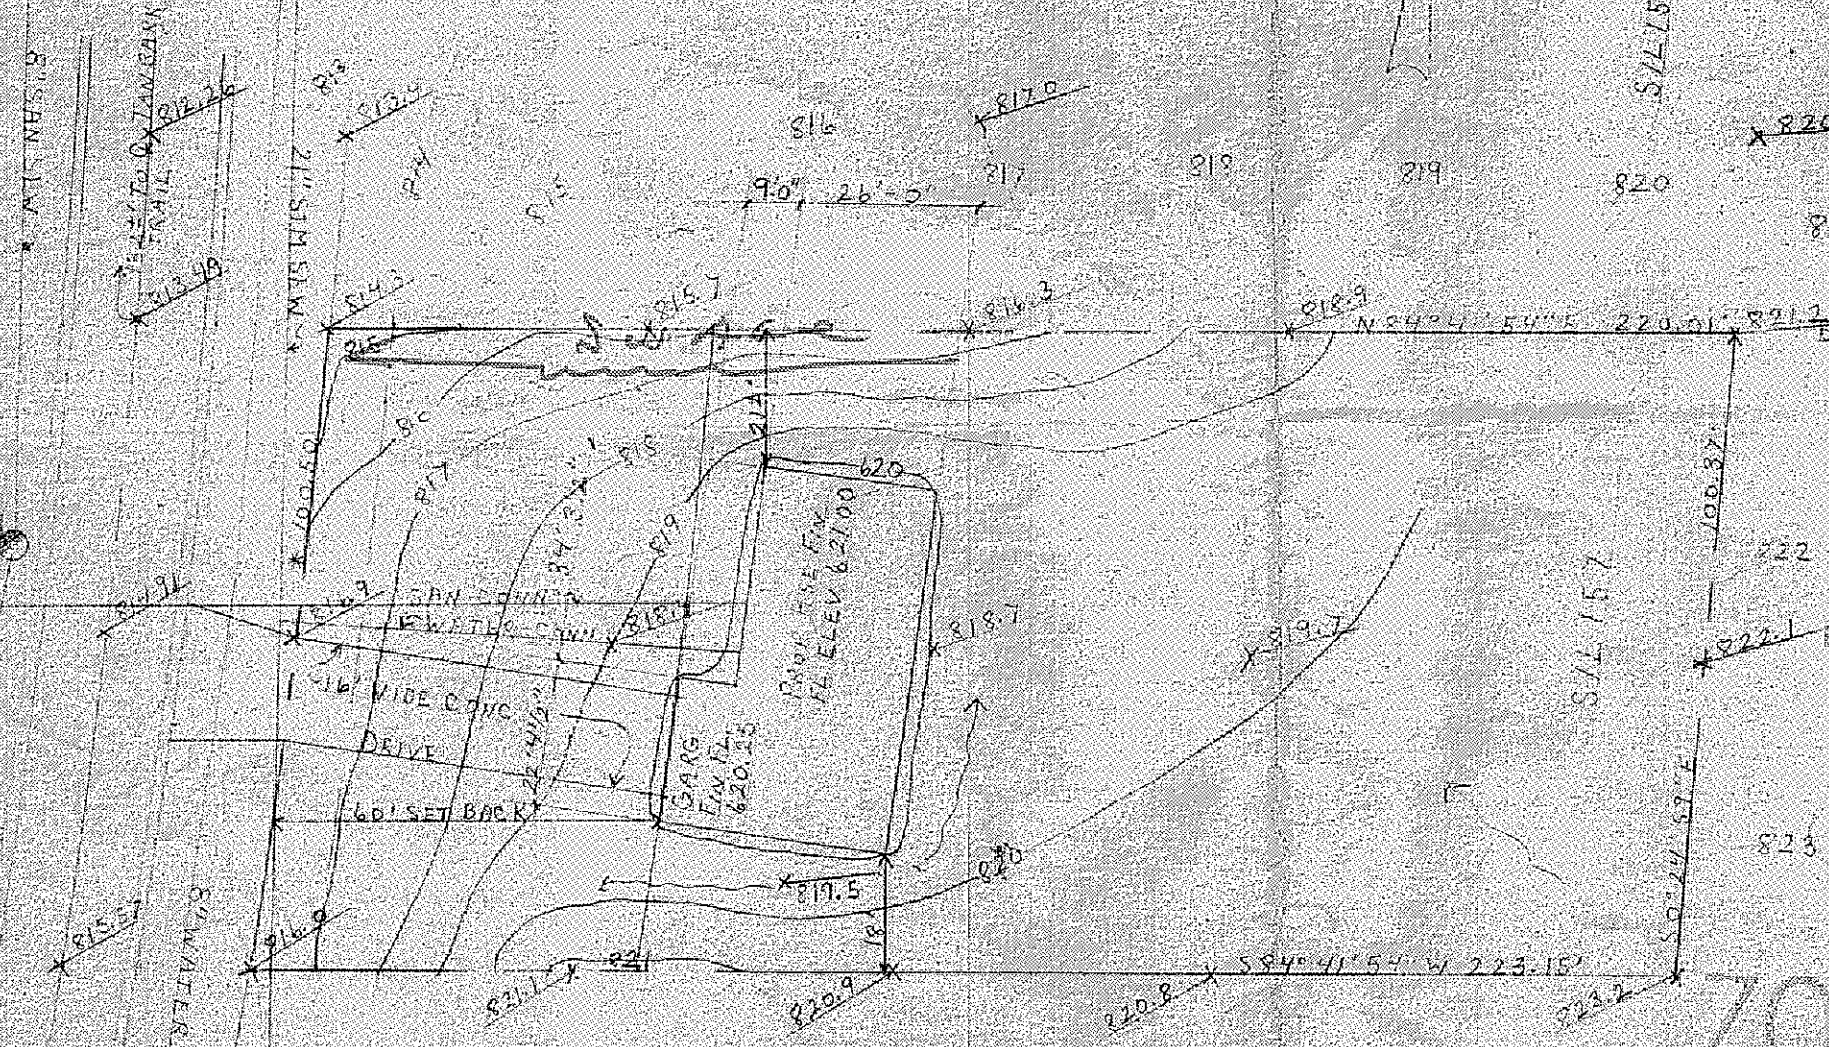

SBM 5174H
 RIM 814.97
 INV 798.93