


SHANDLE CONSTRUCTION
8353 MENTOR AVE
MENTOR, OHIO
BEING SUBLot No 106 IN THE
MORLEY HILLS ESTATES No 3
IN CONCORD TOWNSHIP, OHIO

Grading Plan Approved
as shown and/or noted
THOMAS P. CLARK, P.E.
Lake County Engineer
By TCO Date 10/11/28

WILLIAM R GRAY ASSOC. INC
7547 MENTOR AVE
MENTOR, OHIO
SCALE: 1"=30'
DATE: FEB 13, 1978

I HEREBY CERTIFY THAT THIS
PLAT IS CORRECT TO THE BEST
OF MY KNOWLEDGE
BY: Wm. R. Gray
WM. R. GRAY REG. SURV. #1752

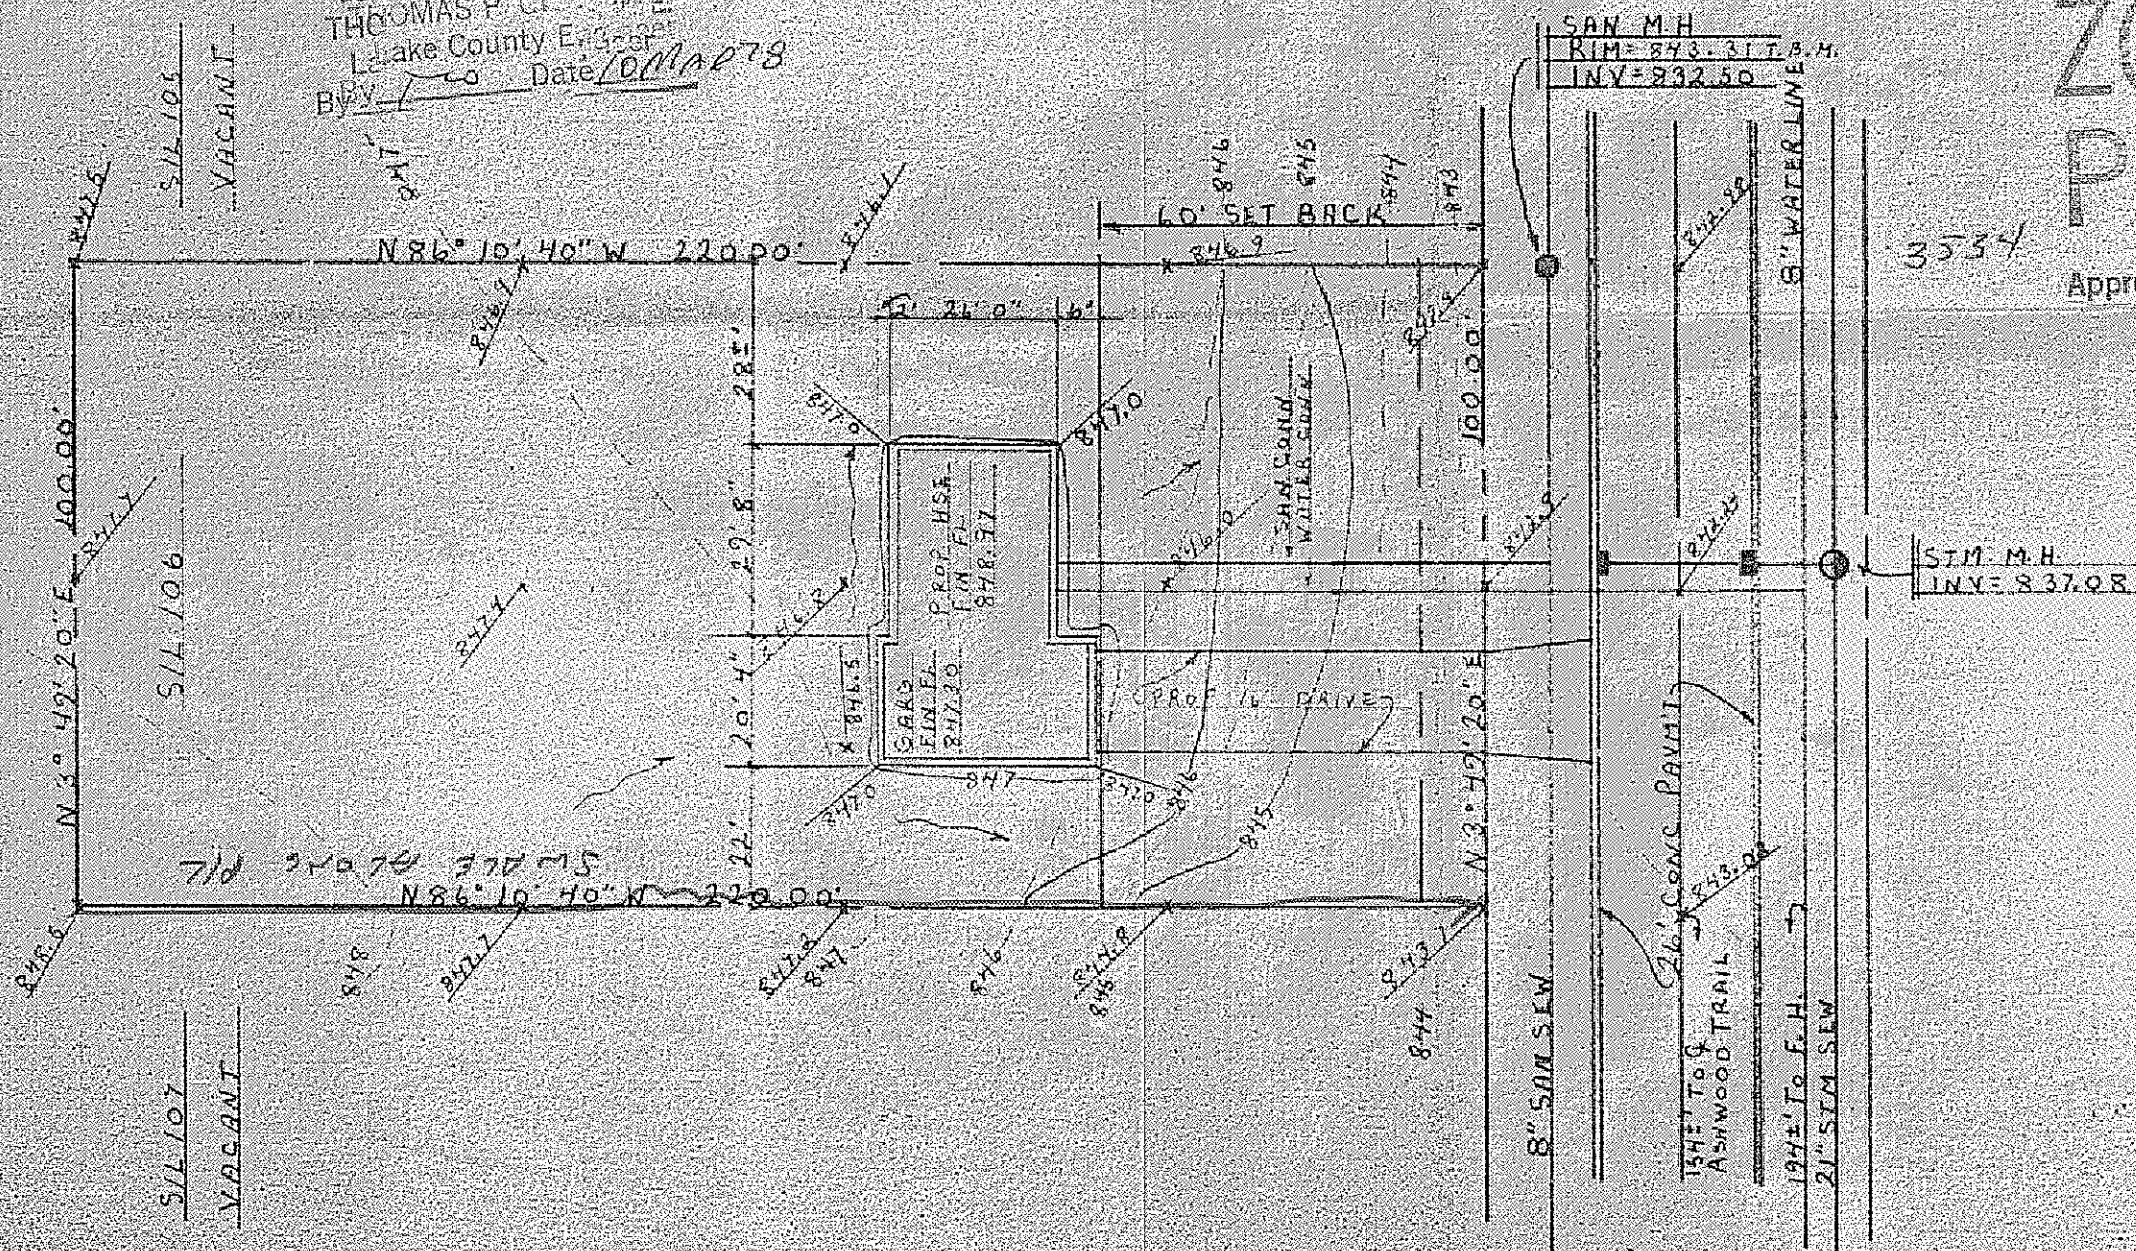

ZONING PERMITS

Approved 3-8-72

W. E. in West



MOUNTAIN ASH DRIVE 6

Grading Plan Approved
as shown and/or noted
THOMAS P. GILLES, P.E.
Land Survey Engineer
By _____
0.00 EXIST. ELEV.
0.00 PROP. ELEV.