
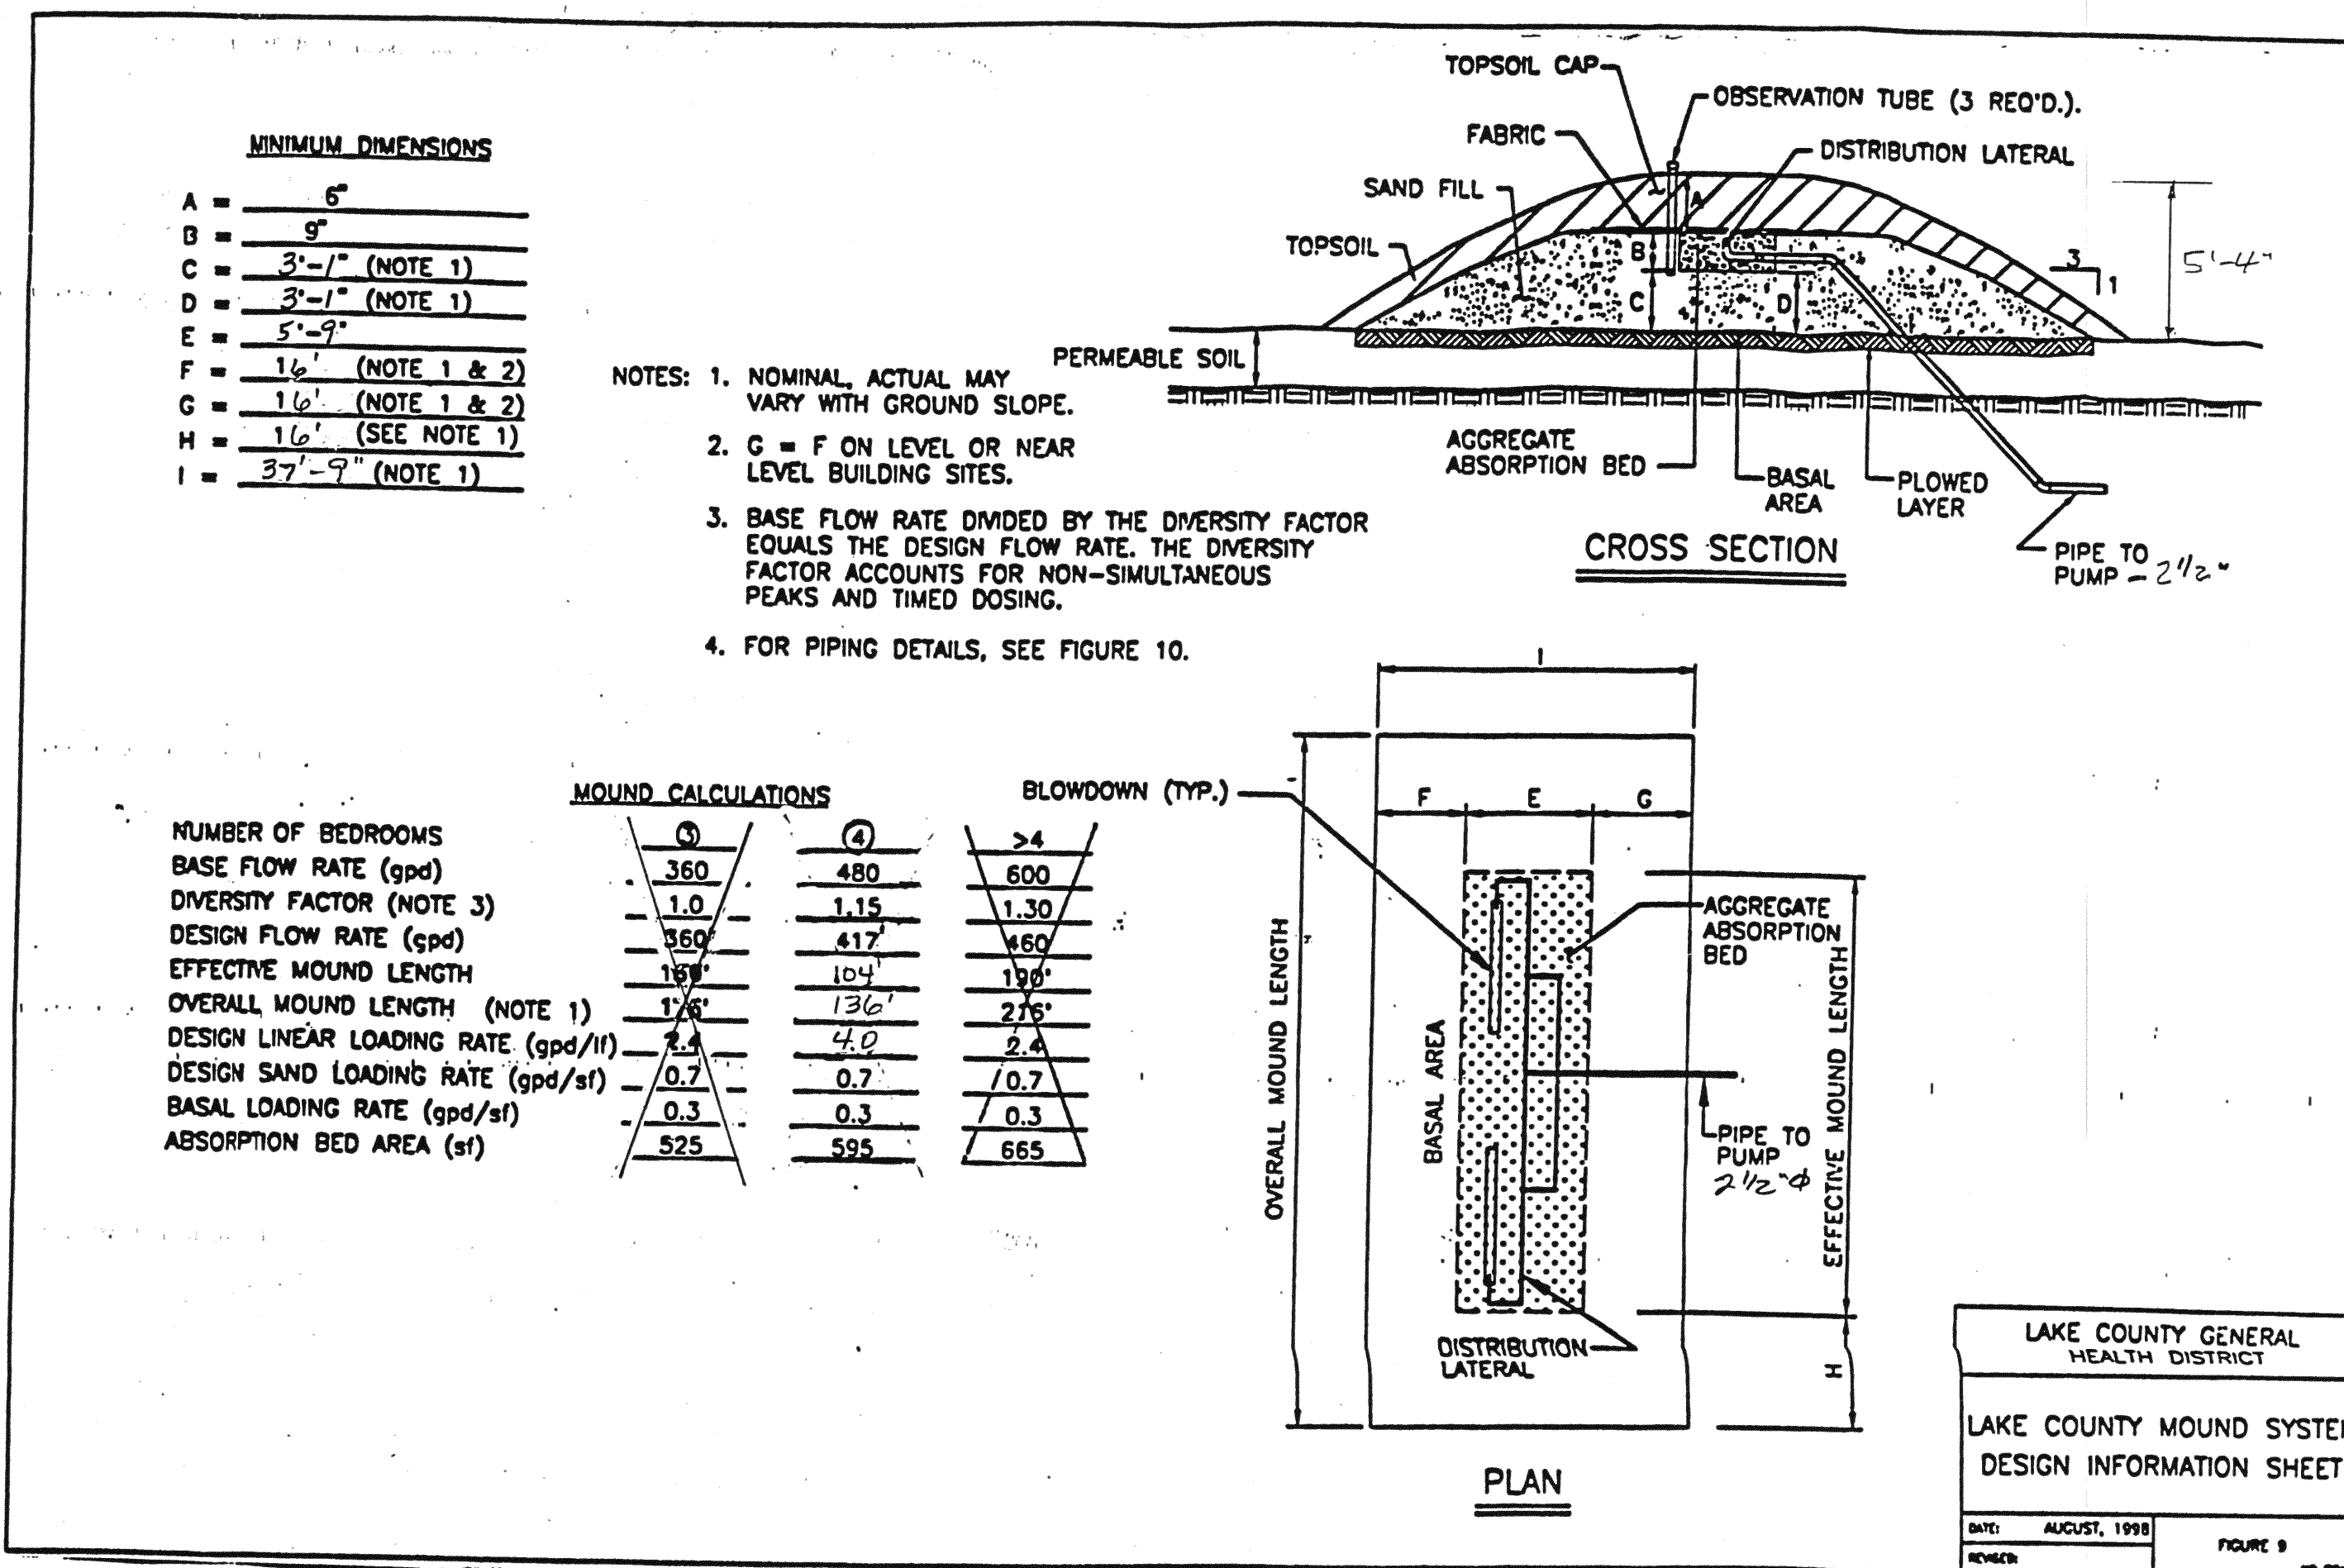
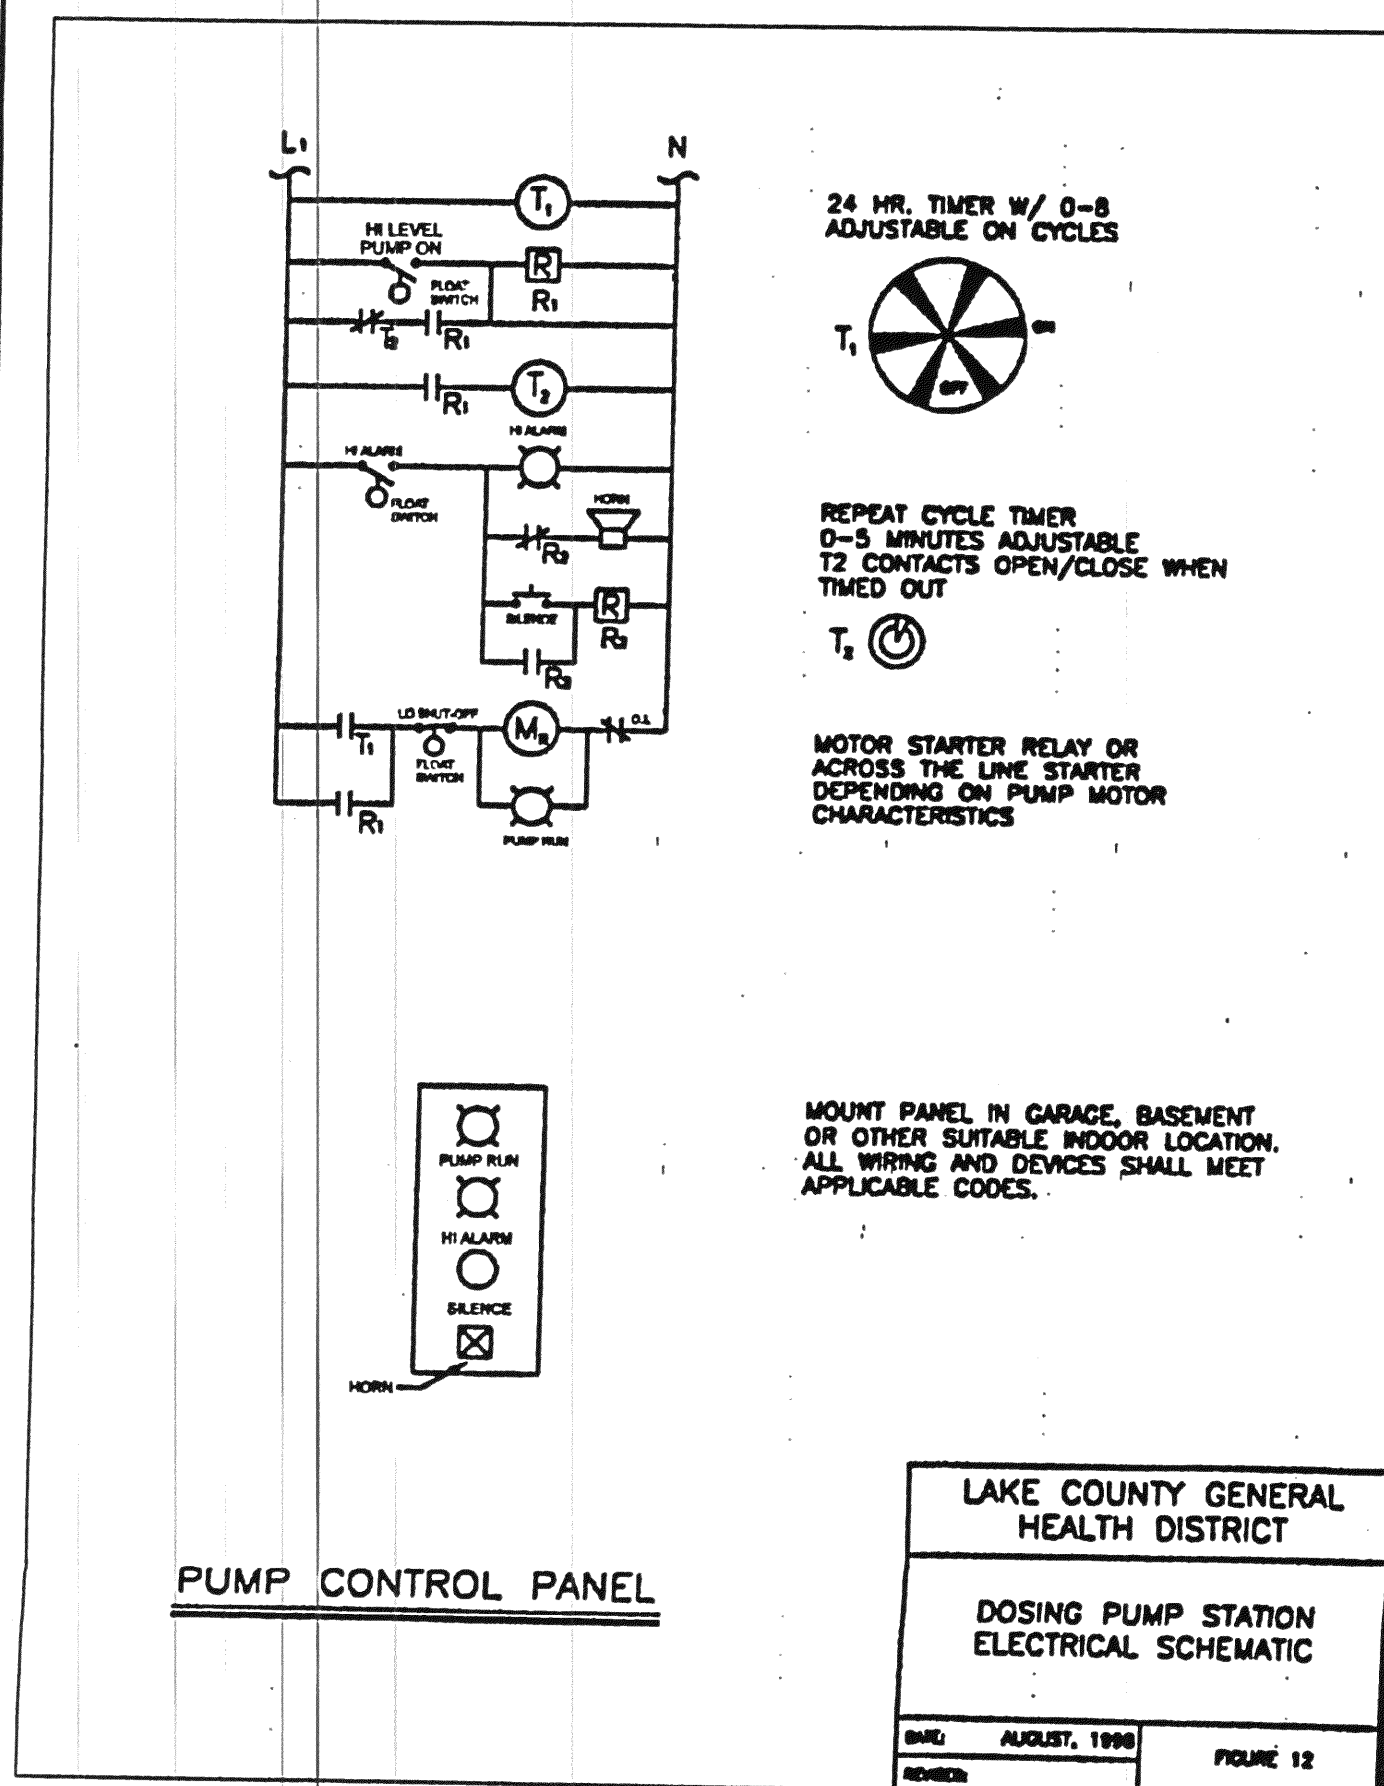
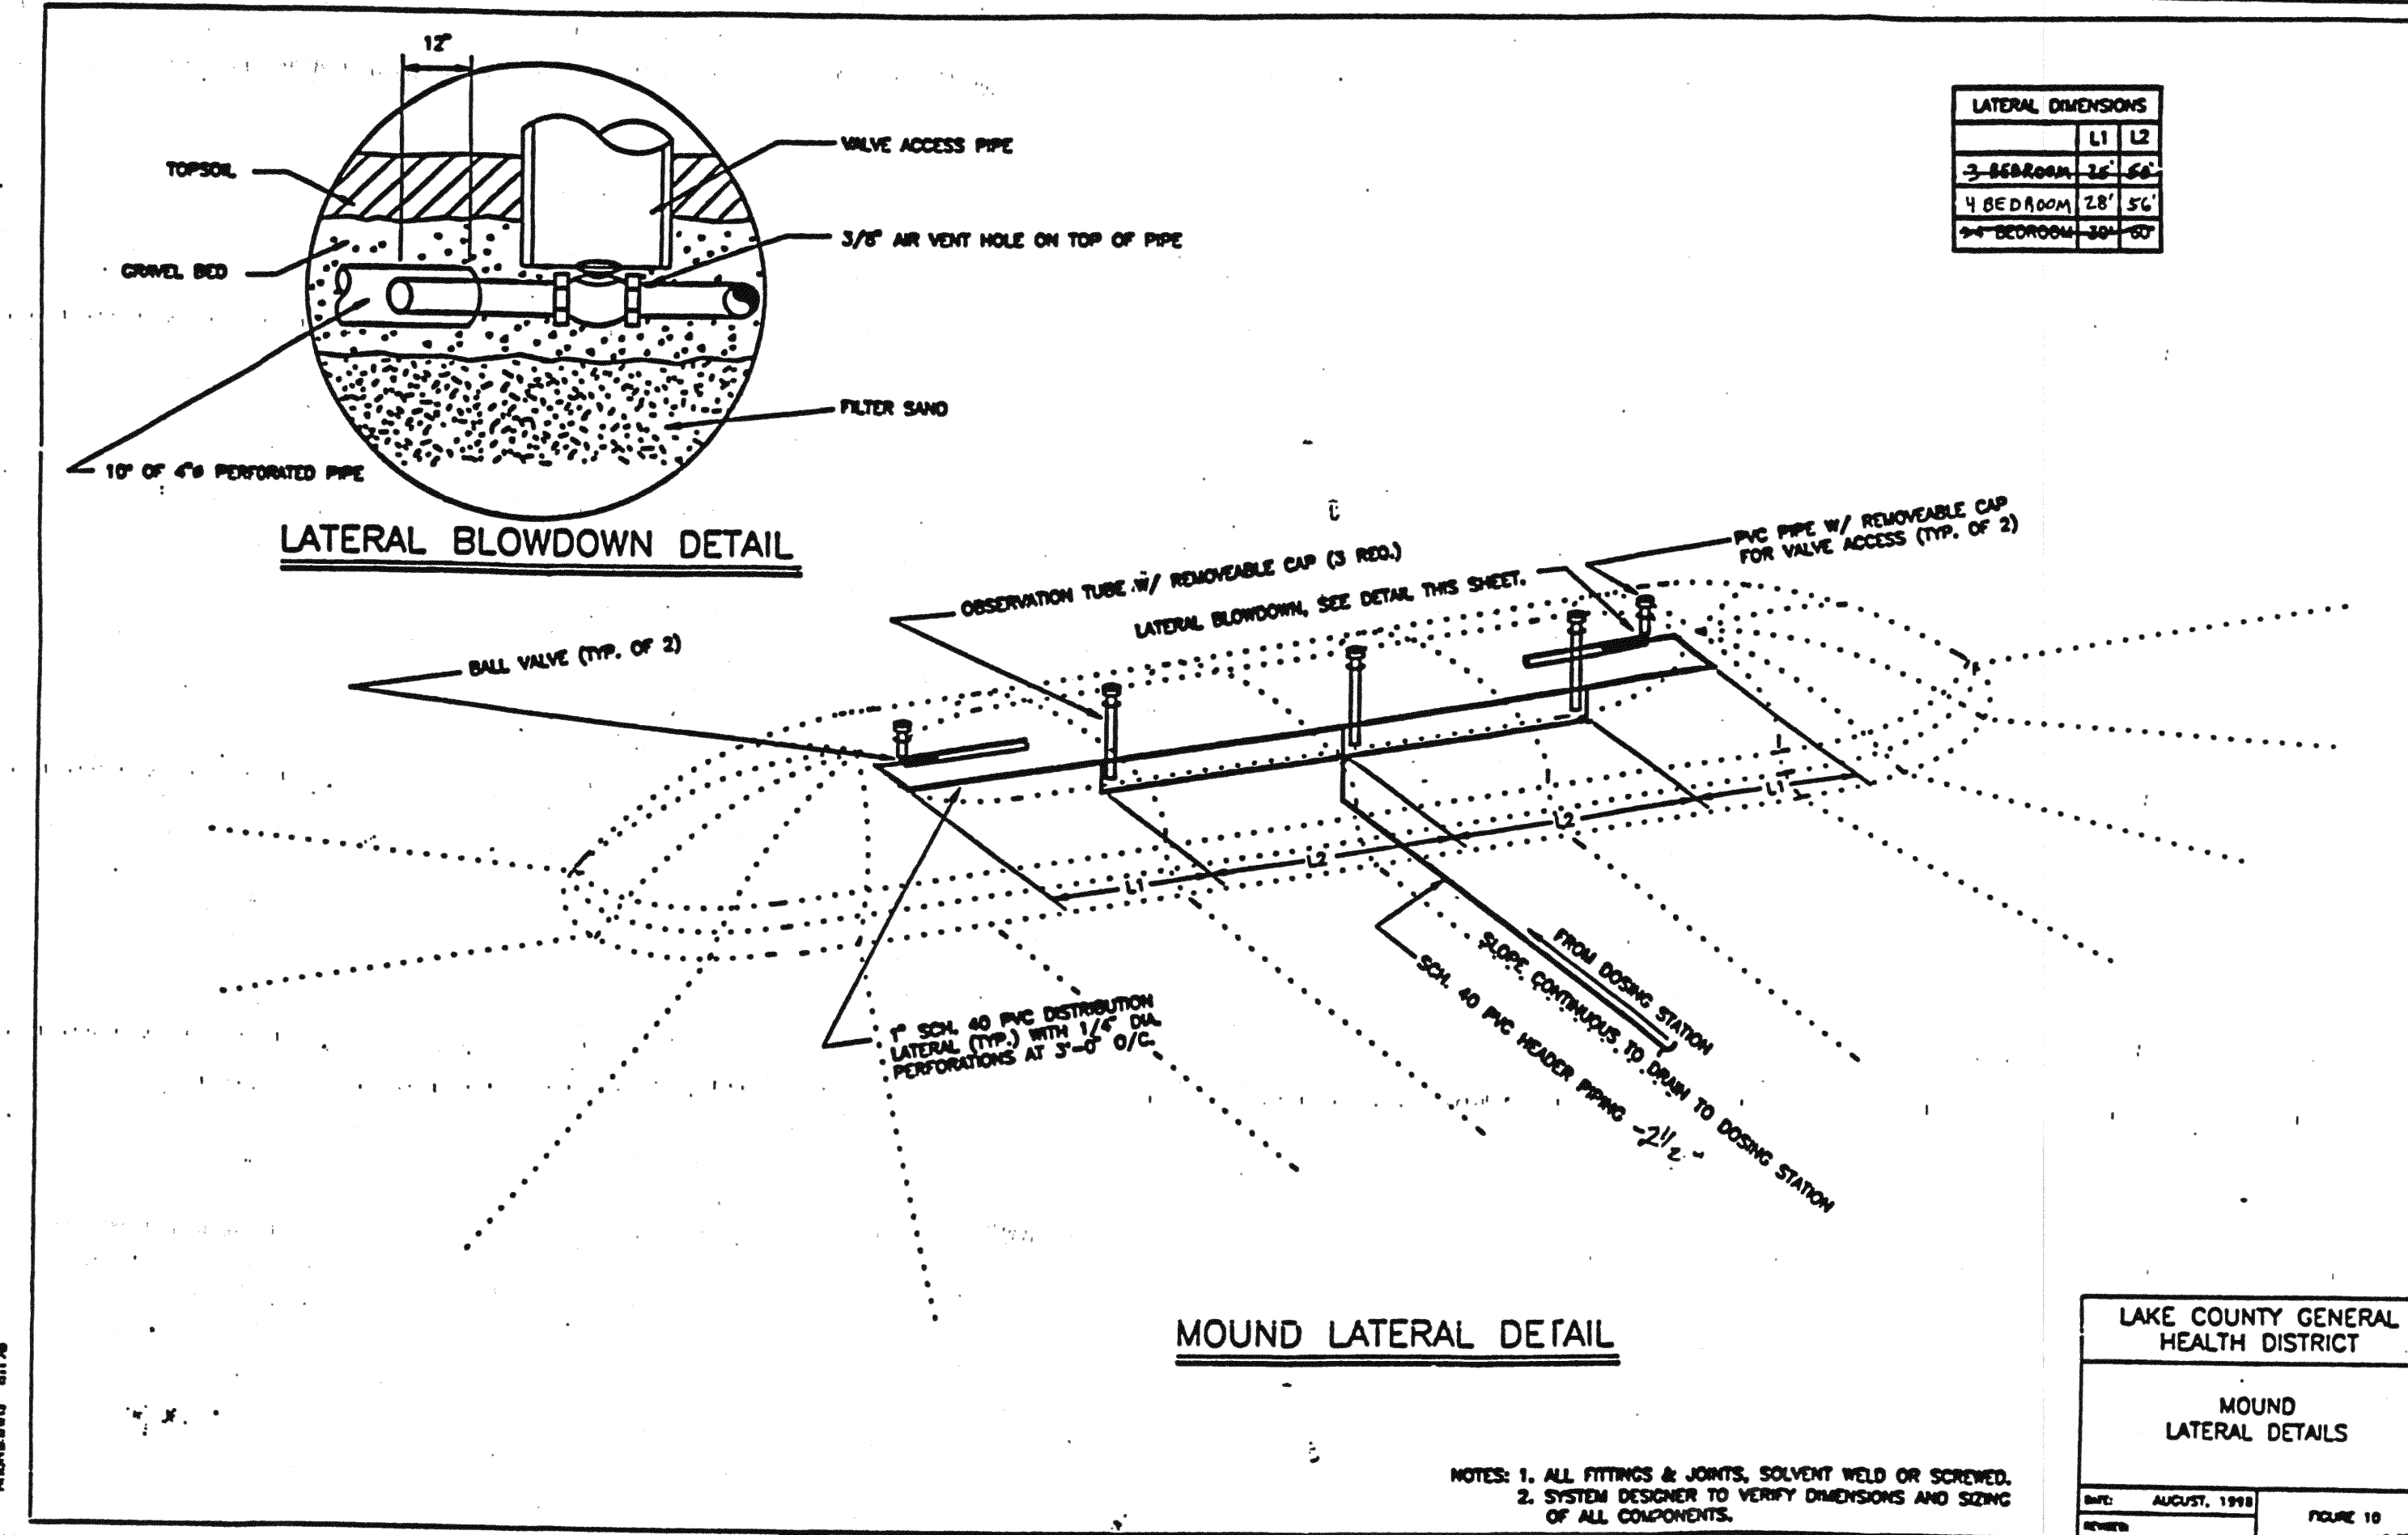


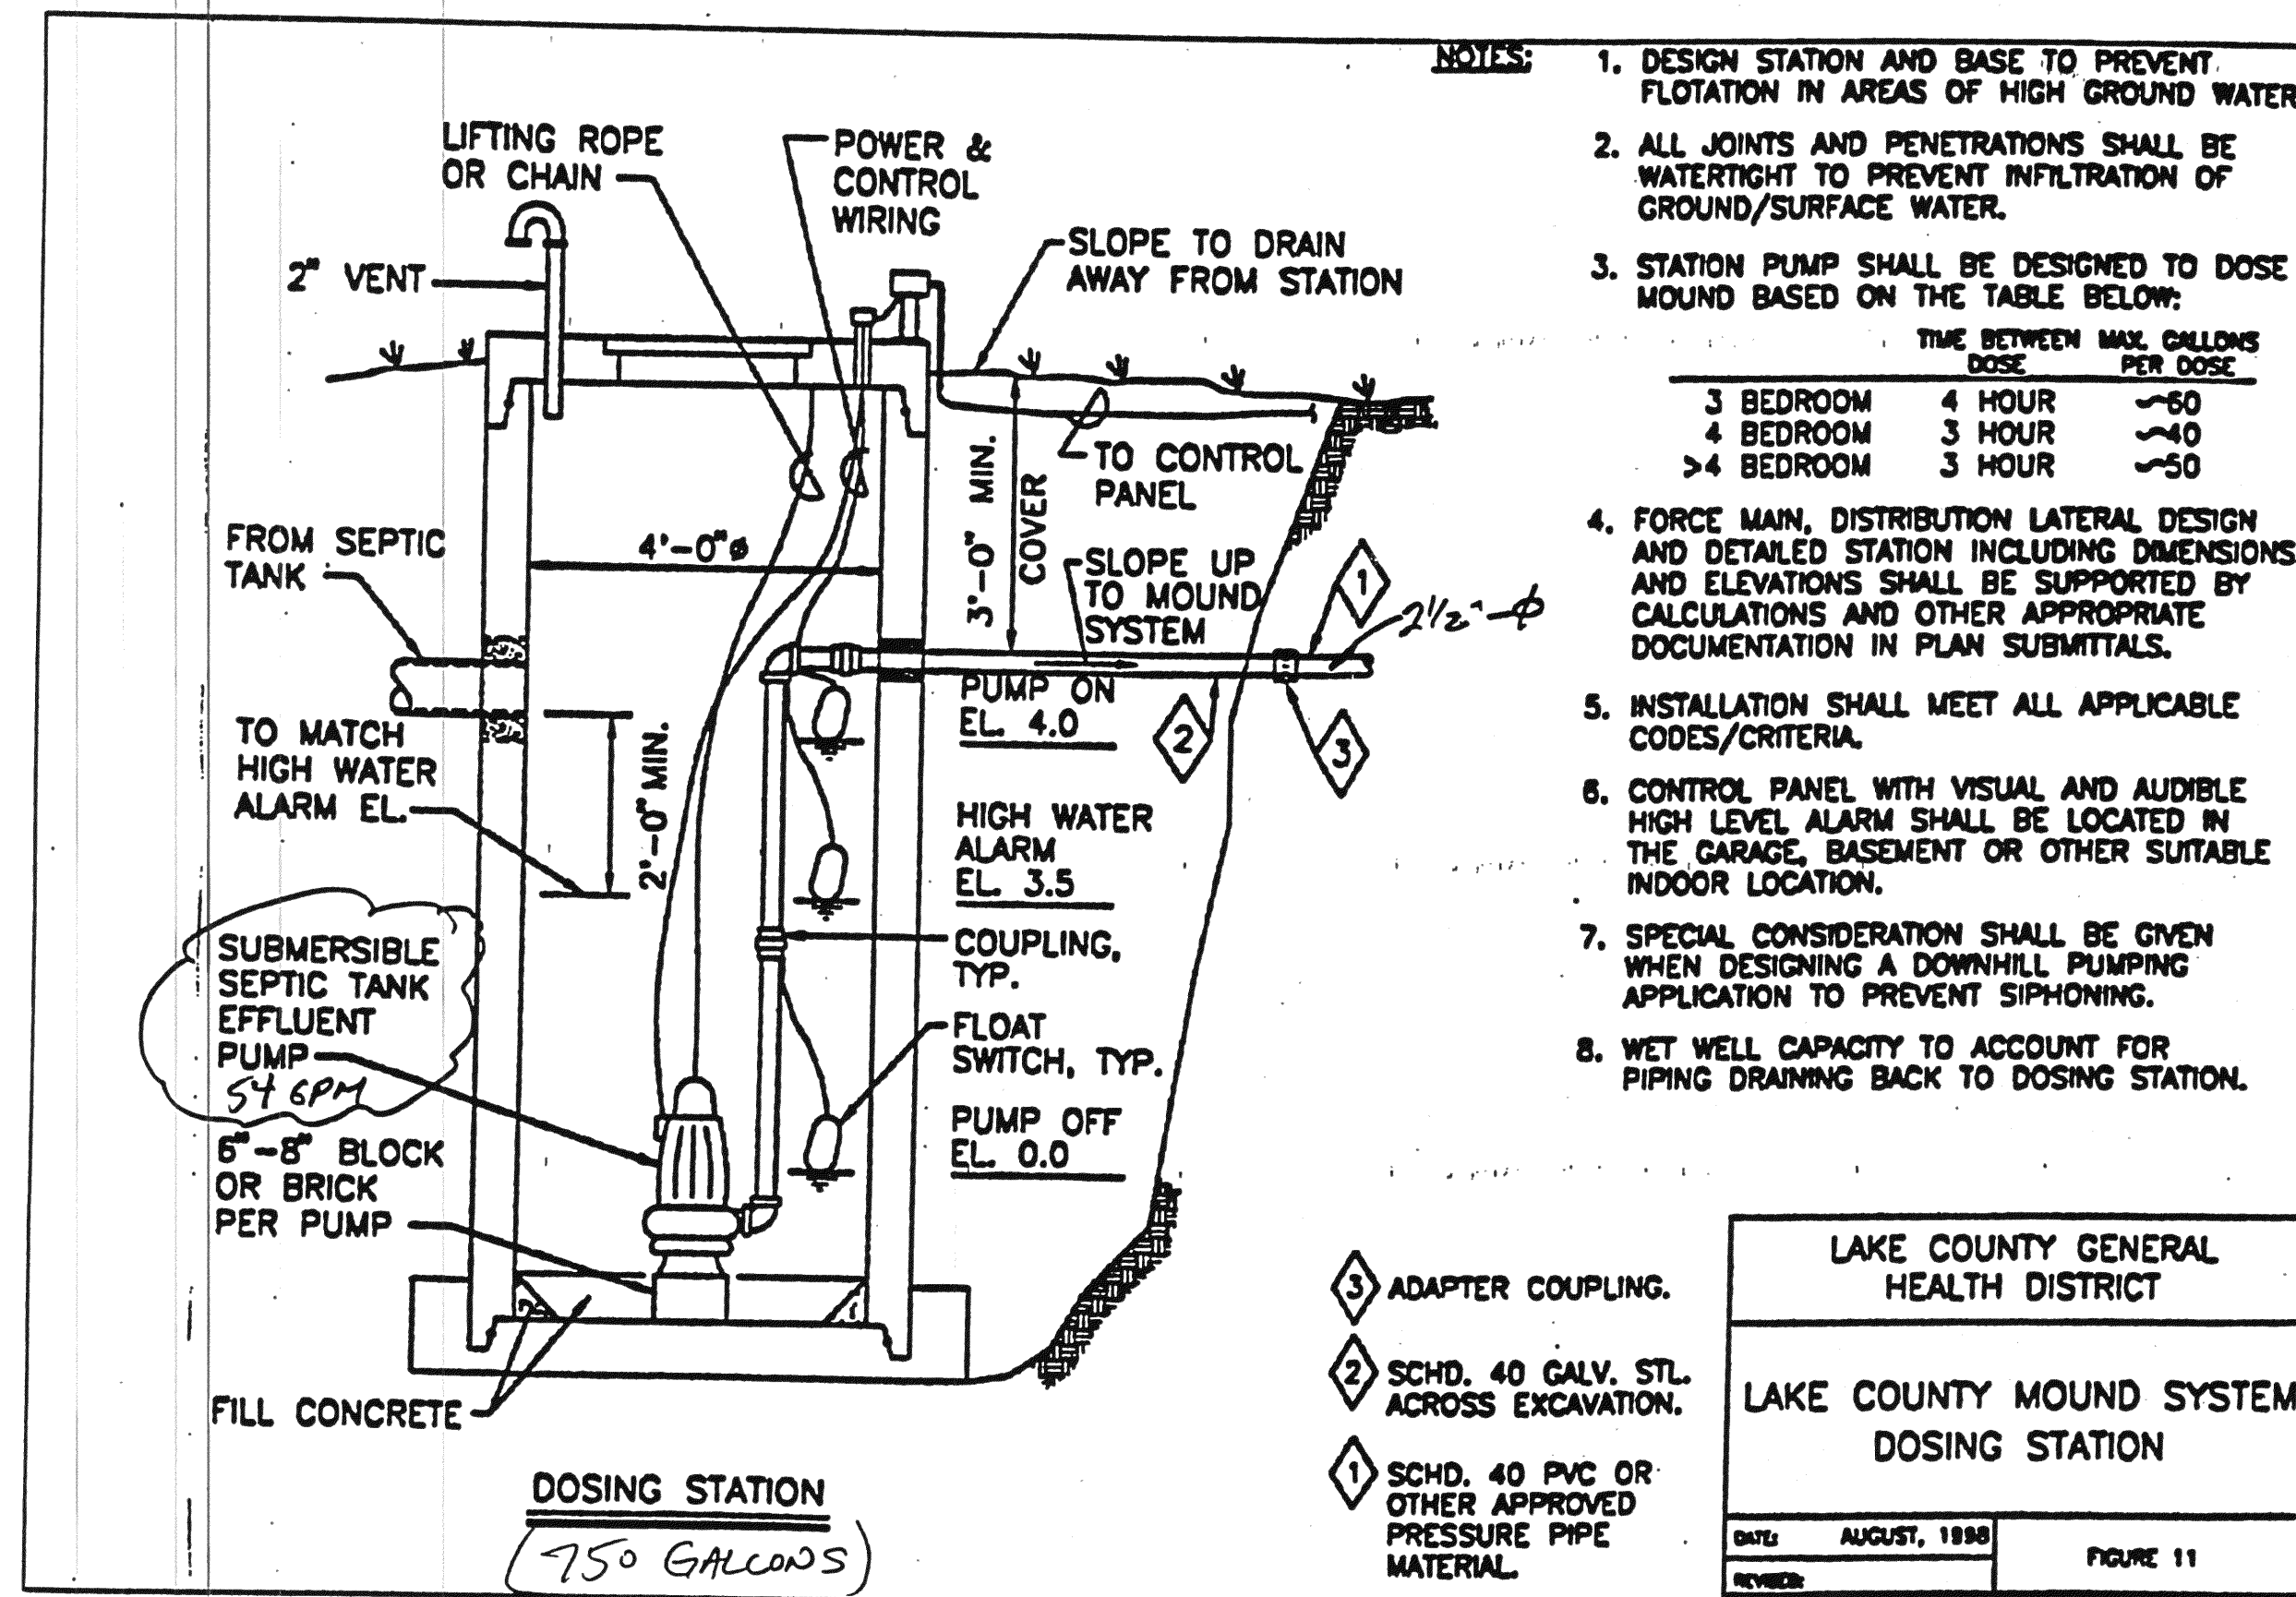

REV. NO.	DESCRIPTION	DATE	BY	CHK'D
1	REVISED FORCE MAIN TO 2 1/2"	5/10/02	HJ	HJ
2	REVISED MOUND DIMENSIONS	5/25/02	HJ	HJ
3	REVISIONS PER C.C. HEALTH DEPT	6/13/02	HJ	HJ

bj BABCOCK, JONES AND ASSOCIATES, INC
CIVIL ENGINEERS - SURVEYORS - LAND PLANNERS
PAINESVILLE OHIO 44077

DATE: 4/18/02
DESIGN BY: H.J.
DRAWN BY: T.R.
APPROVED BY: H.J.

SITE PLAN
FOR
STADEN
S/L 40 MAJESTY LANE, MOUNT ROYAL SUBDIVISION
CONCORD TOWNSHIP LAKE COUNTY STATE OF OHIO

SCALE: None
JOB NO: 93-163-40
SHEET 2 OF 2