


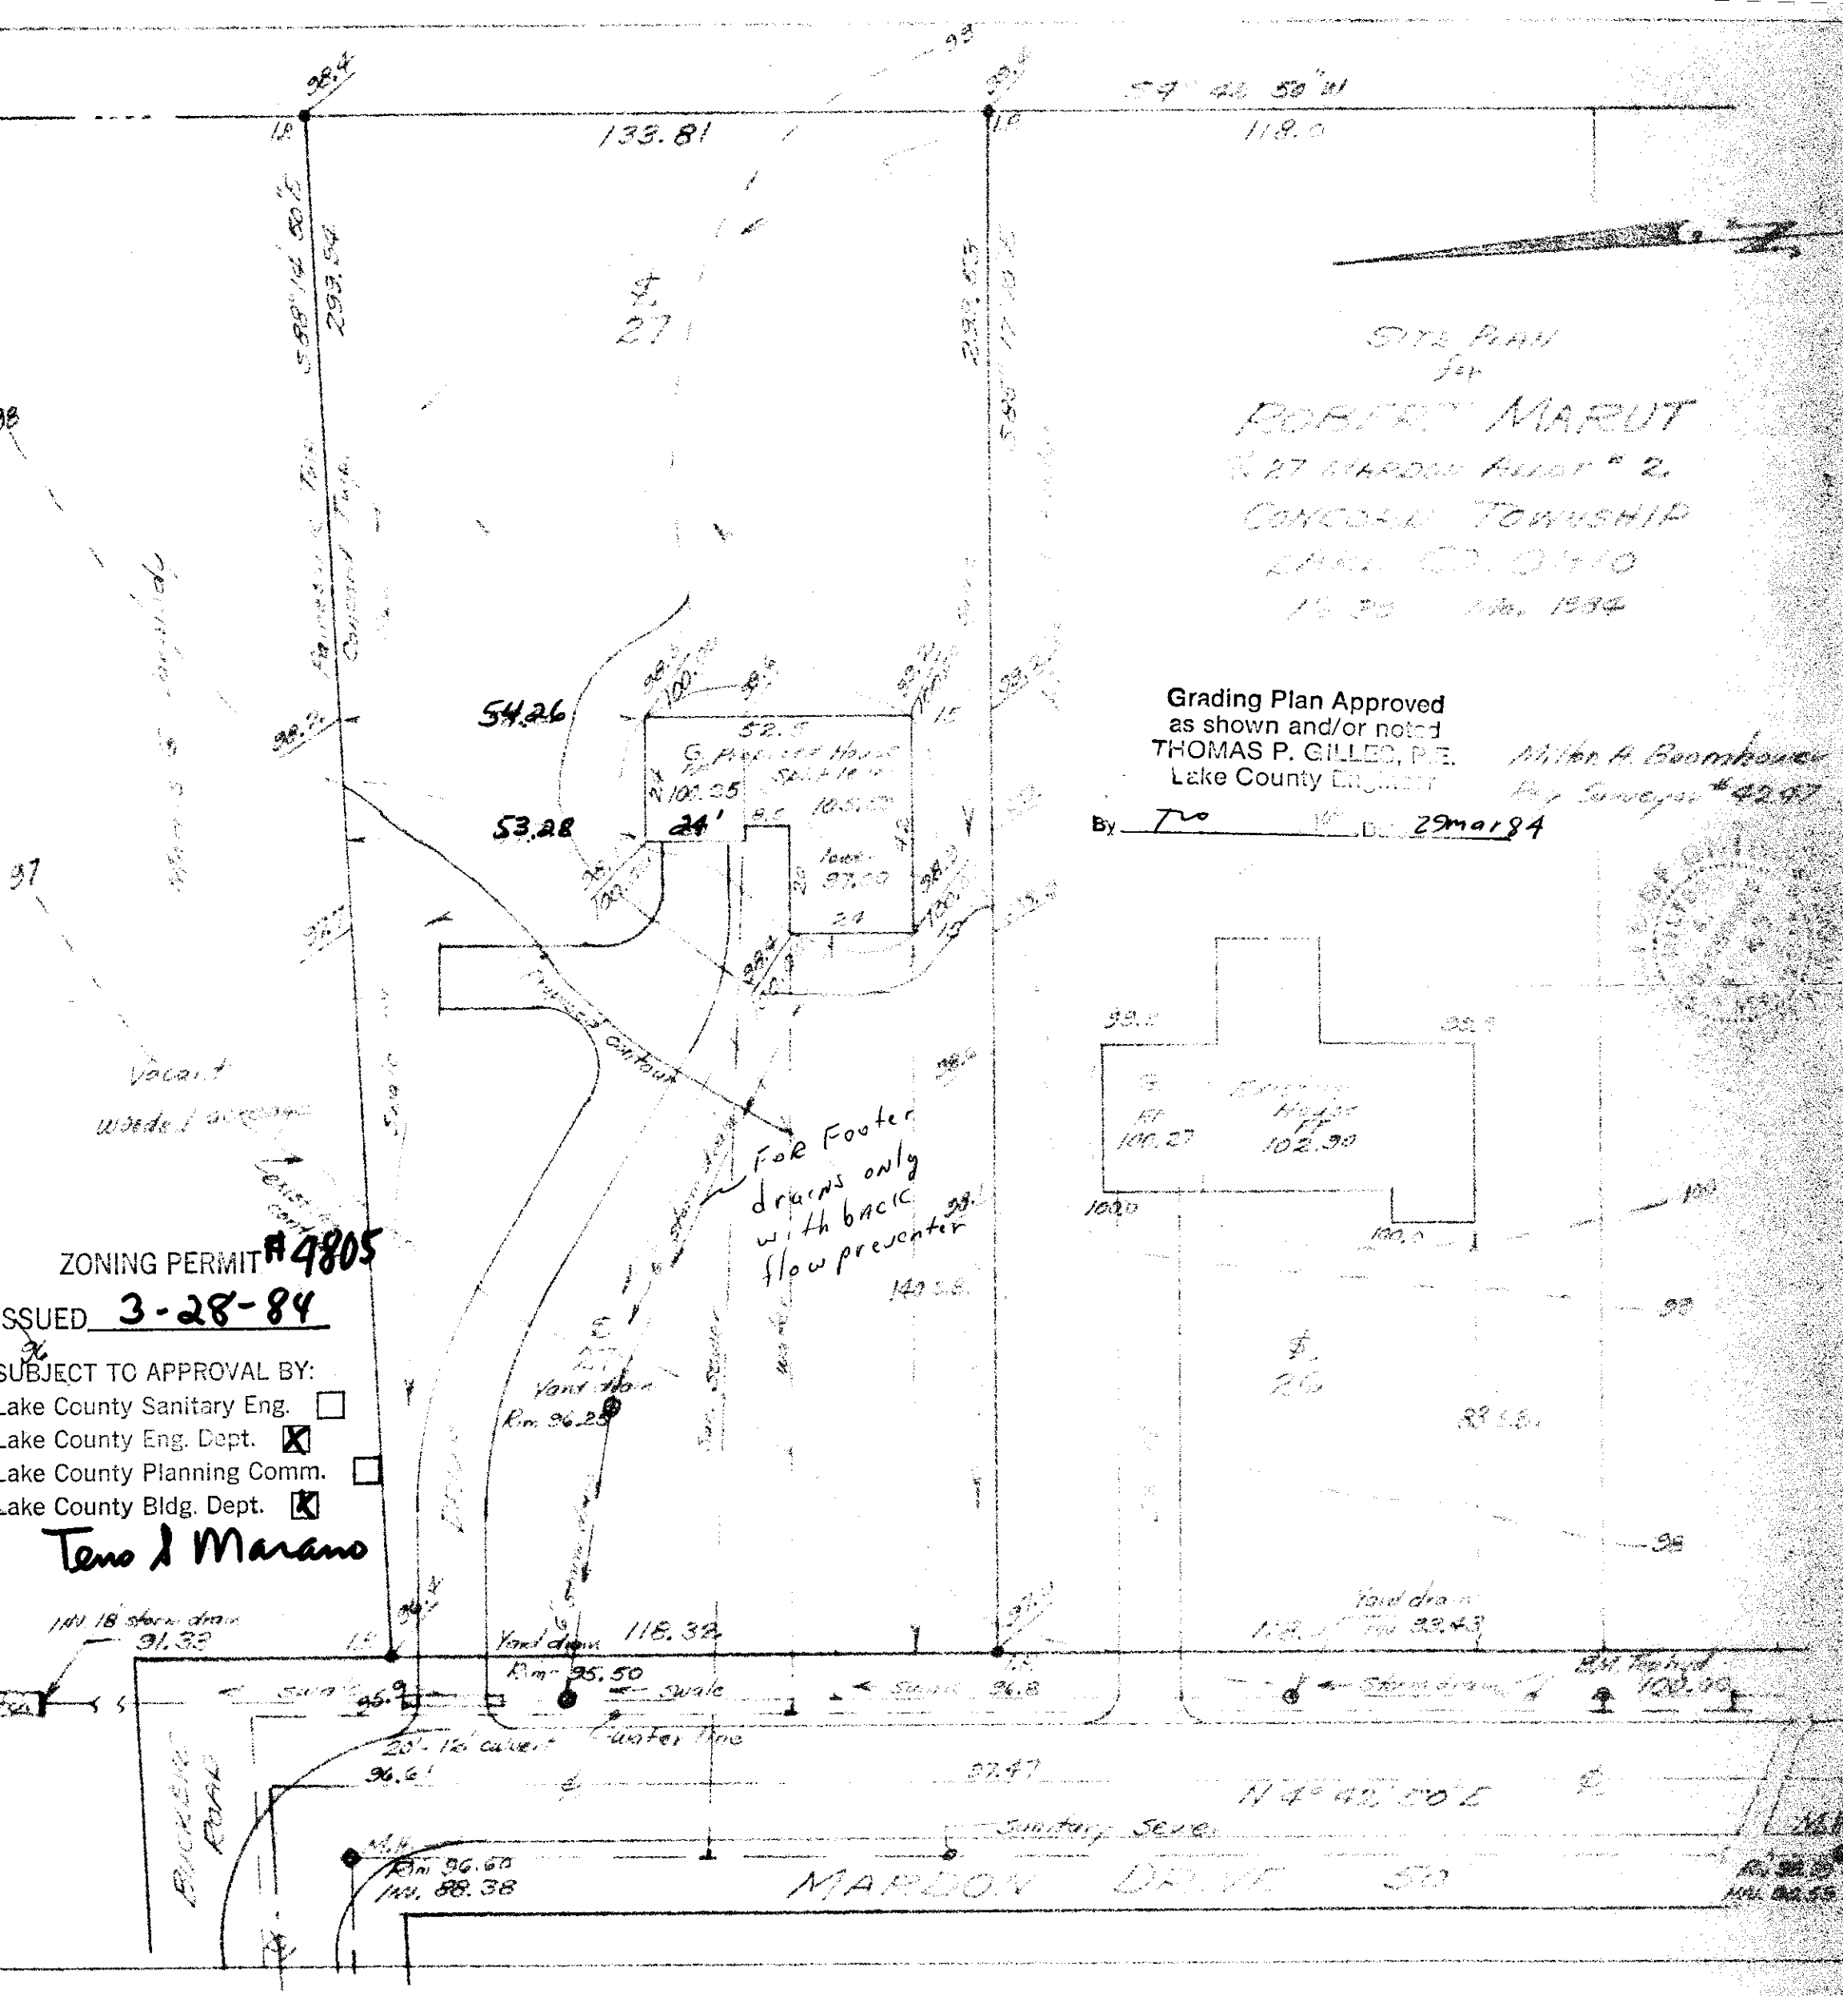

SITE PLAN
for

ROBERT MARUT

27 MARDON AVE. # 2

CONCORD TOWNSHIP

LAKE CO., OHIO

15 30 100 1984

Grading Plan Approved
as shown and/or noted
THOMAS P. GILLES, P.E.
Lake County Engineer

Miller A. Boomhower

Reg. Surveyor #4247

By Teno 10 29mar84

ZONING PERMIT

#4805

ISSUED 3-28-84

SUBJECT TO APPROVAL BY:

Lake County Sanitary Eng. ☐

Lake County Eng. Dept. ☒

Lake County Planning Comm. ☐

Lake County Bldg. Dept. ☒

Teno & Marano