

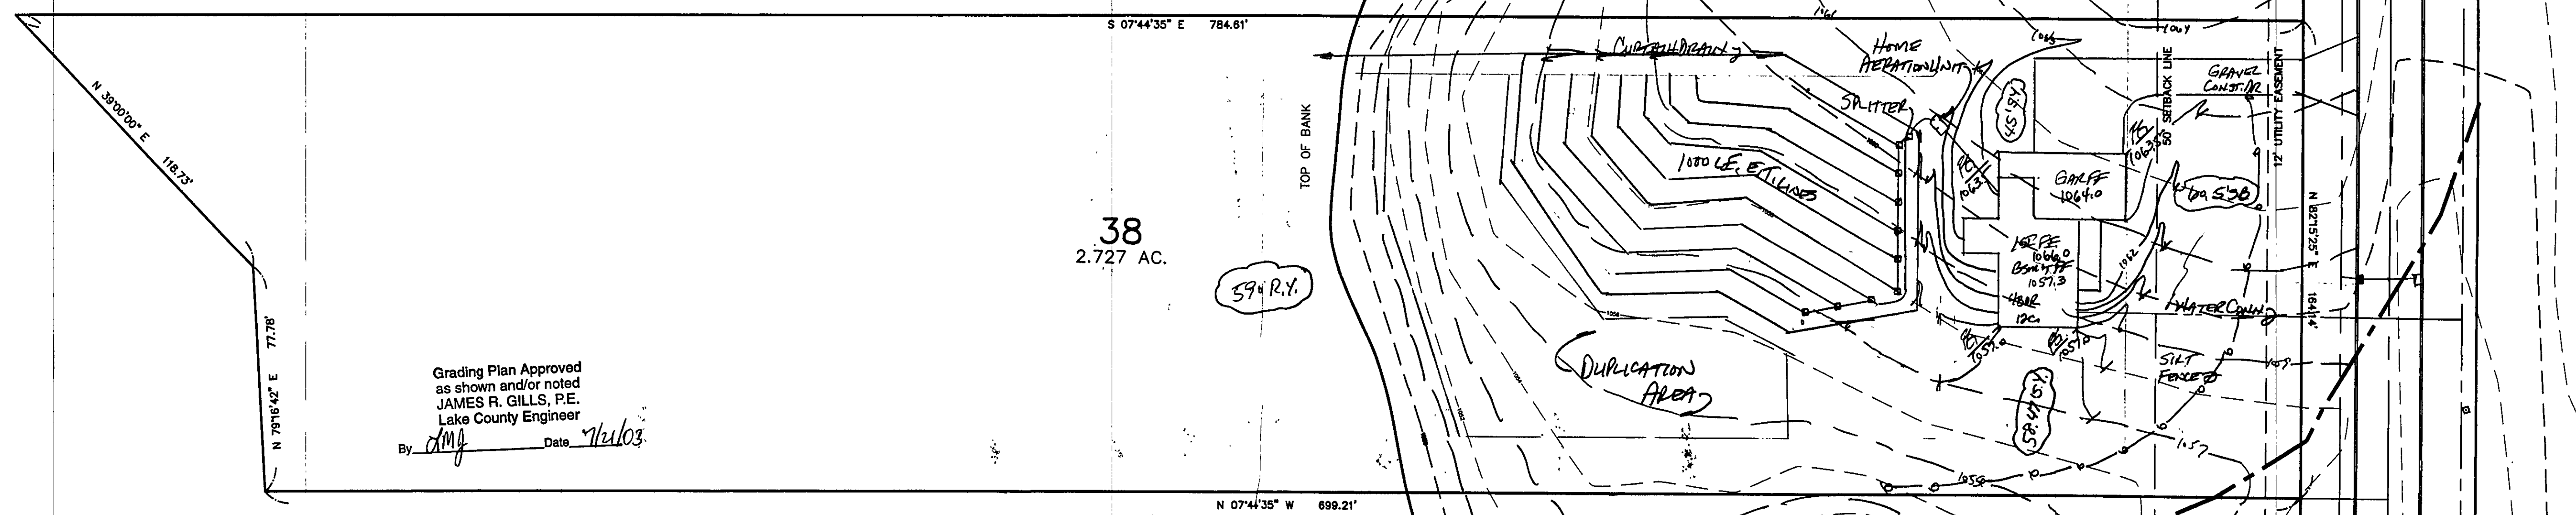
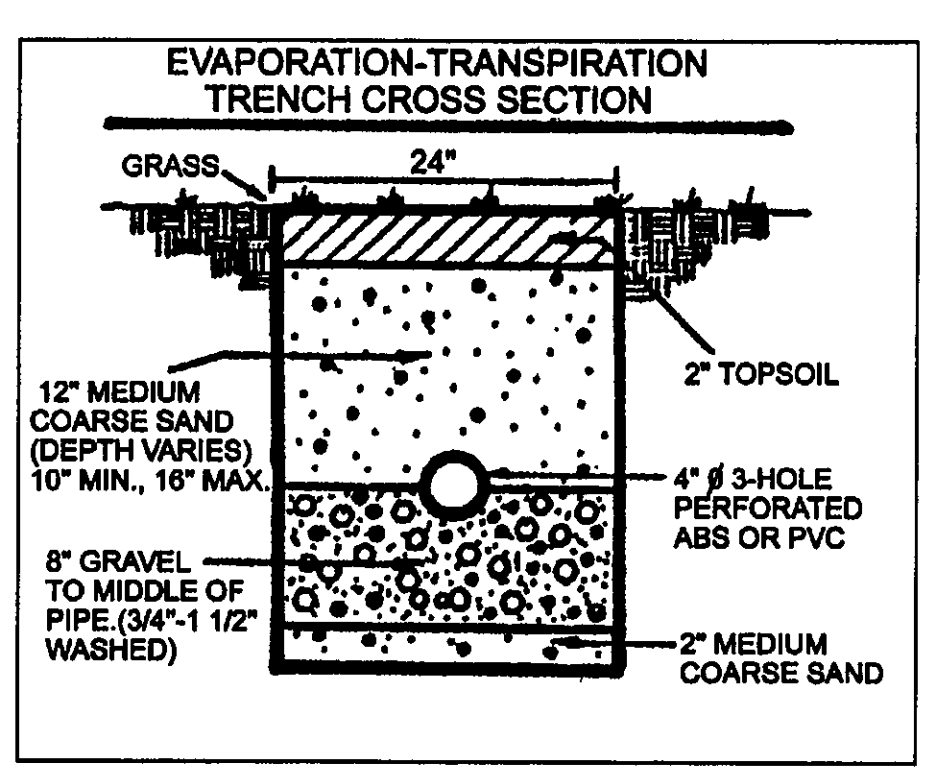


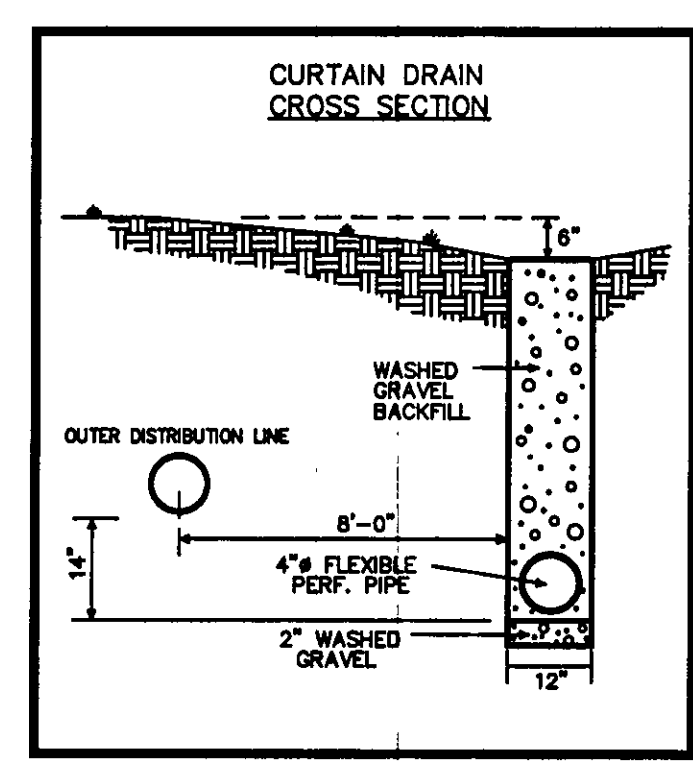


Grading Plan Approved
as shown and/or noted
JAMES R. GILLS, P.E.
Lake County Engineer
By *AMJ* Date *7/2/03*

CONCORD TOWNSHIP ZONING OFFICE
ZONING PERMIT # 0203-11149
ISSUED 7/2/03
SUBJECT TO APPROVAL BY:
☒ Lake Co. Common Engineer
☒ Lake Co. Eng. Dept.
☒ Lake Co. Planning Comm.
☒ Lake Co. Building Dept.
☒ Lake Co. Soil & Water Cons. Dist.

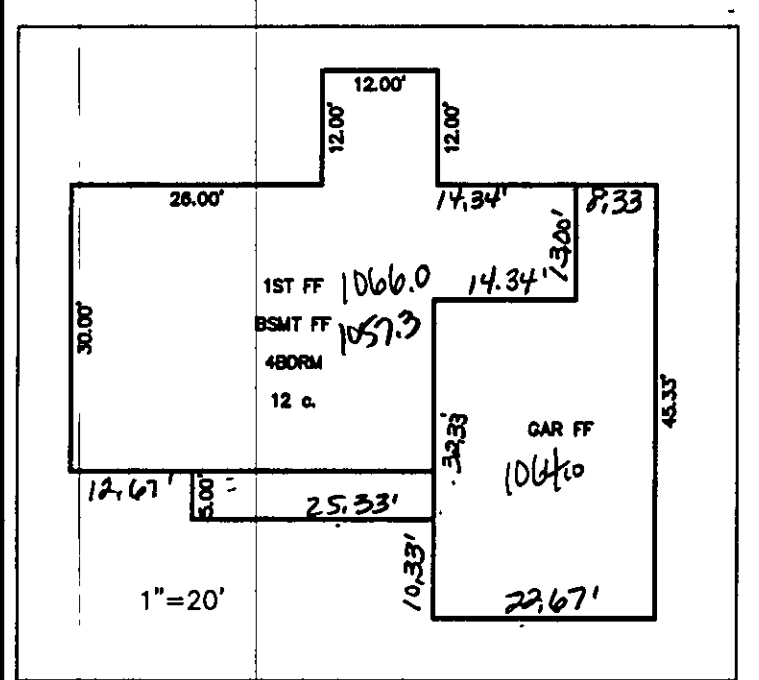


REVIEWED AND ACCEPTED
LAKE COUNTY GENERAL
HEALTH DISTRICT
Date 7-15-03 BY DQU
SEWAGE DISPOSAL PERMIT MUST BE
OBTAINED BY A LAKE COUNTY LICENSED
INSTALLER BEFORE INSTALLATION IS
STARTED.

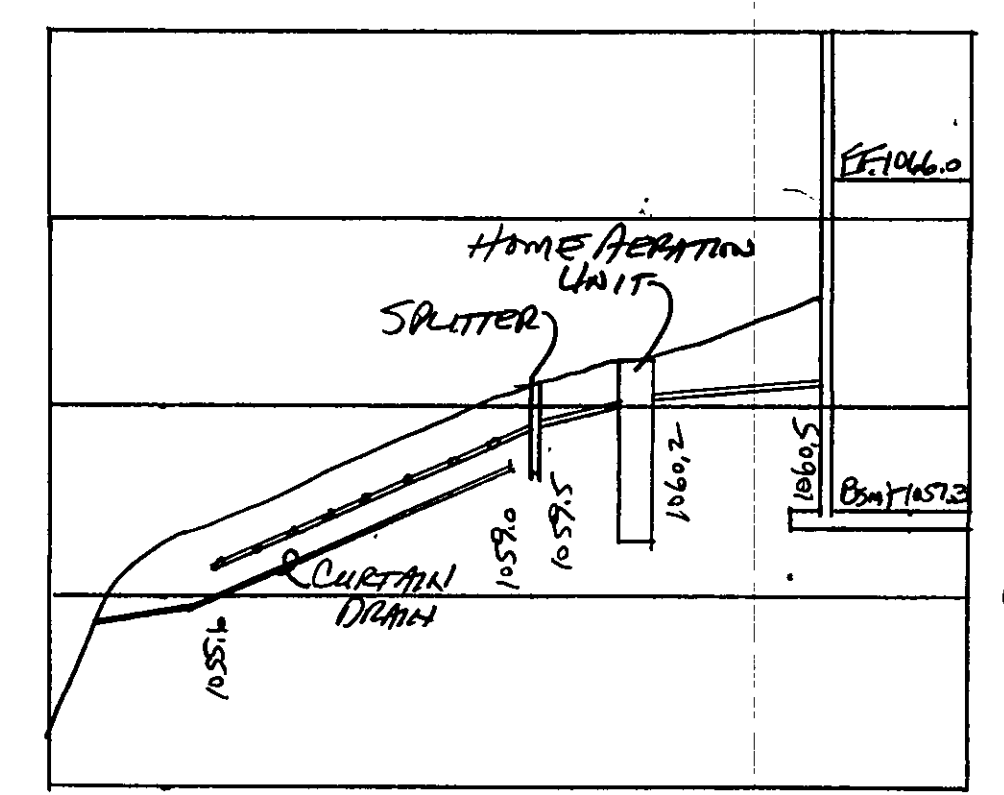

HYDRAULIC PROFILE
HORIZ: 1"=30' VERT: 1"=5'

"I, the undersigned hereby certify that
this topography indicated by 6", 1" or 2"
contours, and elevations shown herein
represent an actual field survey made by
me on the 24 day of JULY, 2003
and that the elevations were taken at
appropriate intervals and that as of that
date they existed as indicated hereon."
Name James R. Gills Reg. No. 10573

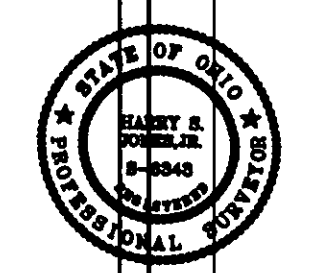

REV. NO.	DESCRIPTION	DATE	BY	CHK'D

bj BABCOCK, JONES AND ASSOCIATES, INC
CIVIL ENGINEERS - SURVEYORS - LAND PLANNERS
PAINESVILLE OHIO 44077

DATE 7/1/03
DESIGN BY H.J.
DRAWN BY B.P.
APPROVED BY H.J.

SITE PLAN
FOR
SHAMROCK CONSTRUCTION
S/L 38 STANFORD SPRINGS
CONCORD TOWNSHIP LAKE COUNTY STATE OF OHIO

SCALE	1"=30'
JOB NO.	98-185-38
SHEET	1
OF	1