


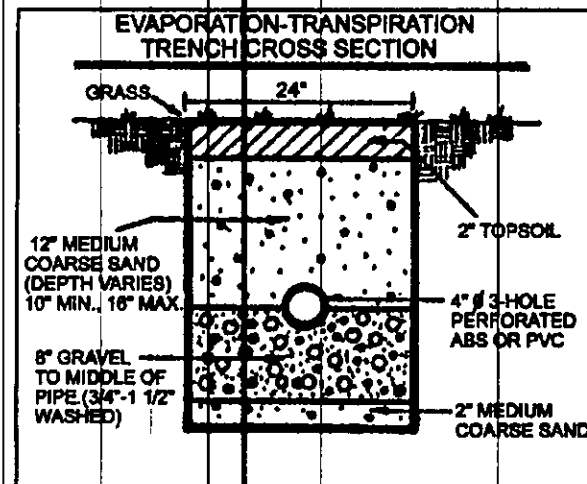


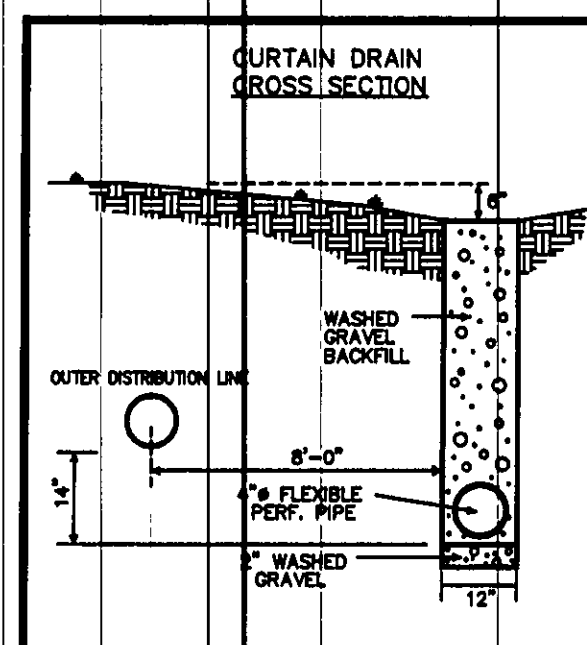

REVIEWED AND ACCEPTED
LAKE COUNTY GENERAL
HEALTH DISTRICT
DATE 2/26/01 BY [Signature]
SEWAGE DISPOSAL PERMIT MUST BE
OBTAINED BY A LAKE COUNTY LICENSED
INSTALLER BEFORE INSTALLATION IS
STARTED

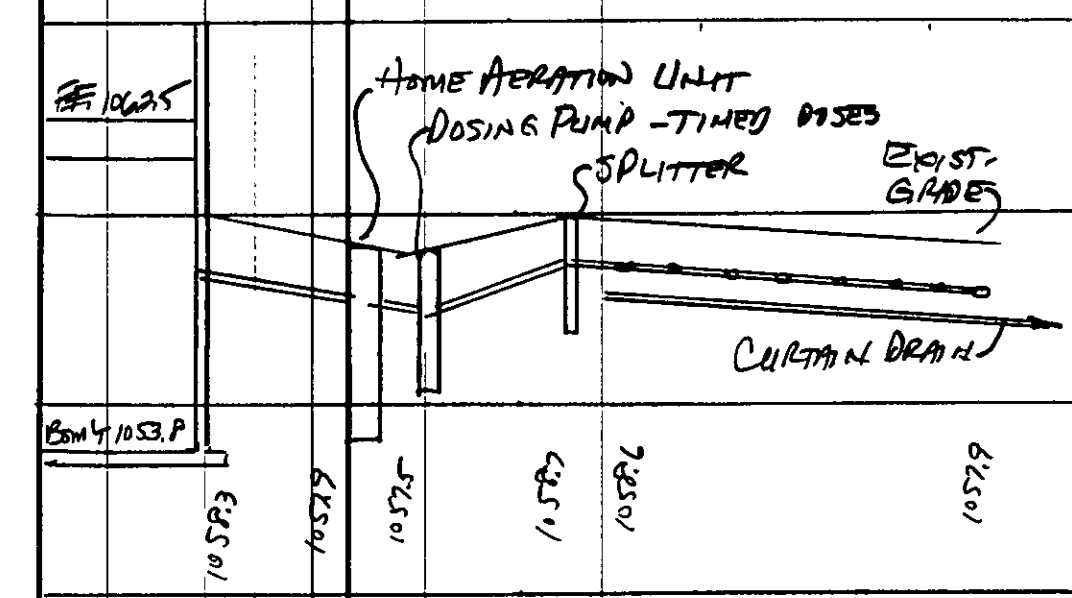

HYDRAULIC PROFILE
1/2\"/>

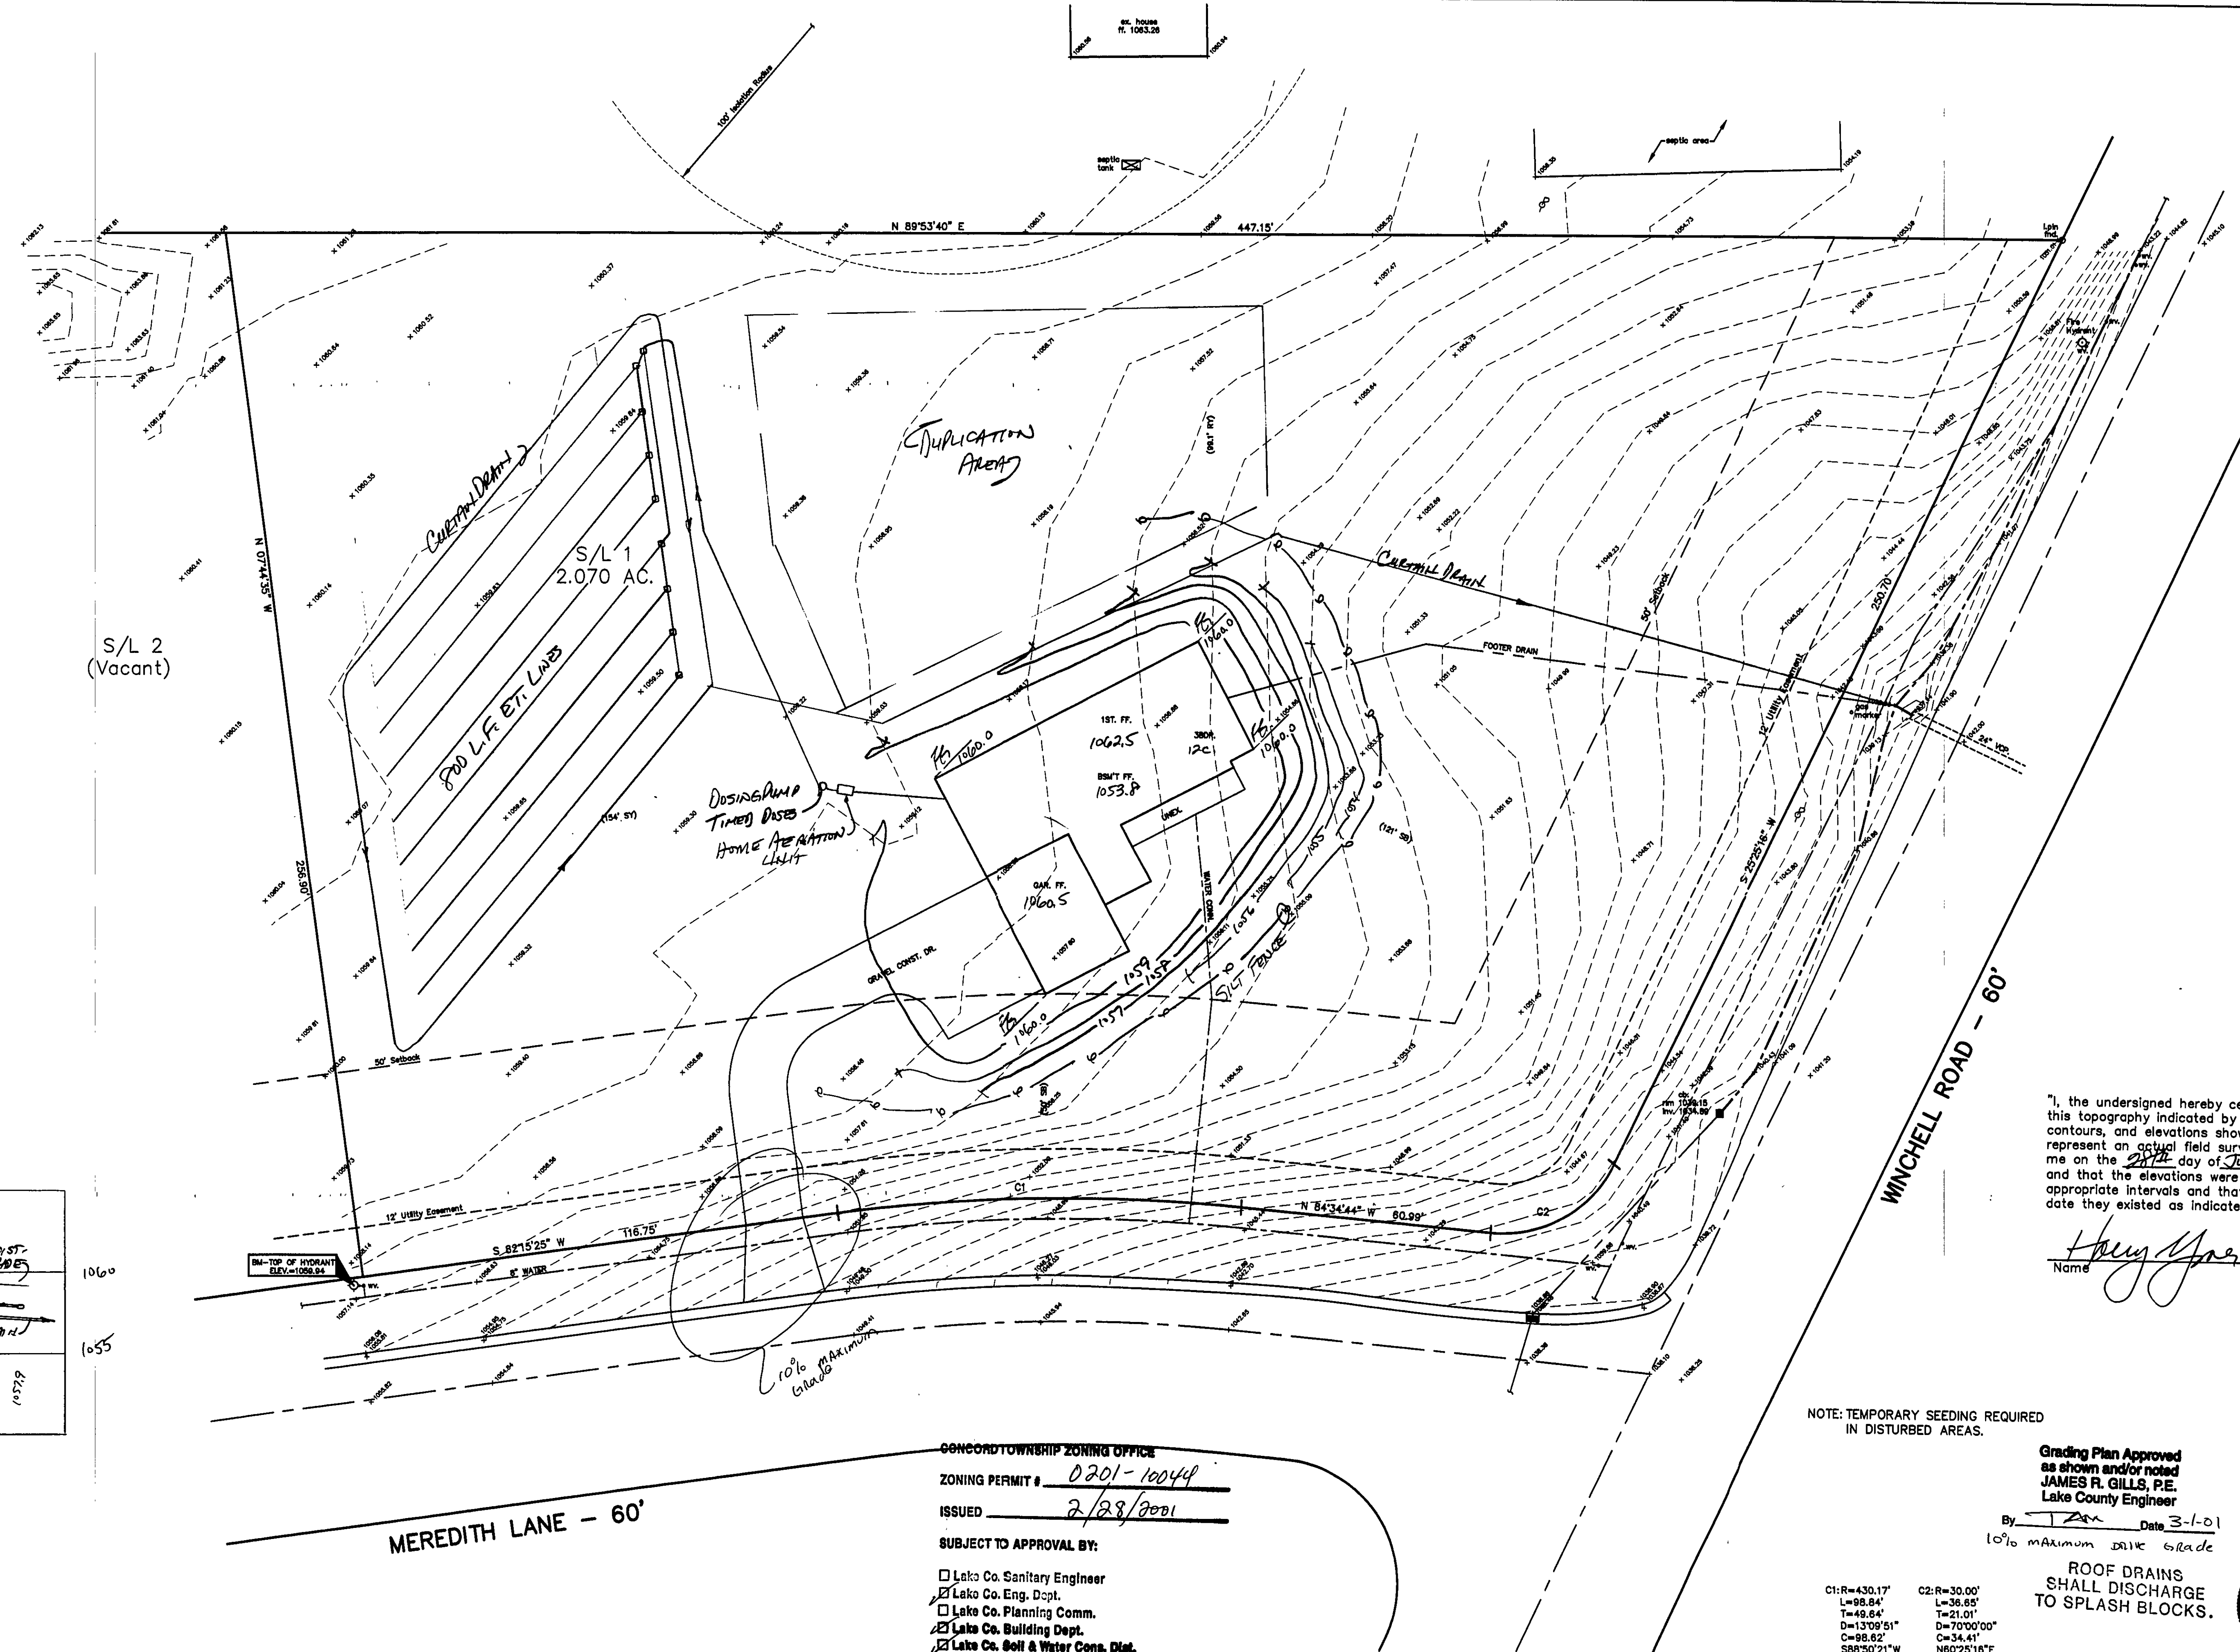

"I, the undersigned hereby certify that
this topography indicated by 6", 1", or 2"
contours, and elevations shown hereon
represent an actual field survey made by
me on the 28th day of July 2000
and that the elevations were taken at
appropriate intervals and that as of that
date they existed as indicated hereon."
Name [Signature] #6343 Reg. No.


NOTE: TEMPORARY SEEDING REQUIRED
IN DISTURBED AREAS.

Grading Plan Approved
as shown and/or noted
JAMES R. GILLS, P.E.
Lake County Engineer
By [Signature] Date 3-1-01
10% Maximum Dike Grade

ROOF DRAINS
SHALL DISCHARGE
TO SPLASH BLOCKS.

C1: R=430.17'
L=98.84'
T=49.84'
D=13'09"51"
C=98.62'
S88°50'21"W

C2: R=30.00'
L=36.65'
T=21.01'
D=70'00"00"
C=34.41'
N60°25'16"E

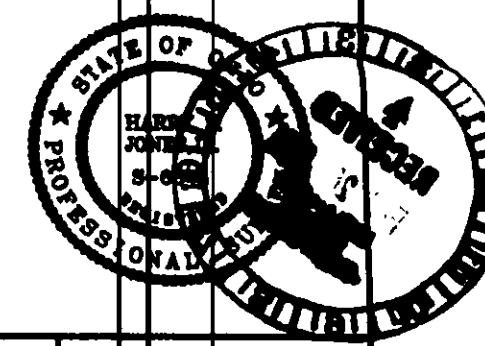

REV. NO.	DESCRIPTION	DATE	BY	CHK'D
1	REVISED PER L.C. HEALTH DEPT.	10/3/00	H.J.	H.J.
2	REVISED HOUSE	2/21/01	H.J.	H.J.




CONCORD TOWNSHIP ZONING OFFICE
ZONING PERMIT # 0201-10044
ISSUED 2/28/2001
SUBJECT TO APPROVAL BY:
☐ Lake Co. Sanitary Engineer
☒ Lake Co. Eng. Dept.
☐ Lake Co. Planning Comm.
☒ Lake Co. Building Dept.
☒ Lake Co. Soil & Water Cons. Dist.

bj BABCOCK, JONES AND ASSOCIATES, INC
CIVIL ENGINEERS - SURVEYORS - LAND PLANNERS
PAINESVILLE OHIO 44077

DATE 7/31/00
DESIGN BY H.J.
DRAWN BY T.R.
APPROVED BY H.J.

SITE PLAN
FOR
SHAMROCK CONSTRUCTION
S/L 1 STANFORD SPRINGS SUB.
CONCORD TOWNSHIP LAKE COUNTY


SCALE: 1"=20'
JOB NO. 98-185-01
SHEET 1 OF 1

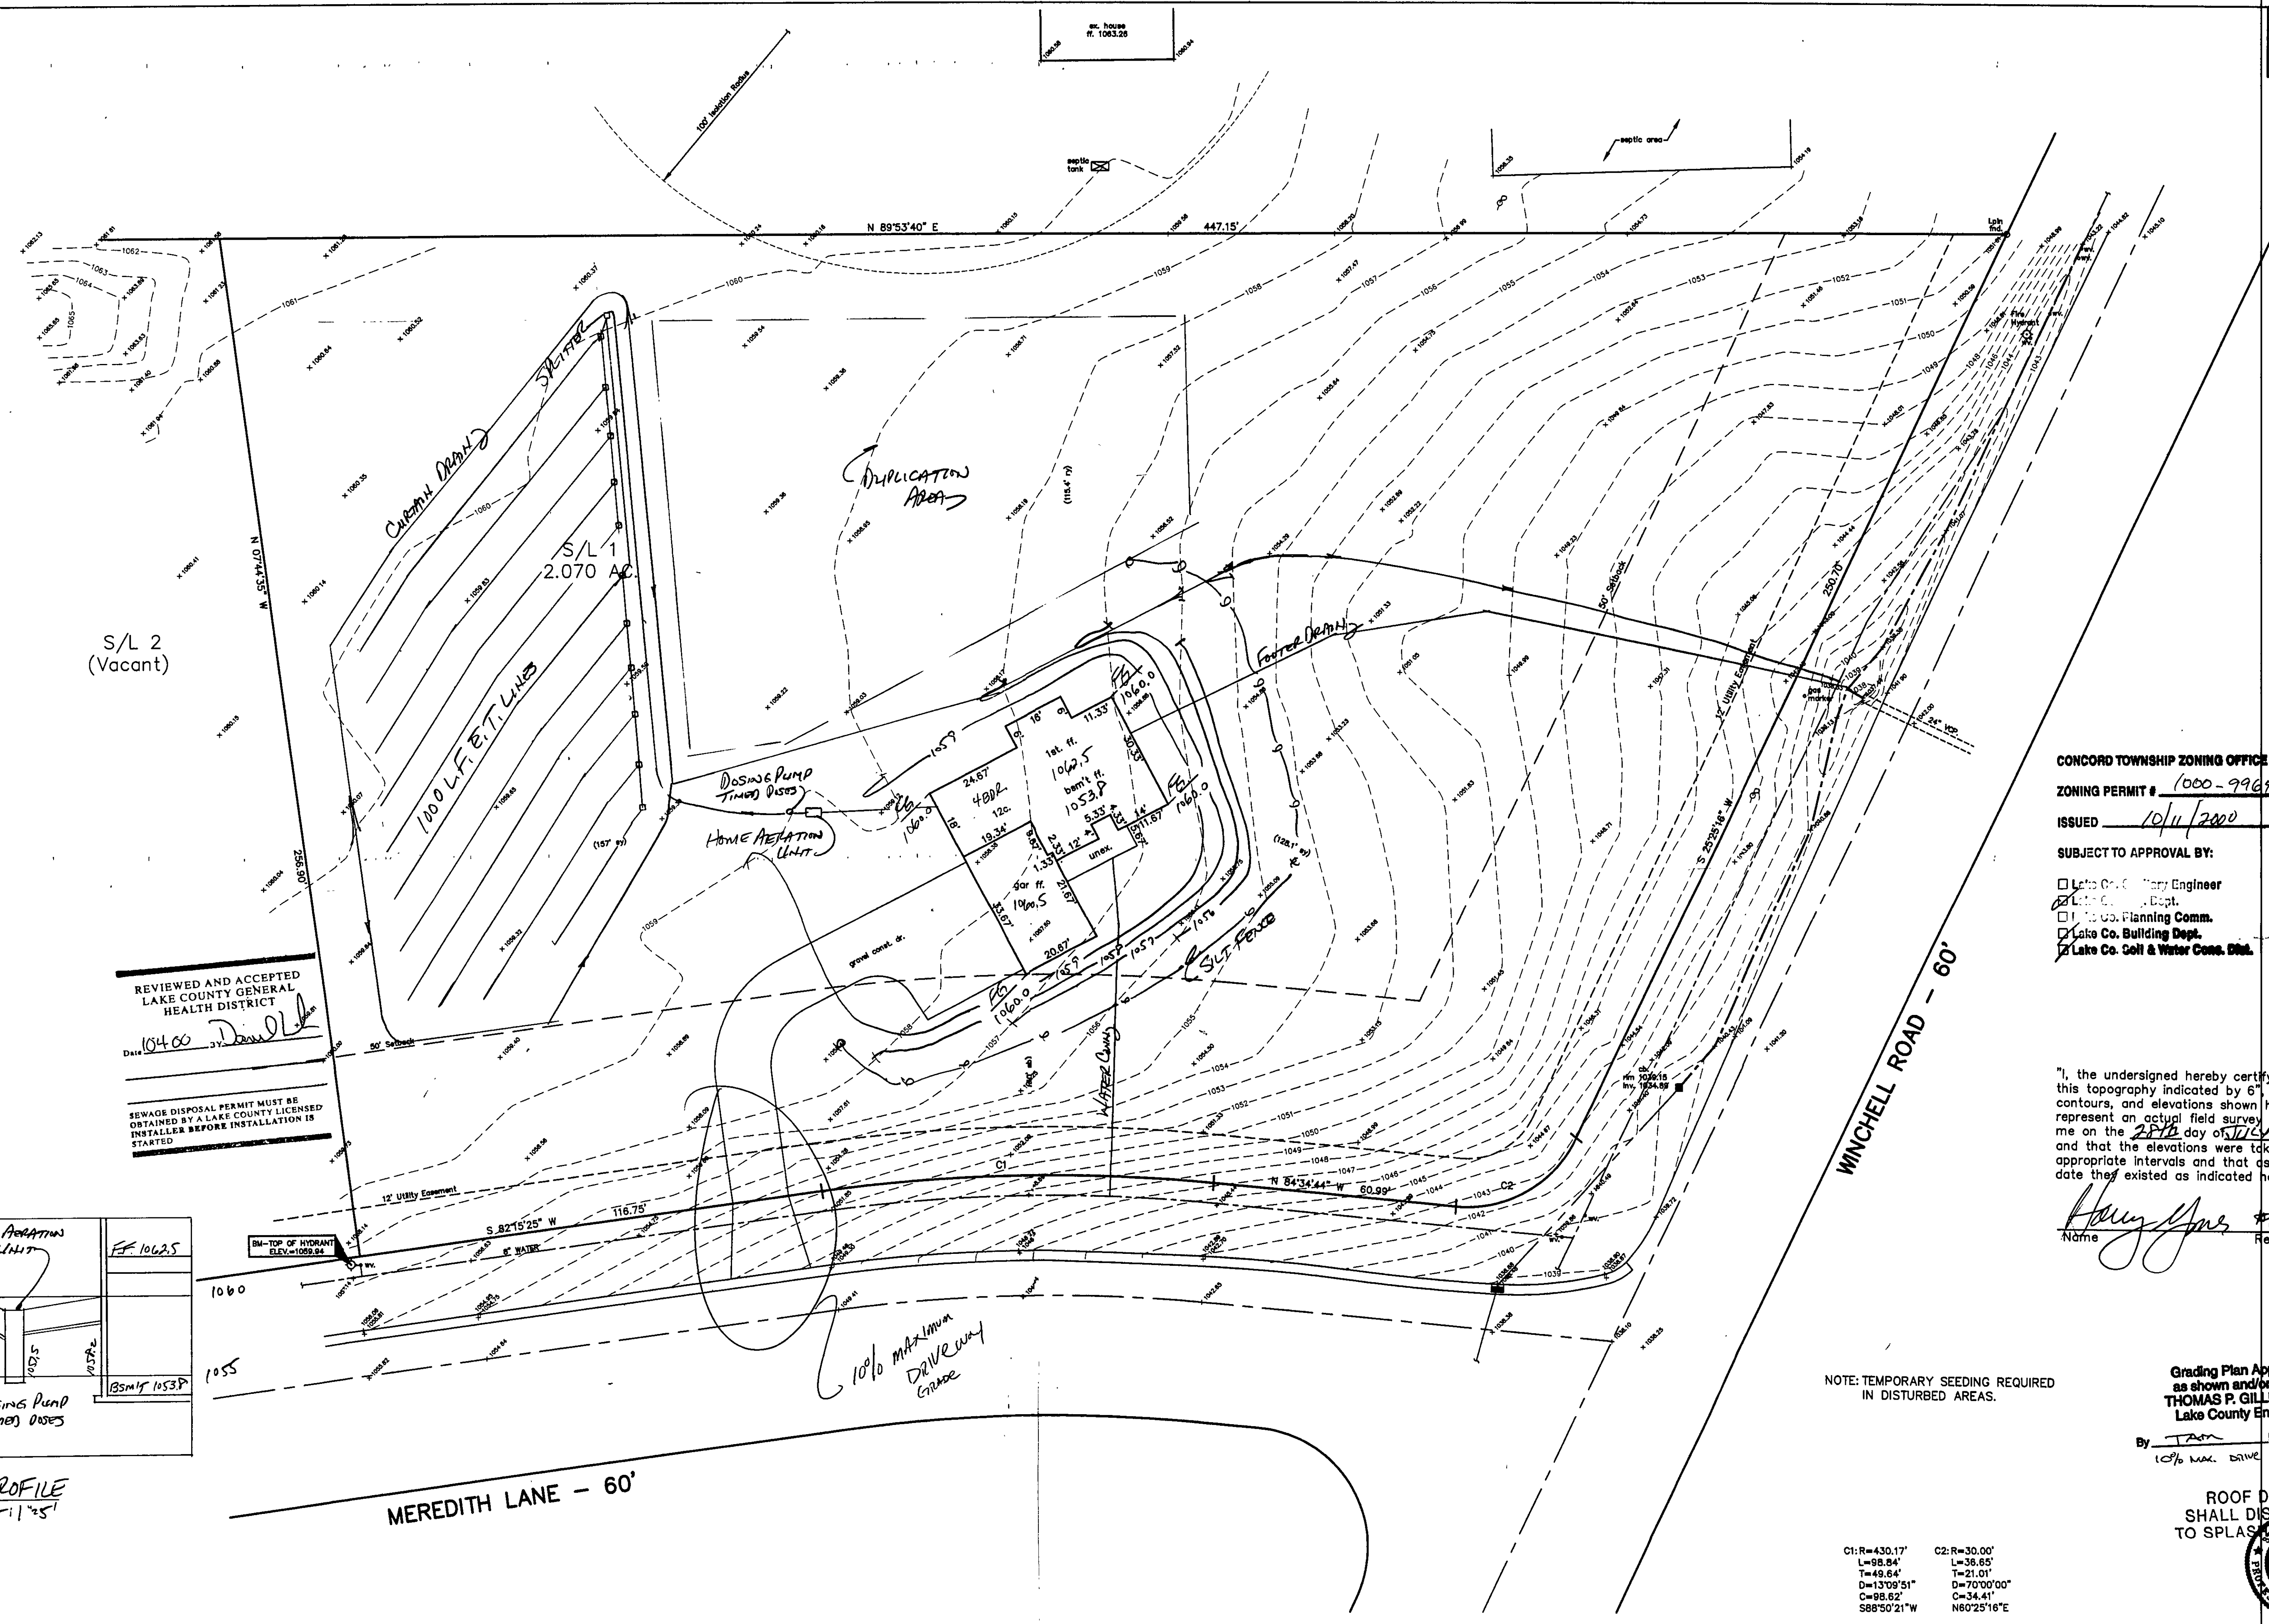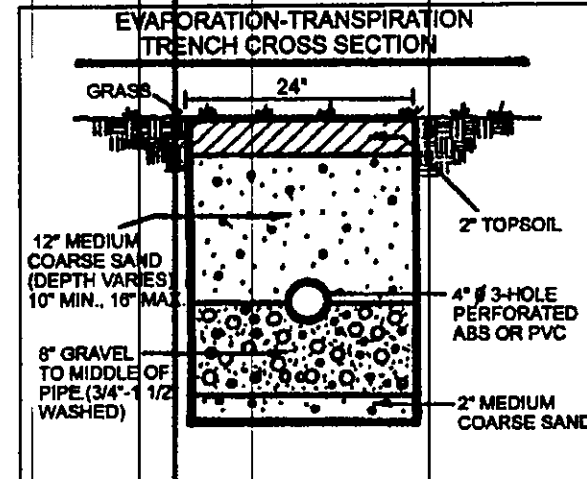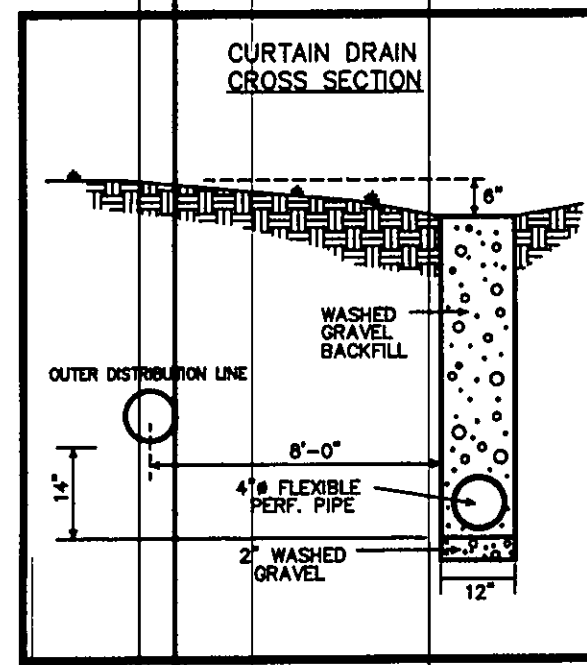

S/L 2 (Vacant)

REVIEWED AND ACCEPTED
LAKE COUNTY GENERAL
HEALTH DISTRICT
Date 10/4/00

SEWAGE DISPOSAL PERMIT MUST BE
OBTAINED BY A LAKE COUNTY LICENSED
INSTALLER BEFORE INSTALLATION IS
STARTED

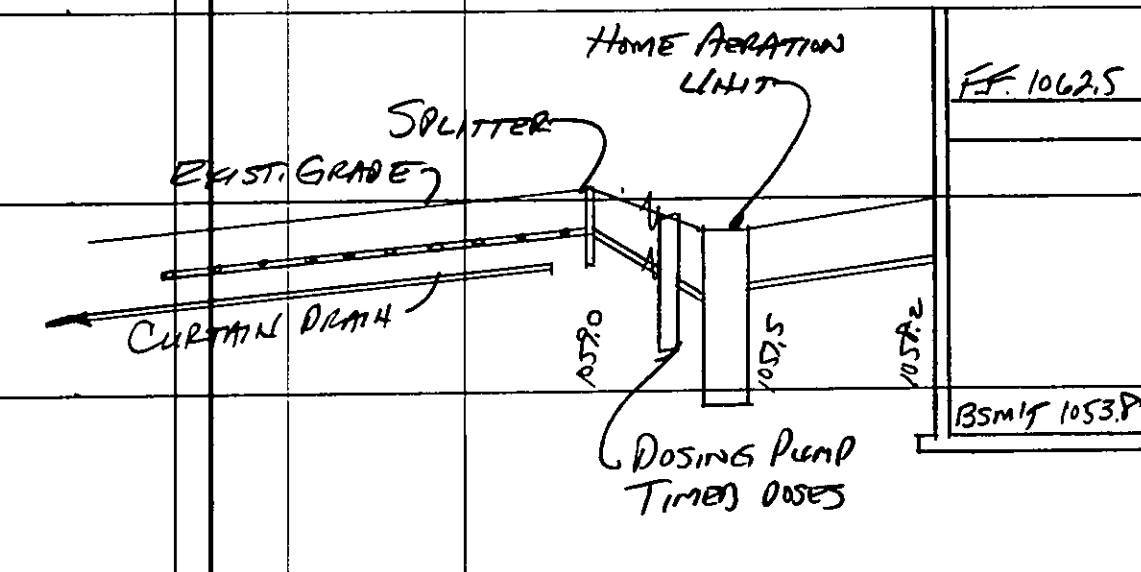

HYDRAULIC PROFILE
Horizontal 20' Vertical 1'±5'

CONCORD TOWNSHIP ZONING OFFICE
ZONING PERMIT # 1000-9964
ISSUED 10/11/2000
SUBJECT TO APPROVAL BY:
☐ Lake Co. Planning Comm.
☒ Lake Co. Building Dept.
☒ Lake Co. Soil & Water Cons. Dist.

"I, the undersigned hereby certify that
this topography indicated by 6", 1", or 2"
contours and elevations shown hereon
represent an actual field survey made by
me on the 28th day of July, 2000
and that the elevations were taken at
appropriate intervals and that as of that
date they existed as indicated hereon."
Name Harry S. Jones, Jr. #63443
Reg. No.

NOTE: TEMPORARY SEEDING REQUIRED
IN DISTURBED AREAS.

Grading Plan Approved
as shown and/or noted
THOMAS P. GILLES, P.E.
Lake County Engineer
By T.P.G. Date 12/13/00
10% MAX. DRIVE GRADE

ROOF DRAINS
SHALL DISCHARGE
TO SPLASH

C1: R=430.17' L=98.84' T=21.01' D=13'00" S1' C=98.62' S88°50'21"W
C2: R=30.00' L=36.65' T=21.01' D=70'00"00' C=34.41' N60°25'16"E

REV. NO.	DESCRIPTION	DATE	BY	CHK'D
1	Revisions per L.C. Health Dept	10/3/00	HT	HT

BABCOCK, JONES AND ASSOCIATES, INC
CIVIL ENGINEERS - SURVEYORS - LAND PLANNERS
PAINESVILLE OHIO 44077

DATE 7/31/00
DESIGN BY H.J.
DRAWN BY T.R.
APPROVED BY H.J.

SITE PLAN
FOR
SHAMROCK CONSTRUCTION
S/L 1 STANFORD SPRINGS SUB.
CONCORD TOWNSHIP LAKE COUNTY
SCALE: 1"=20'
JOB NO 98-185-01
SHEET 1 OF 1