



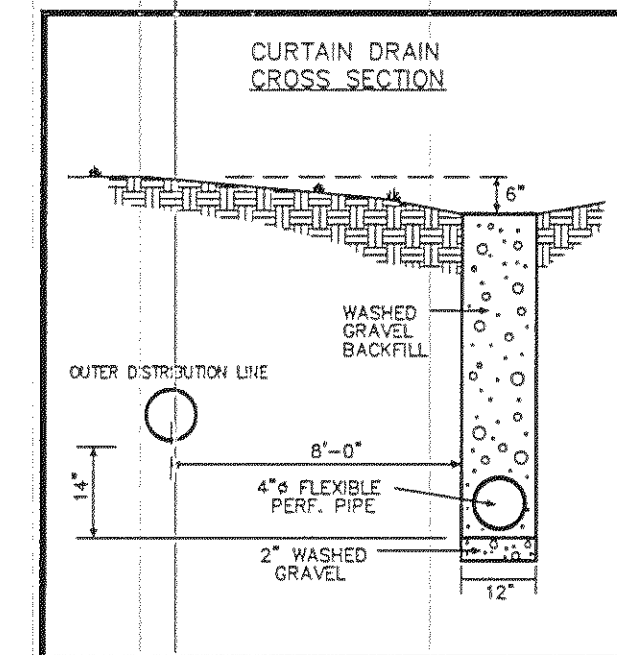

CURVE TABLE						
CURVE	LENGTH	RADIUS	TANGENT	CHORD	BEARING	DELTA
C1	69.90	530.00	35.00	69.85	S37°02'30"E	07°33'24"
C2	15.00	530.00	7.50	15.00	S41°37'51"E	01°37'18"

NOTE: TEMPORARY SEEDING REQUIRED
IN DISTURBED AREAS.

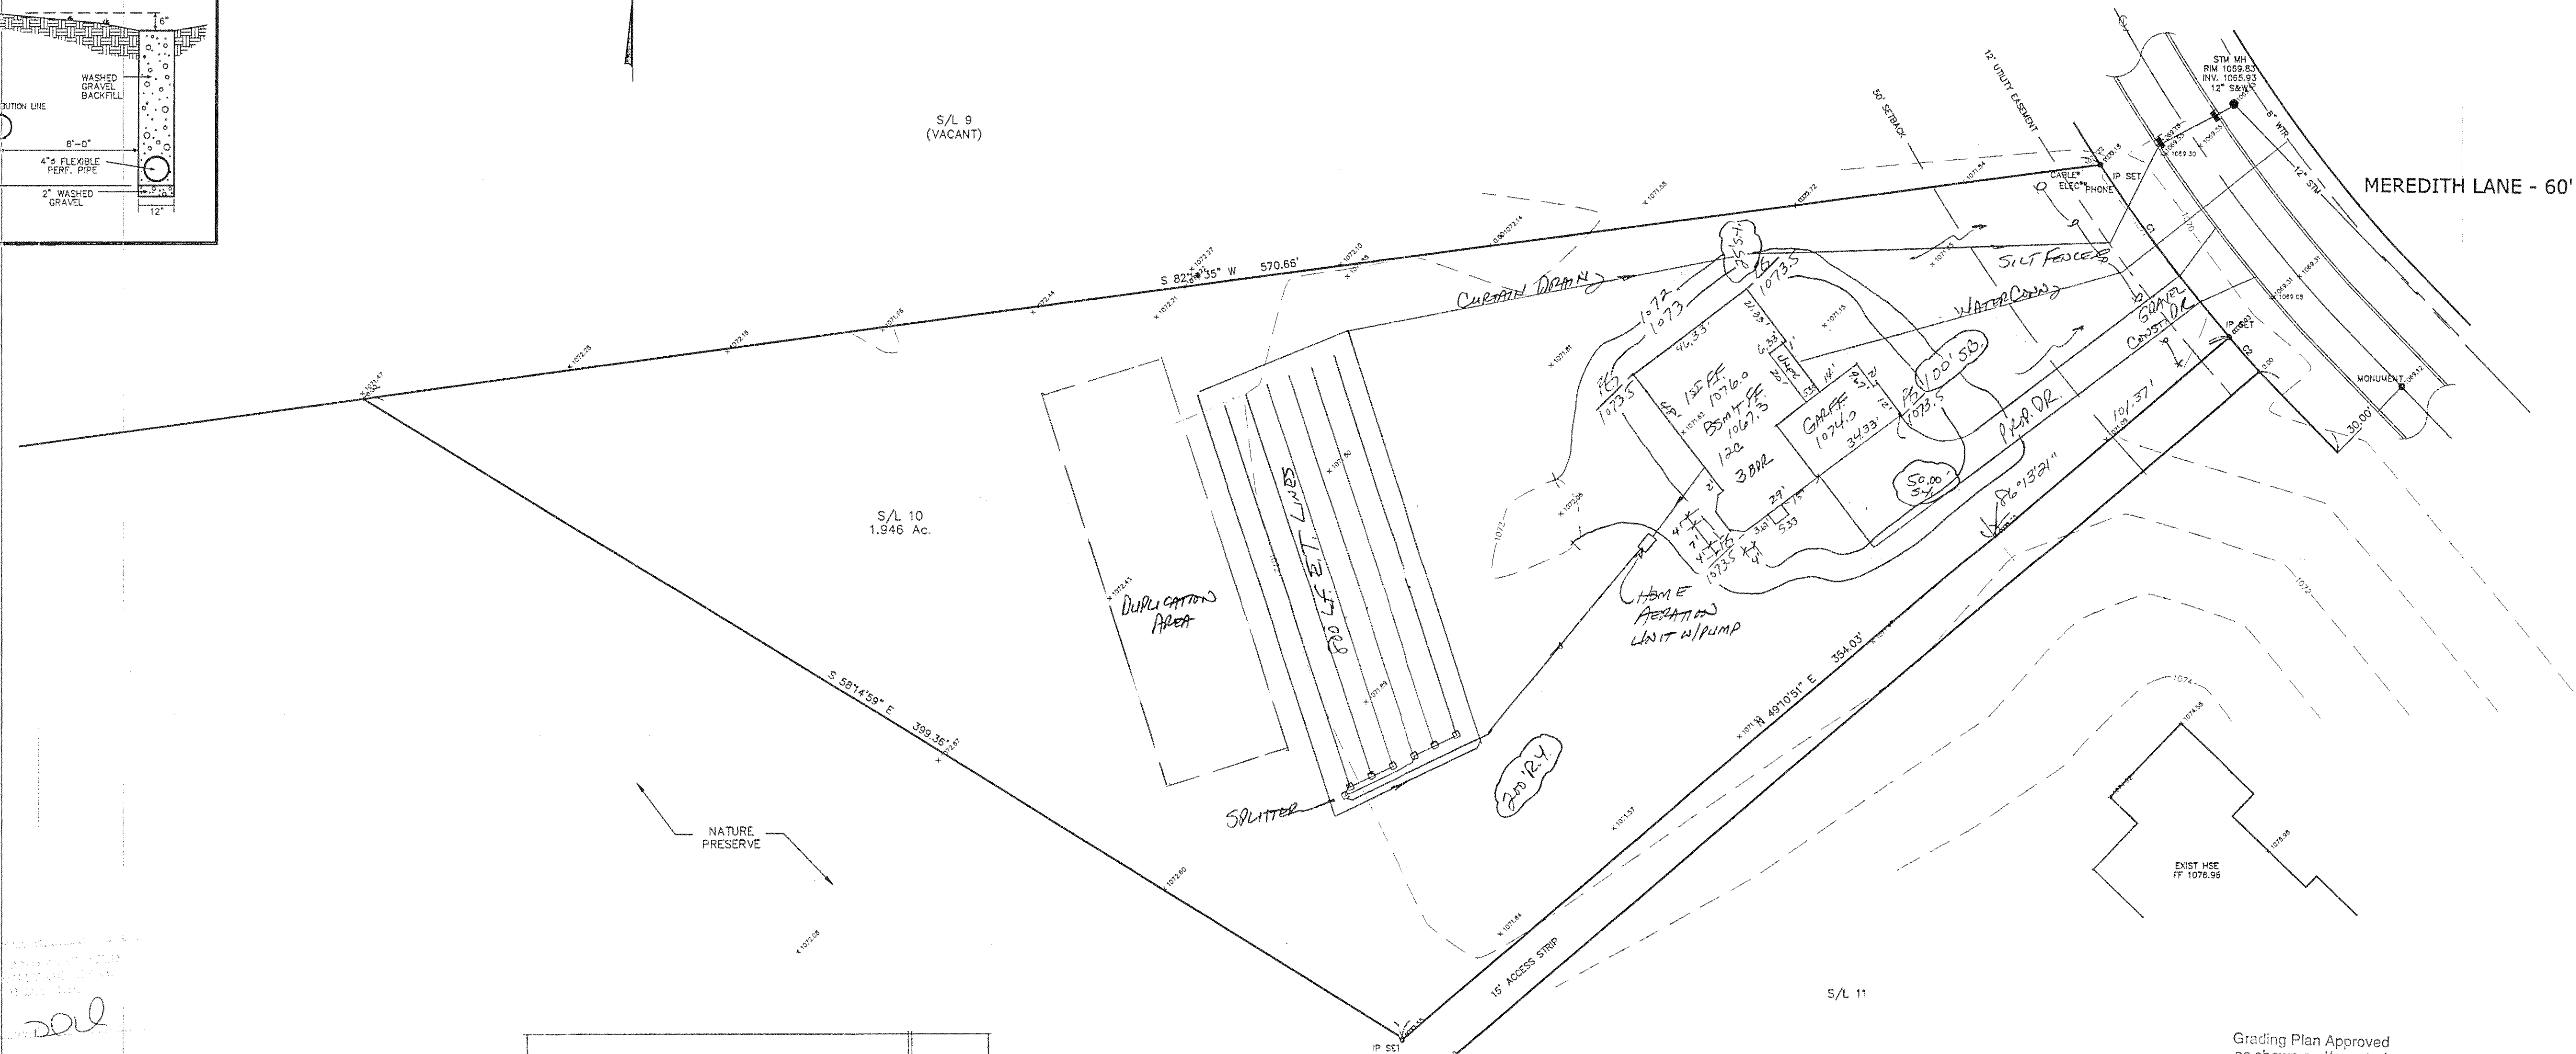

"I, the undersigned hereby certify that this topography indicated by 6", 1", or 2" contours, and elevations shown hereon represent an actual field survey made by me on the 24th day of OCT, 2008 and that the elevations were taken at appropriate intervals and that as of that date they existed as indicated hereon."


 Name Harry Jones #6343 Reg. No.

Grading Plan Approved
as shown and/or noted
JAMES R. GILLS, P.E.
Lake County Engineer

By FW Date 1/18/02

CONCORD TOWNSHIP ZONING OFFICE

ZONING PERMIT # 1102-10844

ISSUED 1102-10844

SUBJECT TO APPROVAL BY:


☒ Lake Co. Sanitary Engineer
☒ Lake Co. Eng. Dept.
☐ Lake Co. Planning Comm.
☒ Lake Co. Building Dept.
☒ Lake Co. Soil & Water Cons. Dist.

LAKE COUNTY DEPARTMENT OF UTILITIES
No L.C.D.U. SANITARY SEWERS AVAILABLE
 * L.C.D.U. WATERLINE AVAILABLE

Douglas D. Bradley DATE 11/15/02
* By OTHERS

BM - IRON PIN MONUMENT @ C&C
OF MEREDITH LANE & WINDSONG TRAIL
ELEV. - 1067.42

EXISTING UTILITIES NOTE:
THE SIZE AND LOCATION, BOTH HORIZONTAL AND VERTICAL
OF THE UNDERGROUND UTILITIES SHOWN HEREON, HAVE BEEN
OBTAINED BY A SEARCH OF AVAILABLE RECORDS.
VERIFICATION BY FIELD OBSERVATION HAS BEEN CONDUCTED
WHERE PRACTICAL, HOWEVER, BABCOCK, JONES AND ASSOCIATES
INC. DOES NOT GUARANTEE THE COMPLETENESS NOR ACCURACY
THEREOF.

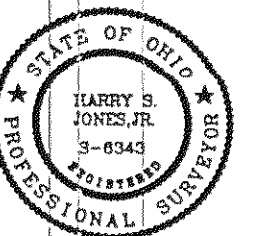

HYDRAULIC PROFILE

[illegible]

BABCOCK, JONES AND ASSOCIATES, INC
CIVIL ENGINEERS – SURVEYORS – LAND PLANNERS
PAINESVILLE OHIO 44077

DATE	10/28/02
DESIGN BY	H.J.
DRAWN BY	B.P.
APPROVED BY	H.J.

SITE PLAN
FOR
SHAMROCK

TOWNSHIP OF CONCORD	COUNTY OF LAKE	STATE OF OHIO
---------------------	----------------	---------------

SCALE	1"=30'
JOB NO	98-185-10
SHEET	OF
1	1