
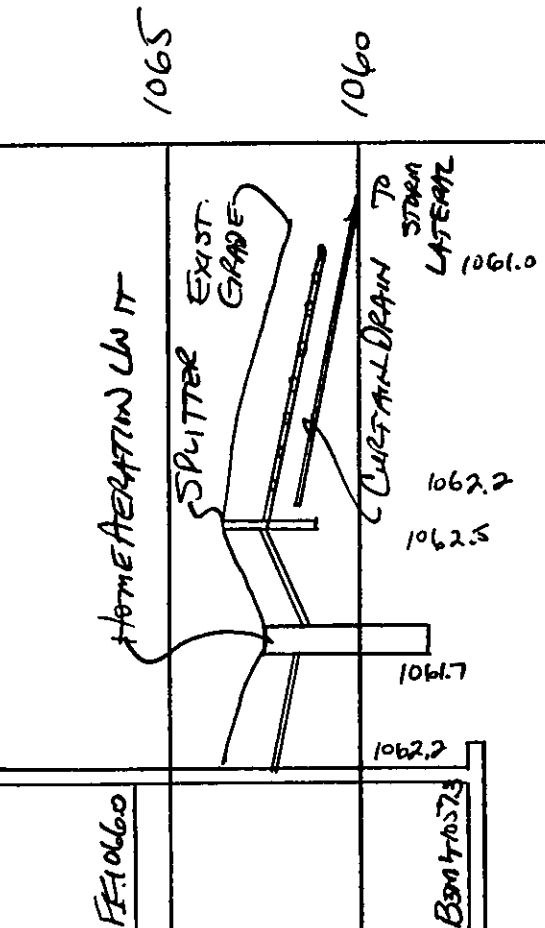
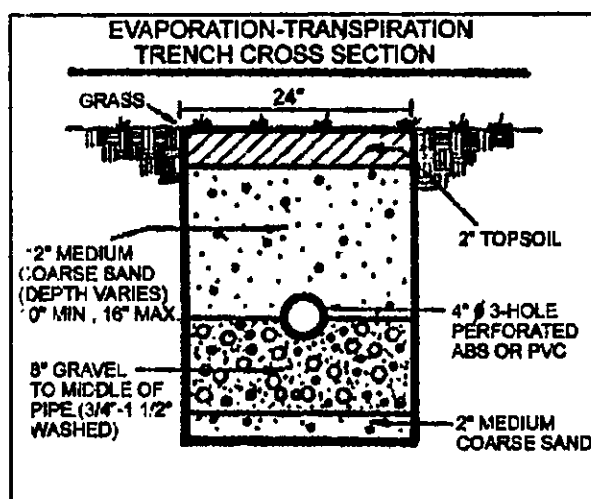


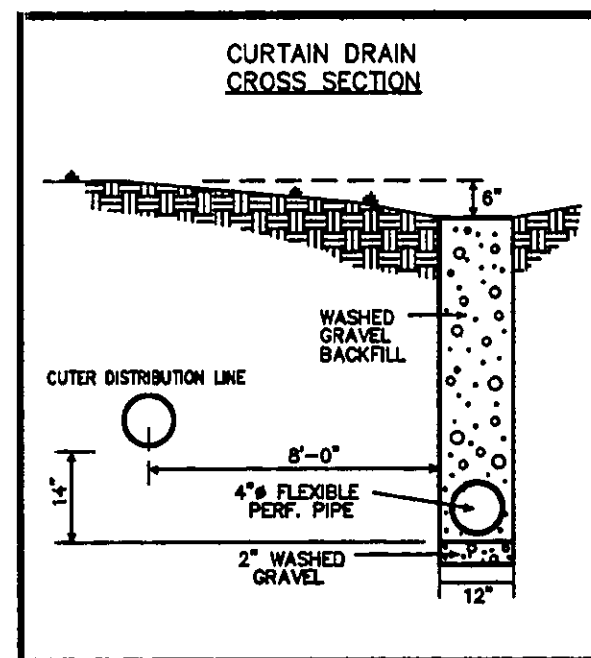


REVIEWED AND ACCEPTED
LAKE COUNTY GENERAL
HEALTH DISTRICT

Date 4-3-02 BY *Daniell*
Fairloafe pump needed

SEWAGE DISPOSAL PERMIT MUST BE
OBTAINED BY A LAKE COUNTY LICENSED
INSTALLER BEFORE INSTALLATION IS
STARTED

STM. MH.
RIM 1060.99
INV. 1058.00

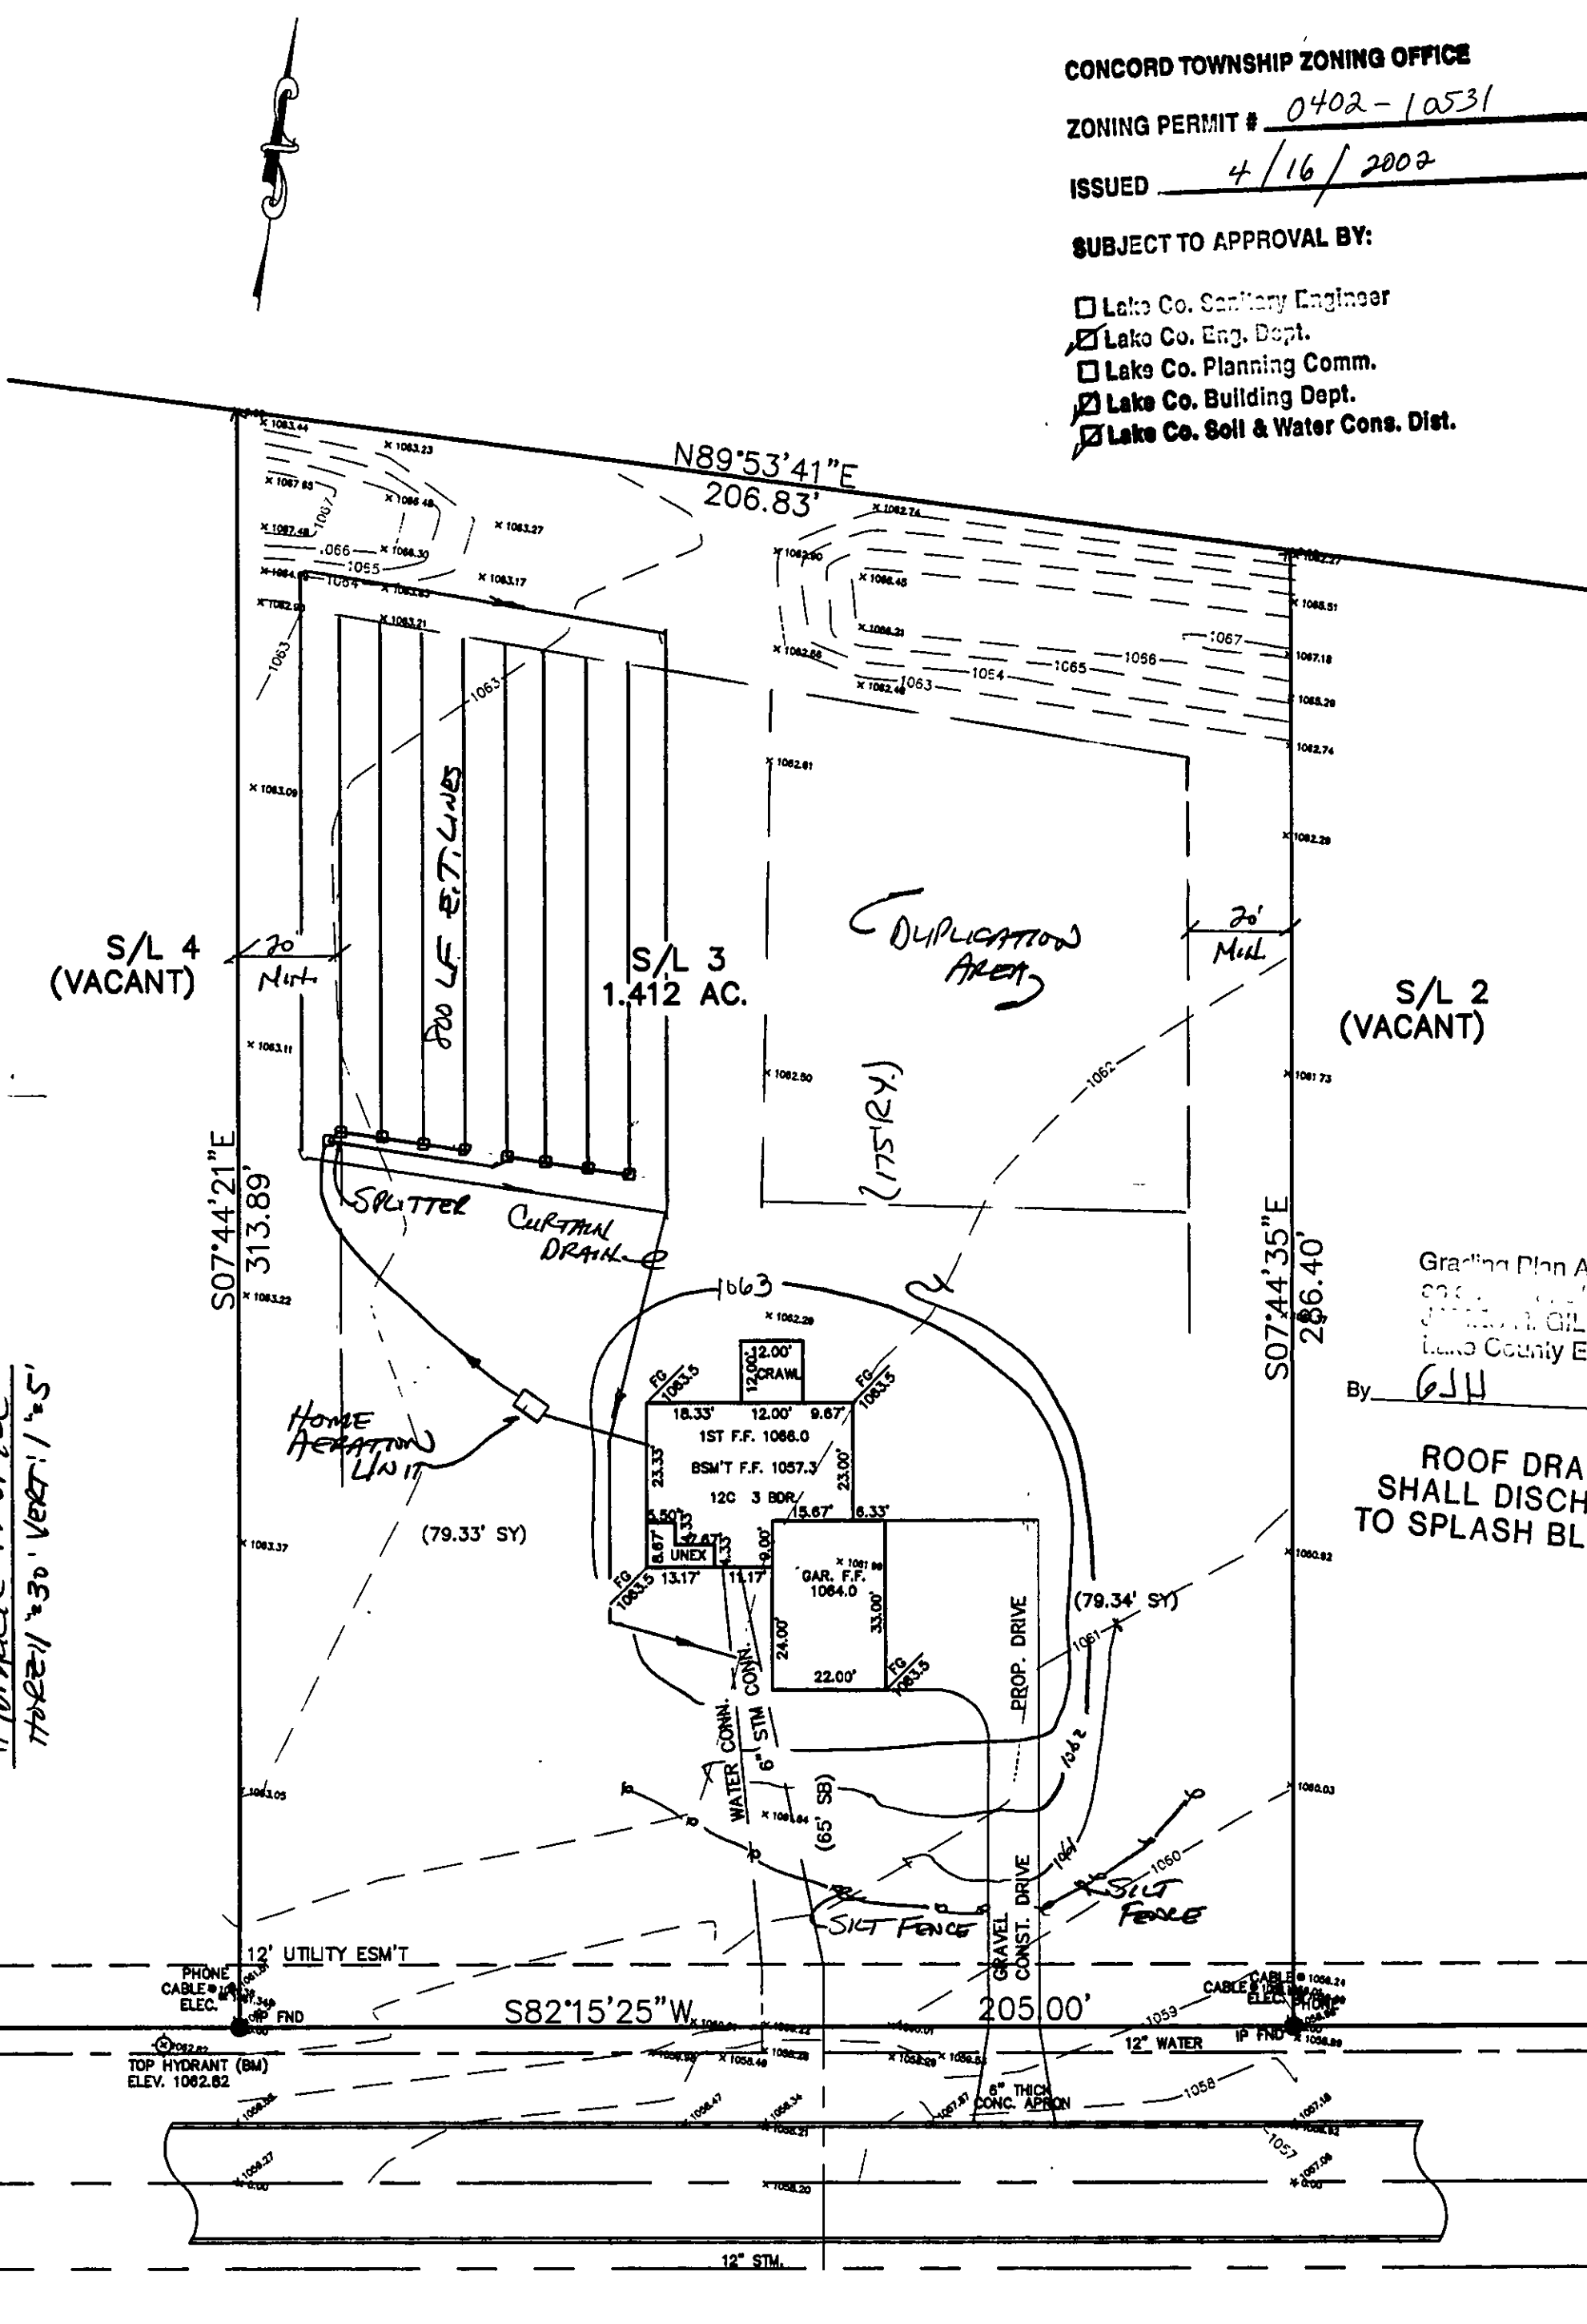

CONCORD TOWNSHIP ZONING OFFICE

ZONING PERMIT # 0402-10531

ISSUED 4/16/2002

SUBJECT TO APPROVAL BY:

- ☐ Lake Co. Sanitary Engineer
- ☒ Lake Co. Eng. Dept.
- ☐ Lake Co. Planning Comm.
- ☒ Lake Co. Building Dept.
- ☒ Lake Co. Soil & Water Cons. Dist.

SITE PLAN

CONCORD TOWNSHIP, LAKE COUNTY, OHIO

for: **SHAMROCK CONSTRUCTION**

CLIENT		OWNER	
ADDRESS	STREET	CITY	ZIP
STANFORD SPRINGS			
SUBDIVISION	38-31	NAME	TRACT
VOL-PG.	100-10	LOT	STREET
3		MEREDITH LANE	
SUBLOT NO.	STREET	VOL-PG.	PERM. PARCEL NO.

LEGEND

- SANITARY MANHOLE --- ○
- STORM MANHOLE --- ●
- INLET OR CATCH BASIN --- ◐
- HYDRANT --- ⦿
- EXISTING CONTOURS --- - - - -
- PROPOSED CONTOURS --- ————
- EXIST. ELEV. 1000.00
- AS BUILT ELEVATION
- INDICATES DIRECTION OF SURFACE DRAINAGE

REMARKS

ALL BOUNDARY DATA SHOWN WAS OBTAINED FROM (DEEDS, RECORDED SUBDIVISION PLAT OR OTHER PUBLIC RECORDS)

LOCATIONS AS SHOWN OF ADJACENT WELLS AND SEPTIC TANKS OBTAINED FROM LAKE COUNTY HEALTH DEPARTMENT

DESIGN CERTIFICATION

THIS PLAT WAS PREPARED BY ME, AND IS CORRECT TO THE BEST OF MY KNOWLEDGE AND BELIEF.

NAME *Harry Jones* #6343

CHECK LIST

- | | |
|---------------------------------|---|
| NO. OF BEDROOMS | WATER MAIN SIZE, LOCATION |
| DIMENSIONS | SAN. SEWER SIZE & GR. LOC. |
| BEARINGS | SAN. MH. CAST. ELEV. INV. ELEV. |
| TIE TO NEAREST STREET | SAN. CONN. SIZE, LOC. DEPTH |
| SUBLOT NO. PARCEL NO. | STORM SEWER SIZE & GR. LOC. |
| SURROUNDING OWNERS | STORM MH. CAST ELEV. INV. ELEV. |
| BLDG. DIMENSIONS FIN GR. | PAV'T TYPE GRADE CURBS |
| BLDG. TIES FL'T. GRADES | GAS LINE LOC. SIZE PRESSURE |
| APRON TYPE WIDTH THICKNESS | SEPTIC TANK LOCATION & DUPLICATION AREA |
| SEWAGE TIE TYPE WIDTH THICKNESS | WELL LOCATION |
| CULVERT TYPE DIA. LENGTH | ISOLATION RADIUS FROM WELL |
| ROCK OUTCROPPINGS | |

REVISIONS			PLAN PREPARED BY:	
NO.	DATE	BY	BABCOCK JONES & ASSOCIATES, INC.	
1			PAINESVILLE, OHIO	
2			DRAWN BY M.M.	SCALE 1"=30'
3			CHK'D. H.J.	DATE 3/27/02
4			CREW EWH	APP'D H.J.
5			PHONE NO. 440-357-1811	
			DRAWING NO. 98-185-03	

"AS BUILT" CERTIFICATION

I, HEREBY CERTIFY THAT THE CIRCLED GRADES ARE EXISTING FINISH GRADES CHECKED IN THE FIELD ON 4/29/02, 2002 AND ARE CORRECT TO THE BEST OF MY KNOWLEDGE AND BELIEF.

REGISTERED SURVEYOR

REG. NO.

NOTE: TEMPORARY SEEDING REQUIRED IN DISTURBED AREAS.

BM-STORM MANHOLE
RIM=1064.00

"I, the undersigned hereby certify that this topography indicated by 6", 1', or 2' contours, and elevations shown hereon represent an actual field survey made by me on the 25th day of April, 2002 and that the elevations were taken at appropriate intervals and that as of that date they existed as indicated hereon."

Name *Harry Jones* #6343
Reg. No.

