

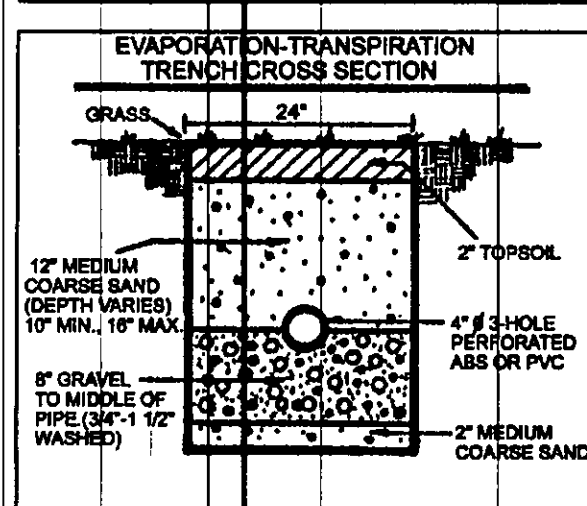


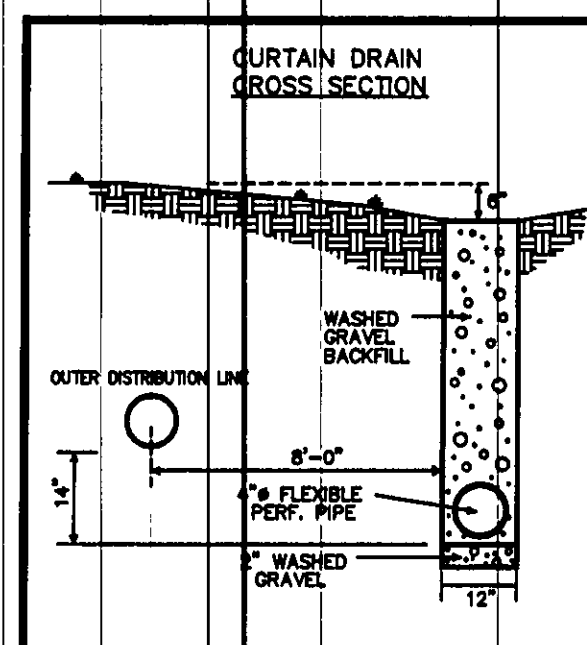


REVIEWED AND ACCEPTED
LAKE COUNTY GENERAL
HEALTH DISTRICT
DATE 2/26/01 BY [Signature]

SEWAGE DISPOSAL PERMIT MUST BE
OBTAINED BY A LAKE COUNTY LICENSED
INSTALLER BEFORE INSTALLATION IS
STARTED

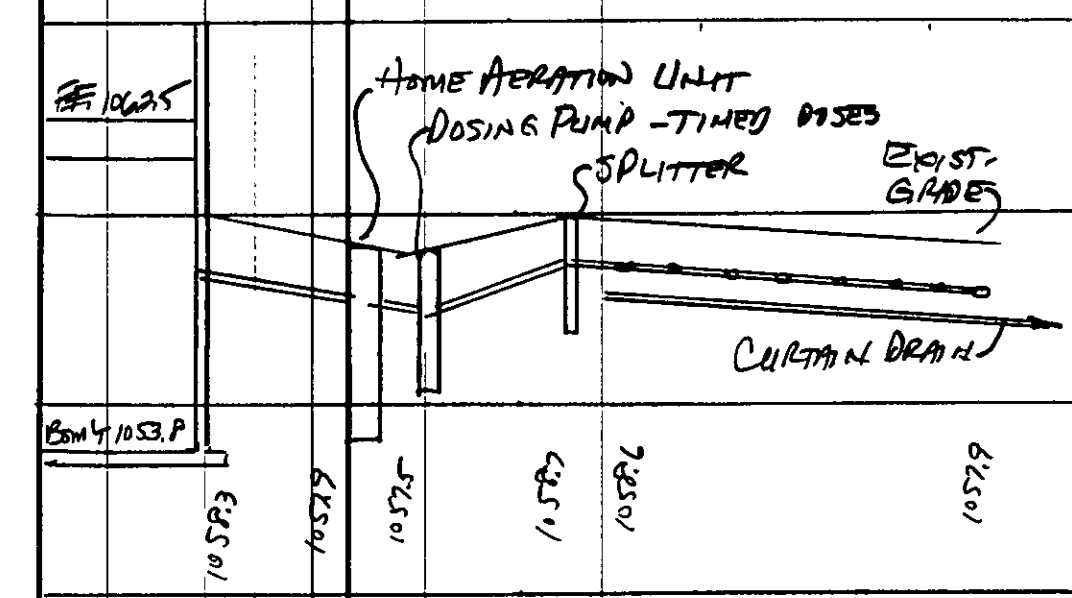

HYDRAULIC PROFILE
1" = 20' VERT 1" = 5'

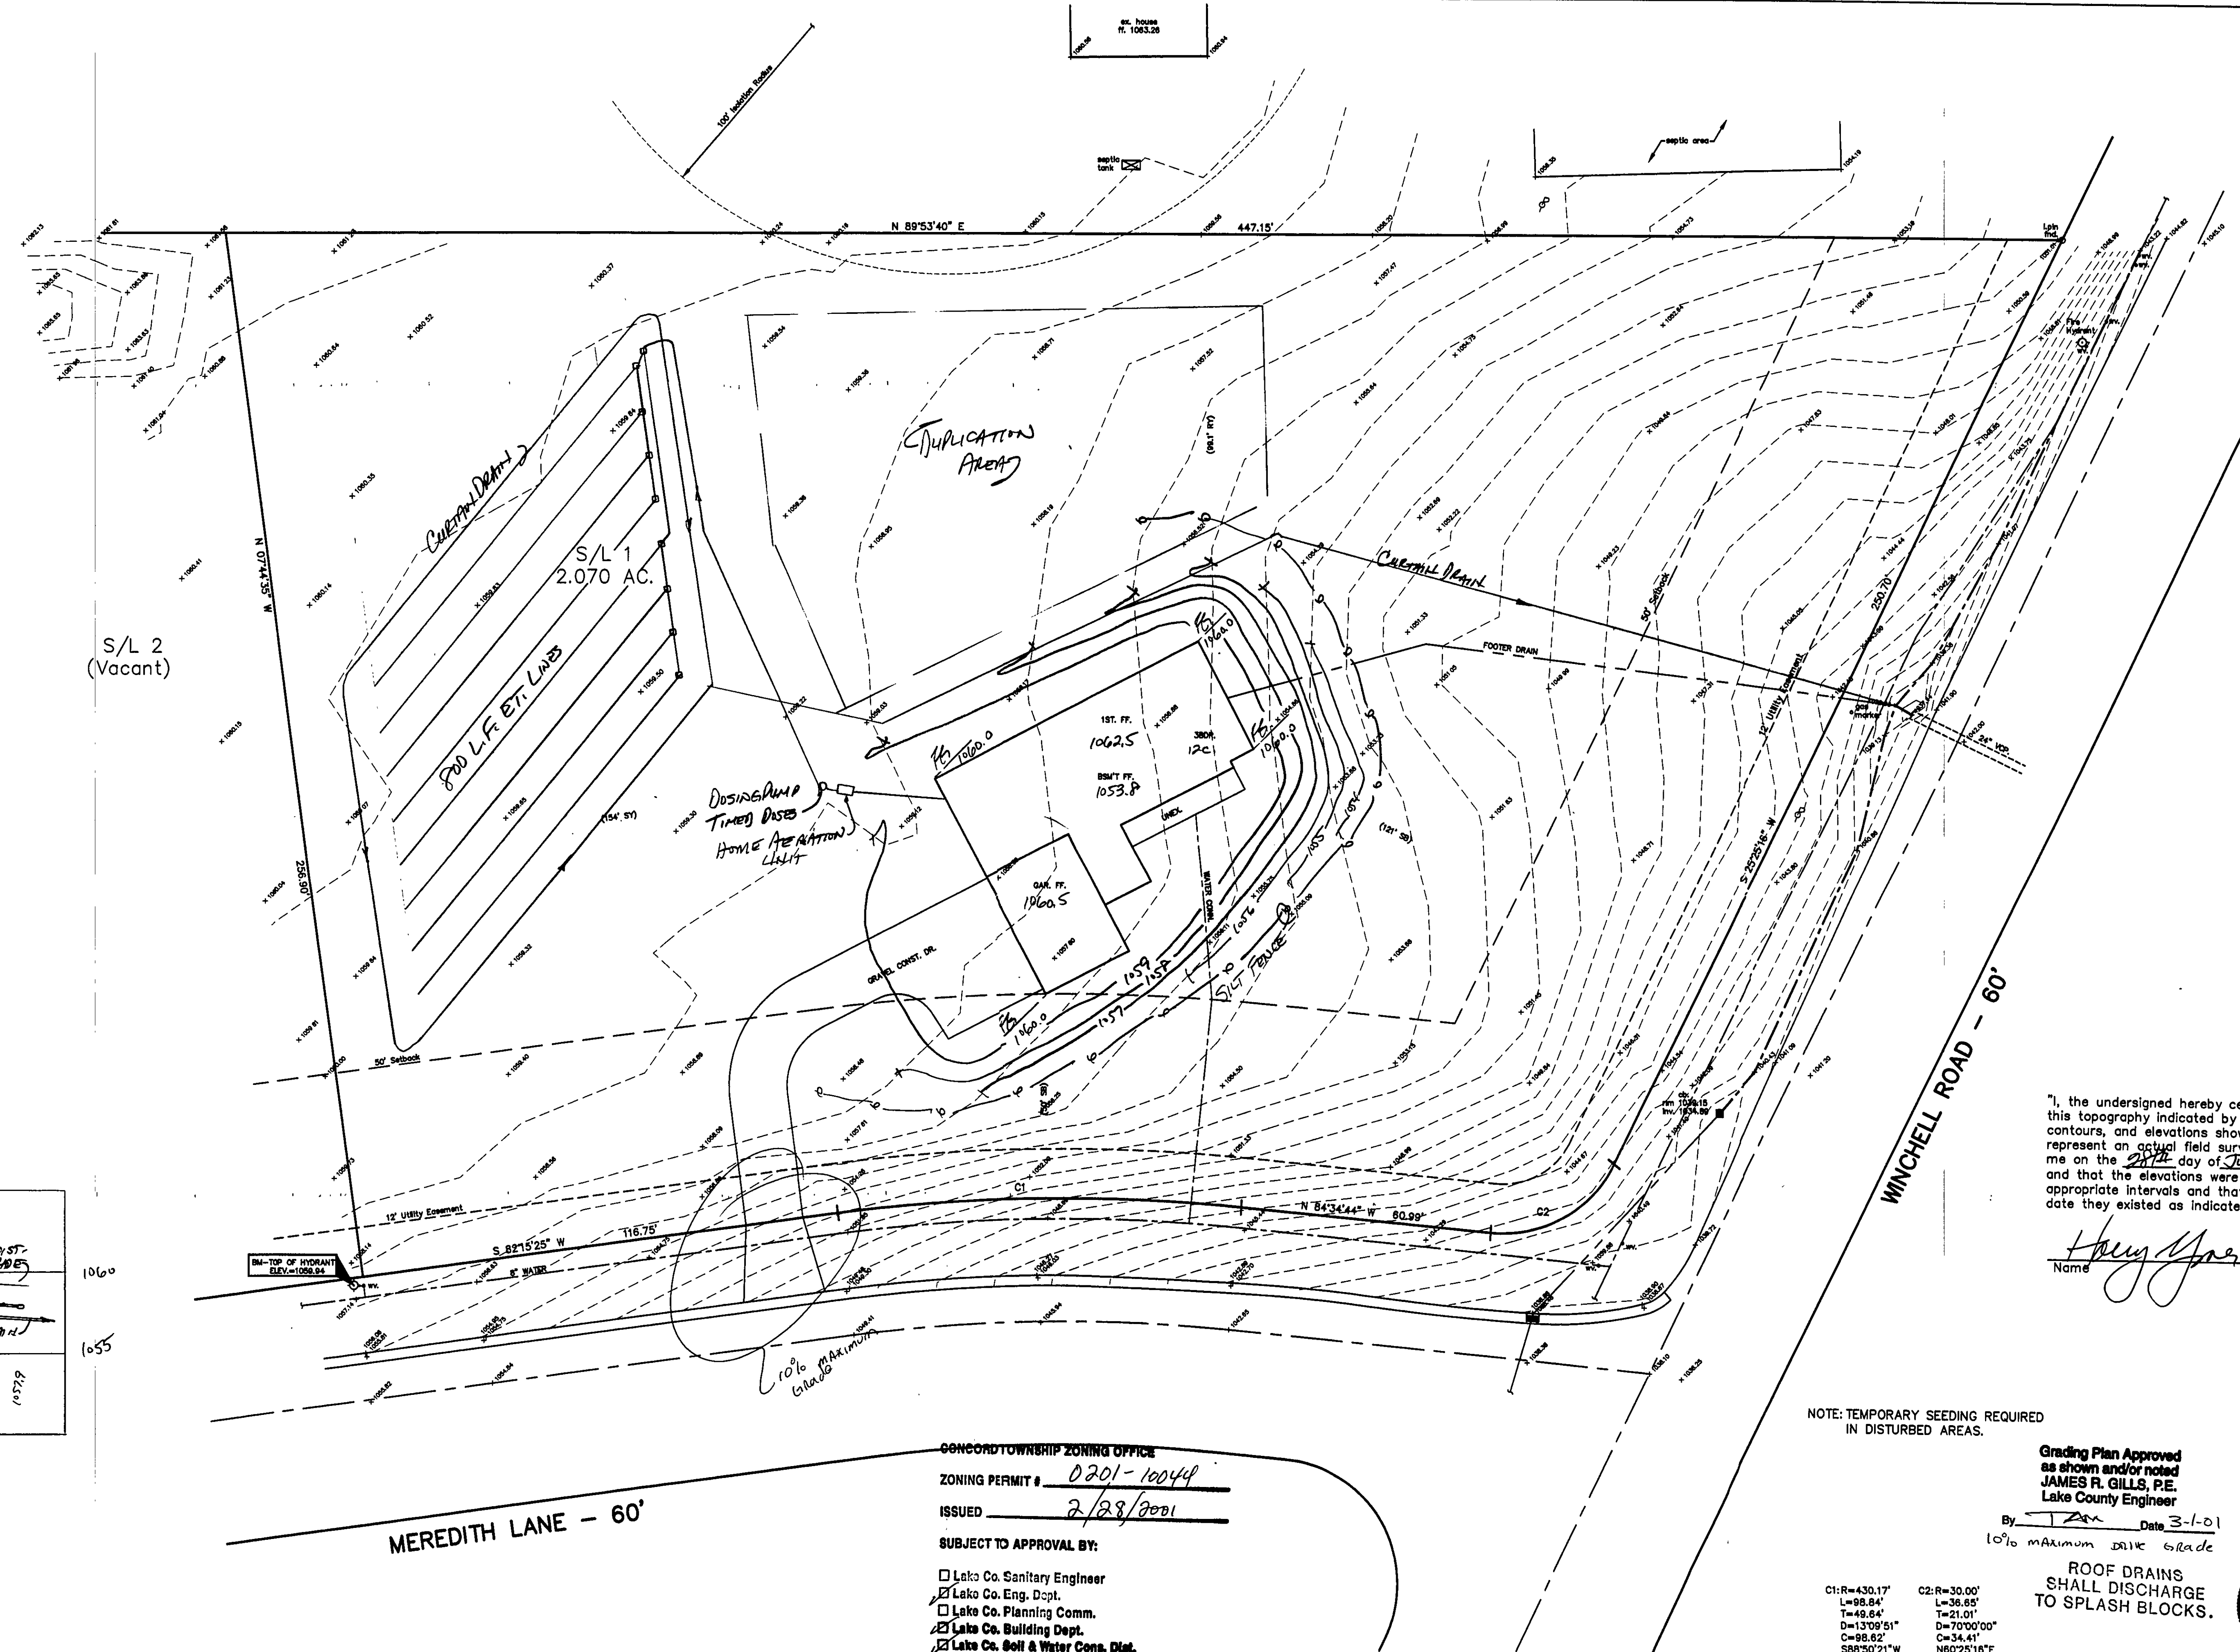

"I, the undersigned hereby certify that this topography indicated by 6", 1", or 2" contours, and elevations shown hereon represent an actual field survey made by me on the 28th day of July 2000 and that the elevations were taken at appropriate intervals and that as of that date they existed as indicated hereon."

Name [Signature] Reg. No. #6343


NOTE: TEMPORARY SEEDING REQUIRED IN DISTURBED AREAS.

Grading Plan Approved
as shown and/or noted
JAMES R. GILLS, P.E.
Lake County Engineer
By [Signature] Date 3-1-01
10% Maximum Drive Grade

ROOF DRAINS
SHALL DISCHARGE
TO SPLASH BLOCKS.

C1: R=430.17'
L=98.84'
T=49.84'
D=13'09"51"
C=98.62'
S88°50'21"W

C2: R=30.00'
L=36.65'
T=21.01'
D=70'00"00"
C=34.41'
N60°25'16"E

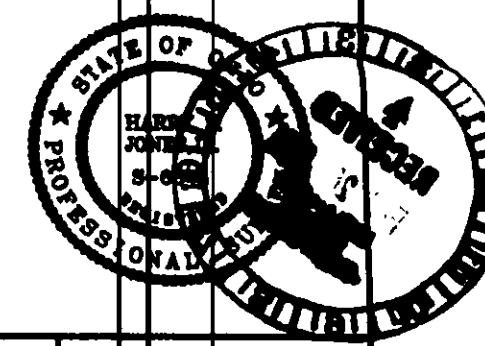

REV. NO.	DESCRIPTION	DATE	BY	CHK'D
1	REVISED PER L.C. HEALTH DEPT.	10/3/00	H.J.	H.J.
2	REVISED HOUSE	2/21/01	H.J.	H.J.

CONCORD TOWNSHIP ZONING OFFICE
ZONING PERMIT # 0201-10044
ISSUED 2/28/2001
SUBJECT TO APPROVAL BY:
☐ Lake Co. Sanitary Engineer
☒ Lake Co. Eng. Dept.
☐ Lake Co. Planning Comm.
☒ Lake Co. Building Dept.
☒ Lake Co. Soil & Water Cons. Dist.

bj BABCOCK, JONES AND ASSOCIATES, INC
CIVIL ENGINEERS - SURVEYORS - LAND PLANNERS
PAINESVILLE OHIO 44077

DATE 7/31/00
DESIGN BY H.J.
DRAWN BY T.R.
APPROVED BY H.J.

SITE PLAN
FOR
SHAMROCK CONSTRUCTION
S/L 1 STANFORD SPRINGS SUB.
CONCORD TOWNSHIP LAKE COUNTY

SCALE: 1" = 20'
JOB NO. 98-185-01
SHEET 1 OF 1