

Colorado Tax 578, LAKE COUNTY, OHIO

for: ALISTAIR HADJE
CLIENT OWNER

ADDRESS	STREET	CITY	ZIP
1735V LANE S.W.			
APPROXIMATE	NAME	LOT	TRACT
10-37			
10-37		VOLUME	PAGE
1735V LANE S.W.			
SUBJ. LOT NO.	STREET	PERM. PARCEL NO.	STREET
10			

LEGEND

SANITARY MANHOLE	—●—	WATER VALVE (GAS)	—+—
STORM MANHOLE	—■—	WATER METER (GAS)	—
INLET OR CATCH BASIN	—●—	AS BUILT ELEVATION:	
HYDRANT	—◇—		
EXISTING CONTOURS	—	INDICATES	
PROPOSED CONTOURS	—	DIRECTION OF	
EXIST. ELEV.	100.0	SURFACE DRAINAGE	
	100.0		
	PROP. ELEV.		

REMARKS

ALL BOUNDARY DATA SHOWN WAS OBTAINED FROM (DEEDS, RECORDED
SUBDIVISION PLAT OR OTHER PUBLIC RECORDS)

LOCATIONS AS SHOWN OF ADJACENT WELLS AND SEPTIC TANKS OBTAINED FROM
LAKE COUNTY HEALTH DEPARTMENT

DESIGN CERTIFICATION

THIS PLAT WAS PREPARED BY ME, AND IS CORRECT TO THE BEST OF MY KNOWLEDGE AND BELIEF.

NAME	SURVEYOR	REGISTRATION	NO.

CHECK LIST

NO. OF SEEDS/COATS
CHIMNEYS
BLANKING
TIE TO NEAREST STREET
SUBLOT NO. PARCEL NO.
RUMORINGD OWNERS
BLDG. DIMENSIONS FIN. OR
RECD. THIS P.L.R. GRADERS
APPROX TYPE WIDTH THICKNESS
REINFORCE TYPE WIDTH THICKNESS
CULVERT TYPE DIA. LENGTH
ROCK OUTCROPPINGS

WATER MAIN SIZE, LOCATION
SAN. SEWER SIZE & OR, LOC.
SAN. MAN. CANT. ELEV. INV. ELEV.
STW. CDM. SIZE, LOC. DEPTH
STORM SEWER SIZE & OR, LOC.
STORM MAN. CANT. ELEV.
FLOOR TIE SPACED CHASE
GAS LINE LOC. SIZE PRESSURE
SEWTO TANK LOCATION & DUFF. LOCATION &
WELL LOCATION
ISOLATION RADIUS FROM WELL

REVISIONS			PLAN PREPARED BY:	
NO.	DATE	BY		
1			BABCOCK • JONES & ASSOCIATES, INC. PAINESVILLE, OHIO	
2				
3				
4				
5			DRAWN BY <i>HT</i> SCALE 1" = 5'-0" CHK'D. <i>HT</i> DATE 5/22/87 CREW CHIEF <i>HT</i> APP'D. <i>HT</i>	PHONE NO. 357-1811 DRAWING NO. 88-068-10

"AS BUILT" CERTIFICATION

I, HEREBY CERTIFY THAT THE CIRCLED GRADES ARE EXISTING
FINISH GRADES CHECKED IN THE FIELD ON _____, 19____
AND ARE CORRECT TO THE BEST OF MY KNOWLEDGE AND BELIEF.

REGISTERED SURVEYOR

REG. NO.

#5812
ZONING PERMIT
6-8-88
ISSUED



THE

[illegible]

5555

THE COUNTY OF DEER

Ten. J. Marand

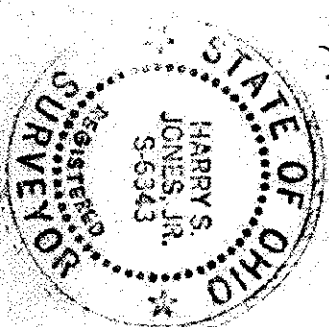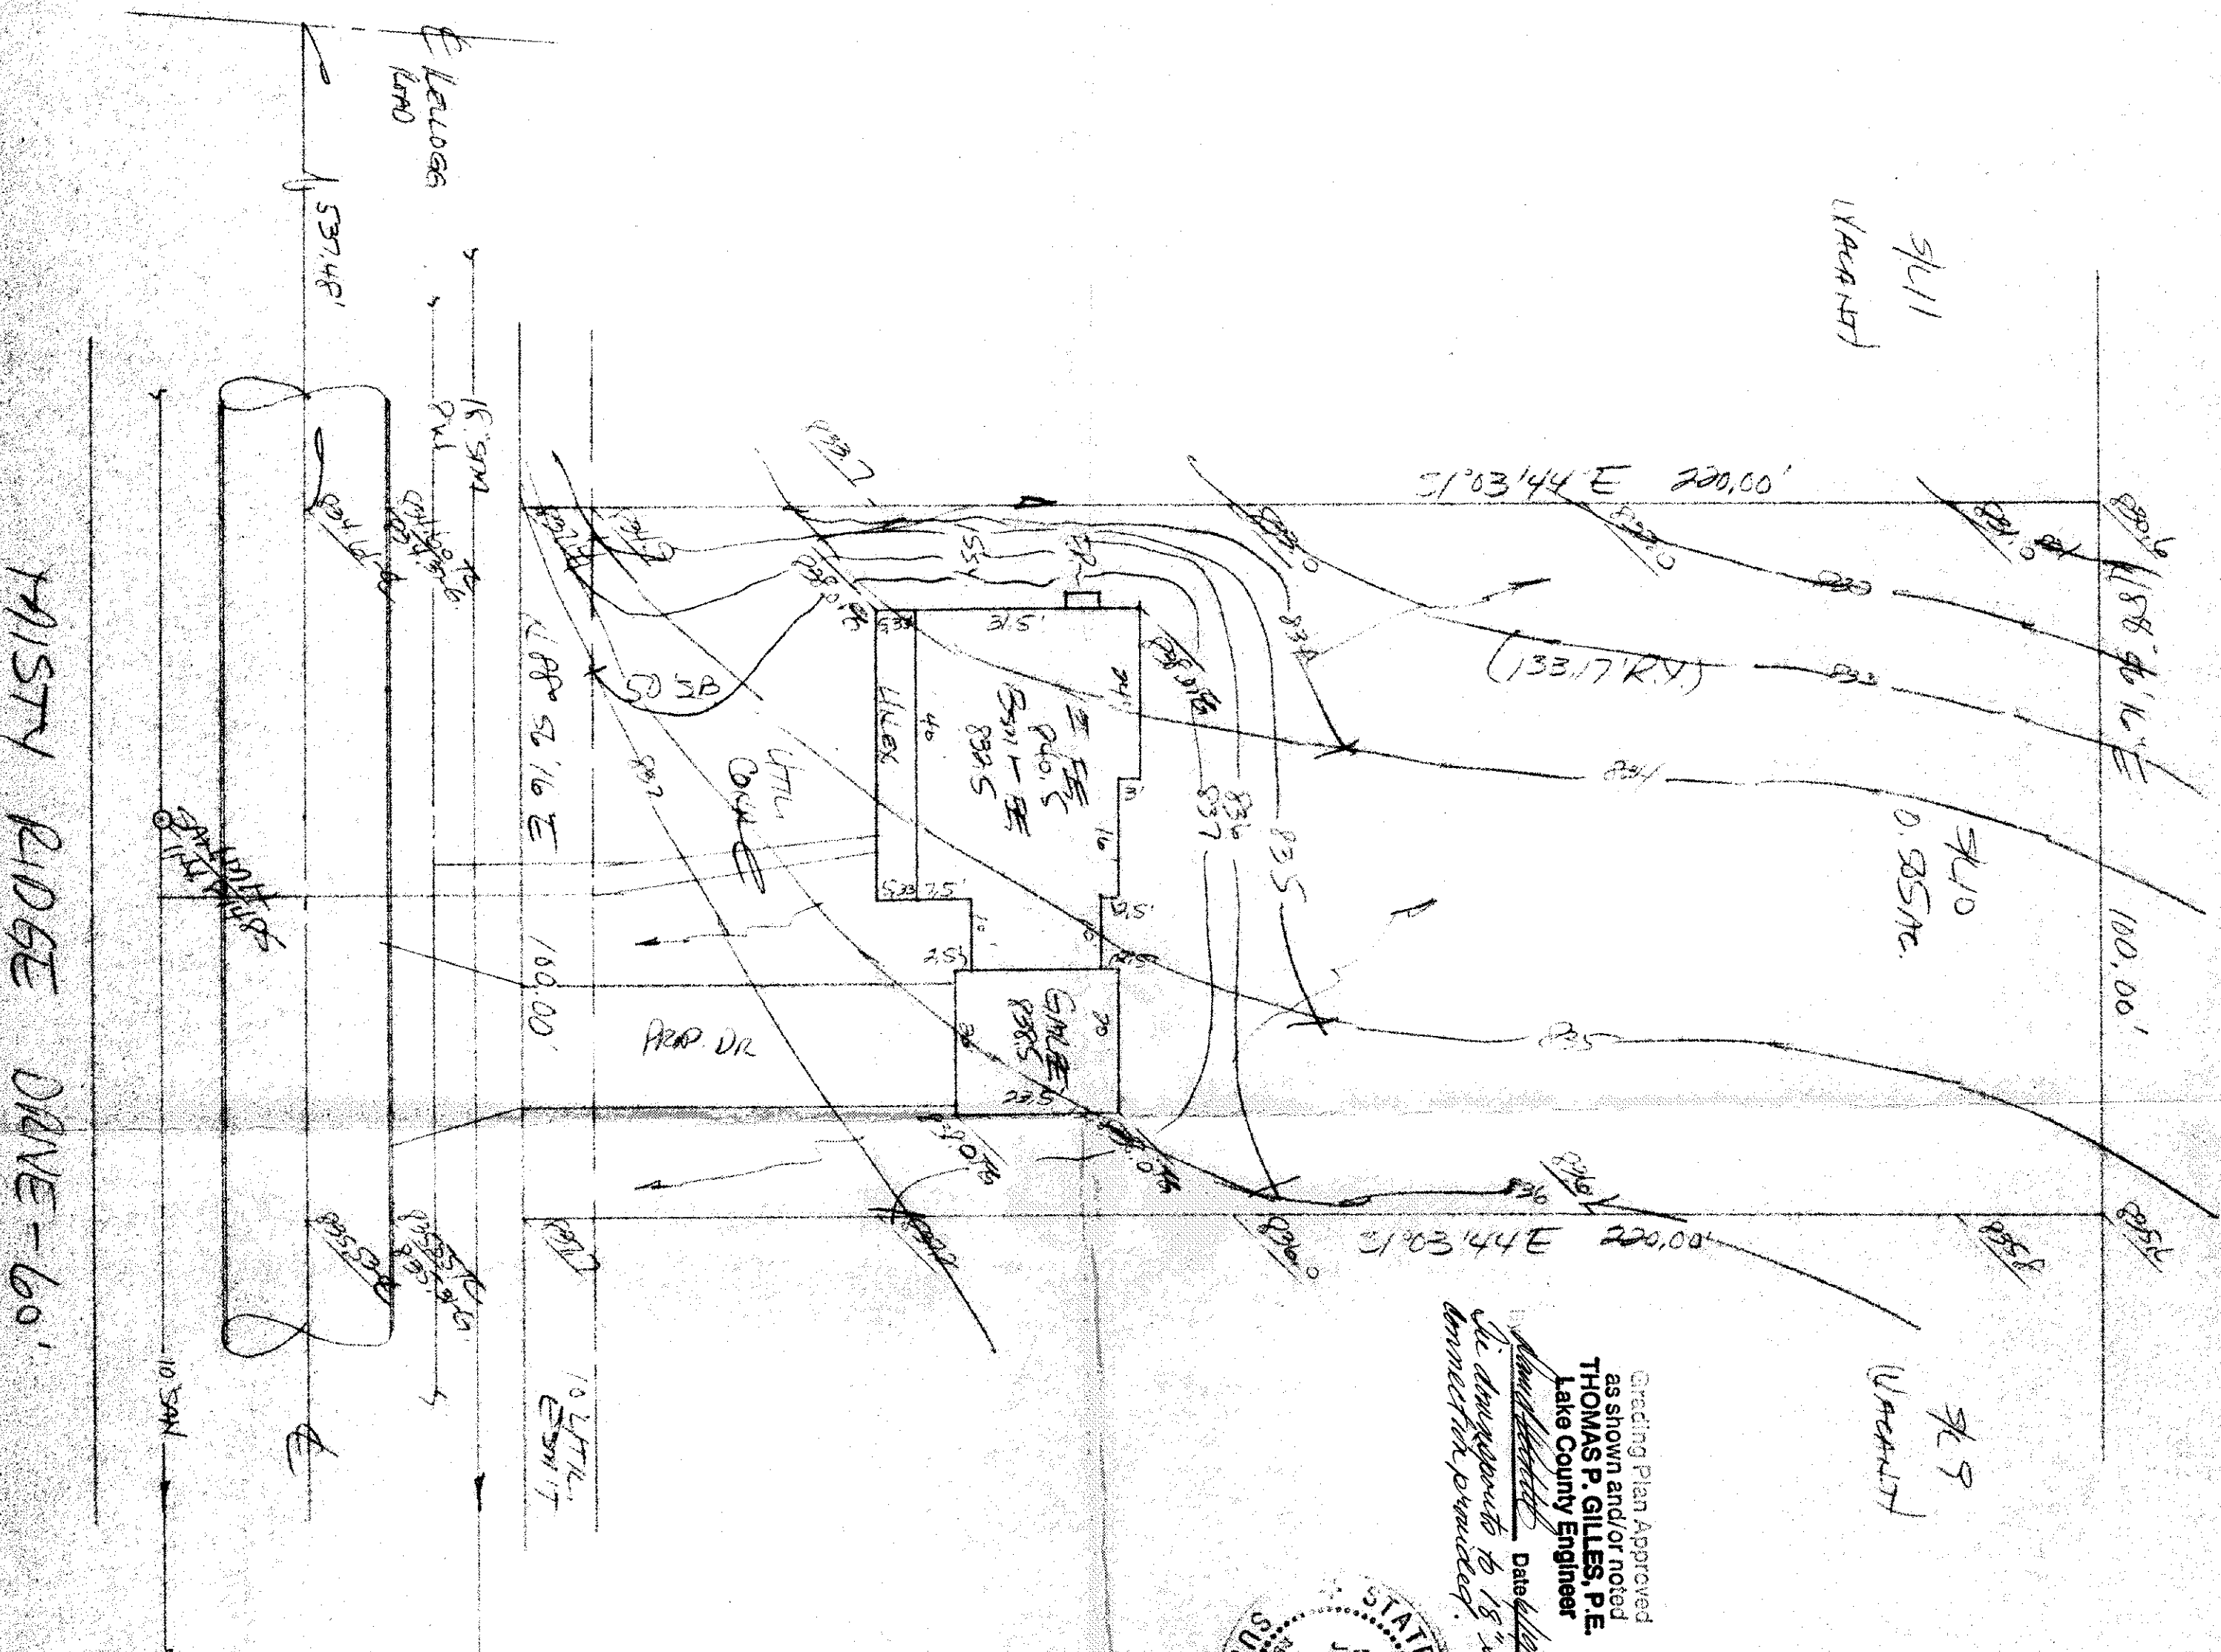

Grading Plan Approved
as shown and/or noted
THOMAS P. GILLES, P.E.
Lake County Engineer
Thomas P. Gilles Date *4/10/12*
*See amendments to 15' storm
sewer in plan provided.*