

SITE PLAN

Located Town Ship, LAKE COUNTY, OHIO

for: WHITE HIPS

CLIENT

OWNER

ADDRESS STREET CITY ZIP

LOT

TRACT

VOLUME

PAGE

SUBLOT NO.

STREET

LEGEND

- SANITARY MANHOLE
- STORM MANHOLE
- INLET OR CATCH BASIN
- HYDRANT
- EXISTING CONTOURS
- PROPOSED CONTOURS
- EXIST. ELEV.
- PROP. ELEV.
- WATER VALVE (GAS)
- WATER METER (GAS)
- AS BUILT ELEVATION
- INDICATES DIRECTION OF SURFACE DRAINAGE

REMARKS

ALL BOUNDARY DATA SHOWN WAS OBTAINED FROM IDEERS, RECORDED SUBDIVISION PLAT OR OTHER PUBLIC RECORDS

LOCATIONS AS SHOWN OF ADJACENT WELLS AND SEPTIC TANKS OBTAINED FROM LAKE COUNTY HEALTH DEPARTMENT

DESIGN CERTIFICATION

THIS PLAT WAS PREPARED BY ME, AND IS CORRECT TO THE BEST OF MY KNOWLEDGE AND BELIEF.

NAME SURVEYOR REGISTRATION NO.

CHECK LIST

- NO. OF BEDROOMS
- DIMENSIONS
- BEARINGS
- TIE TO NEAREST STREET
- SUBLOT NO. PARCEL NO.
- SURROUNDING OWNERS
- BLDG. DIMENSIONS FIN. GR.
- BLDG. TYPE
- SEPTIC TANK LOCATION & DUPPLICATION AREA
- WELL LOCATION
- ISOLATION RADIUS FROM WELL
- WATER MAIN SIZE, LOCATION
- SEWER SIZE % GR. LOC.
- SEAN. MH. CAST. ELEV. INV. ELEV.
- SEAN. CONN. SIZE LOC. DEPTH
- STORM SEWER SIZE % GR. LOC.
- STORM MH. CAST. ELEV. INV. ELEV.
- PAV'T TYPE, DRAINAGE
- GAS LINE LOC. SIZE PRESSURE
- SEPTIC TANK LOCATION & DUPPLICATION AREA
- WELL LOCATION
- ISOLATION RADIUS FROM WELL

PLAN PREPARED BY:

BABCOCK • JONES & ASSOCIATES, INC.

PAINESVILLE, OHIO

NO.	DATE	BY
1		
2		
3		
4		
5		

"AS BUILT" CERTIFICATION

I, HEREBY CERTIFY THAT THE CIRCLED GRADES ARE EXISTING FINISH GRADES CHECKED IN THE FIELD ON 19

AND ARE CORRECT TO THE BEST OF MY KNOWLEDGE AND BELIEF.

REGISTERED SURVEYOR REG. NO.

TDN - Lim Sol M/H

ELEV. = 832.45

*5965

ISSUED 9-13-88

SUBJECT TO APPROVAL BY:

Lake County Surveyor Eng.



Lake County Eng. Dept.

Lake County Planning Comm.

Lake County Bldg. Dept.

Town of Maumee

MASTY RIDGE DR - 60

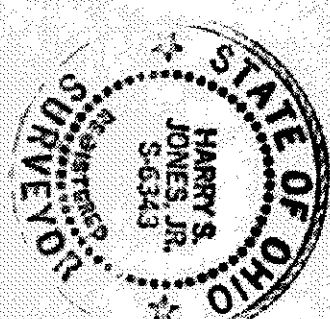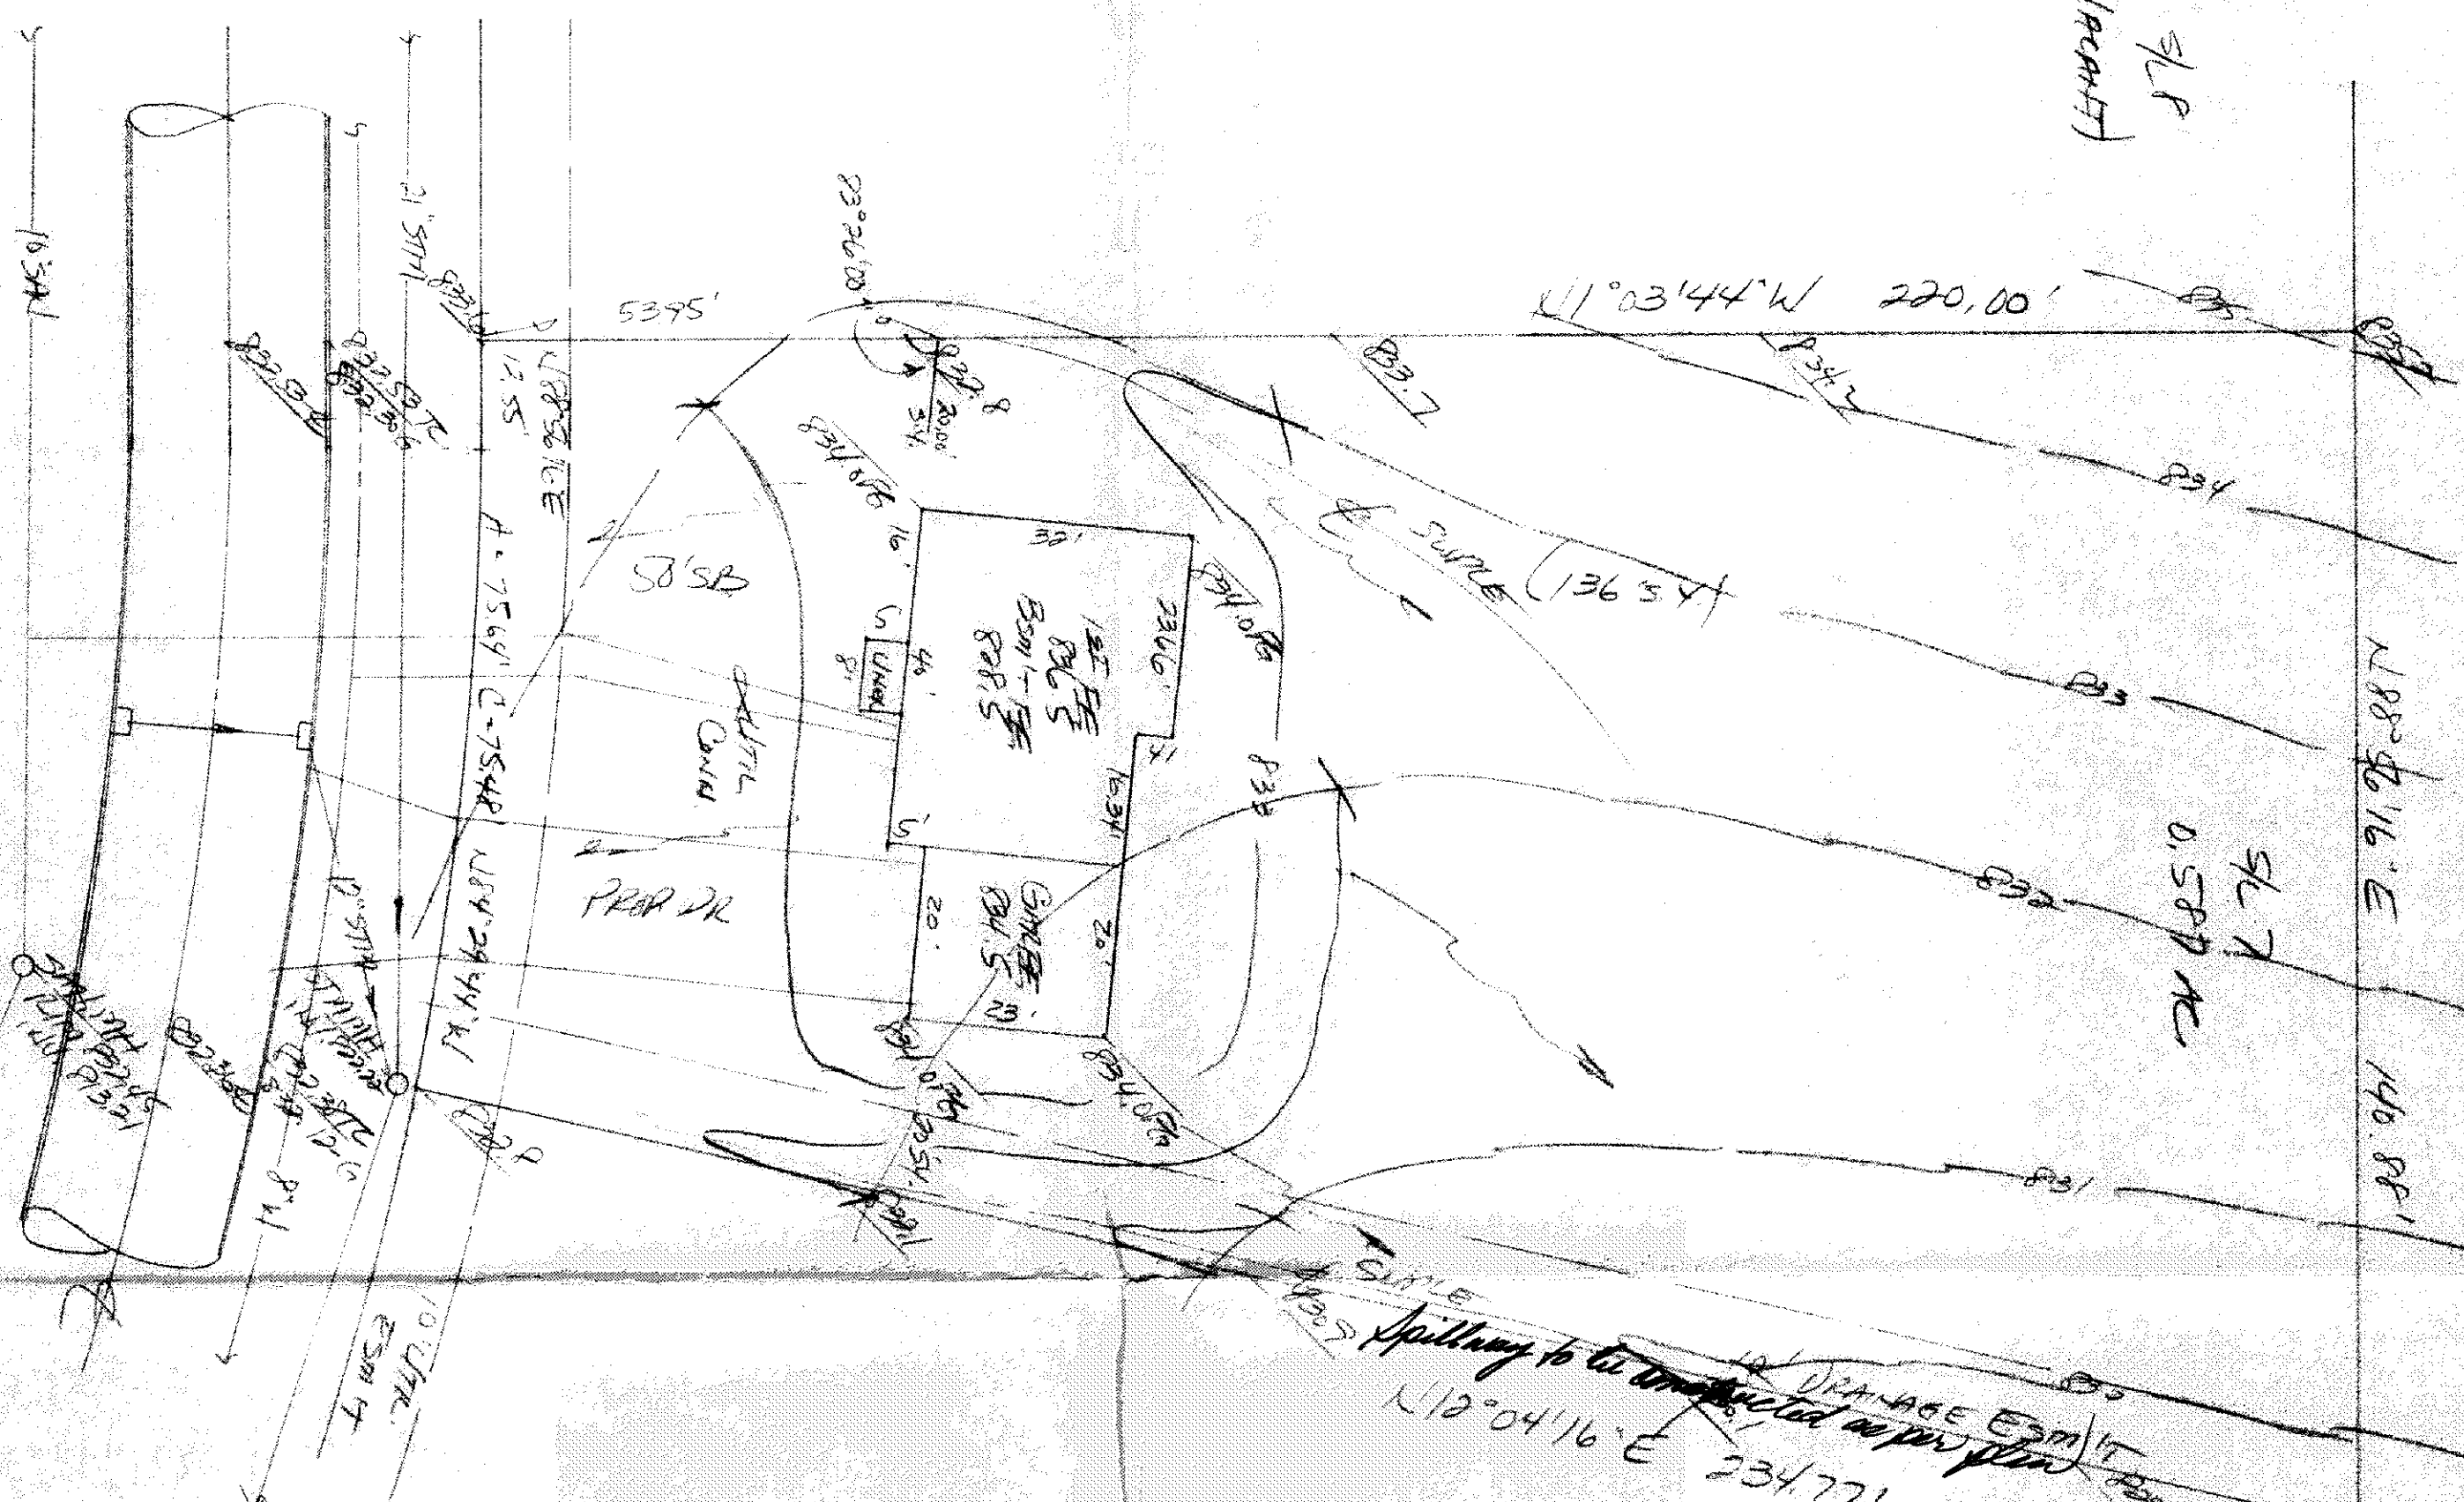

Grading Plan Approved as shown and/or noted THOMAS P. GILLES, P.E. Lake County Engineer