


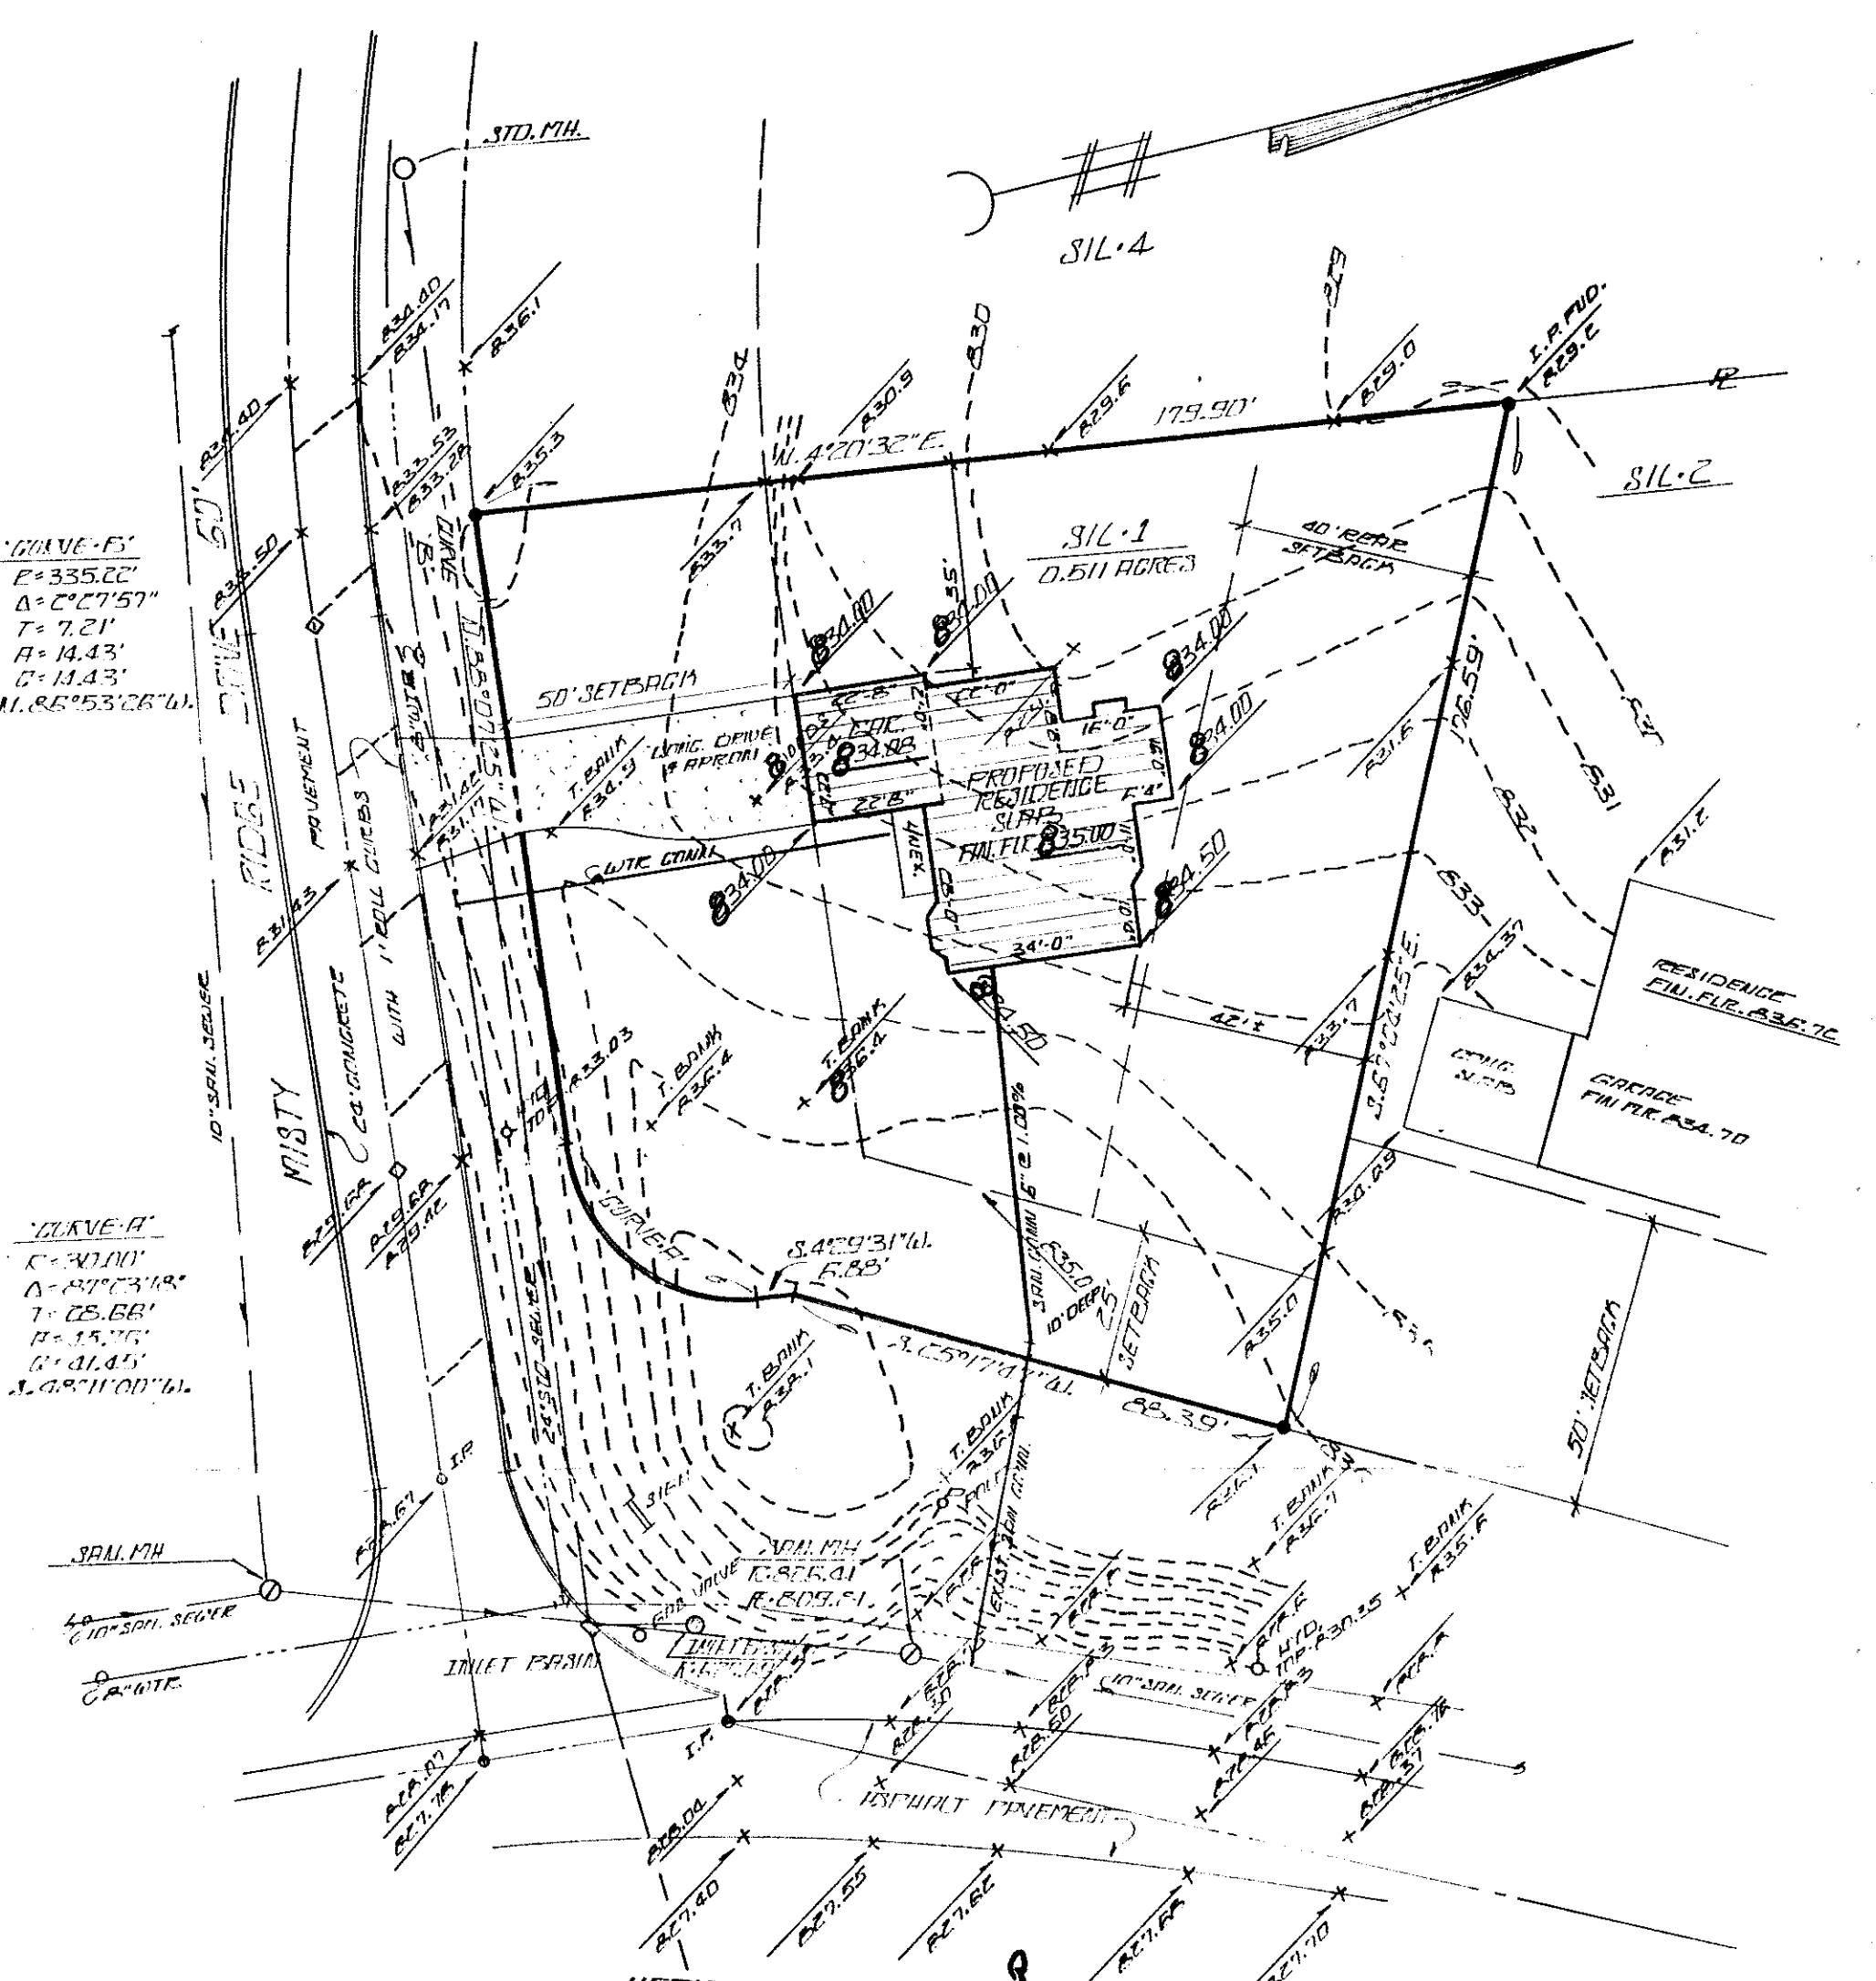

"CURVE-B"
 E=335.22'
 Δ=6°27'57"
 T=7.21'
 R=14.43'
 C=14.43'
 M.85°53'26"W.

"CURVE-A"
 R=30.00'
 Δ=87°3'18"
 T=28.68'
 R=15.76'
 C=11.45'
 S.48°11'00"W.

NOTES
 D.S. = DOWNSPOUTS OUTLETED ON SPLASHELOGS
 CONCRETE DRIVE & APRON TO BE 6" THICK
 ——— OVERLAND DRAINAGE
 836.3 EXISTING GROUND ELEVATIONS
 835.00 PROPOSED FINISHED GROUND ELEVATIONS
CONTRACTOR TO VERIFY
 1. FIN. F.L. ELEV'S & H.S.E. SIZE
 2. LOC. & ELEV'S OF EXISTING UTILITY CONNS.
"BEFORE STARTING CONSTRUCTION"
BENCHMARK:
 FIRST FIRE HYD. MISTY RIDGE DRIVE: ELEV. 833.03

#6625
 ZONING PERMIT
 ISSUED 10-4-90
 SUBJECT TO APPROVAL BY:
 Lake County Sanitary Eng. ☐
 Lake County Eng. Dept. ☒
 Lake County Planning Comm. ☒
 Lake County Bldg. Dept. ☒
Peter S. Marano

SITE PLAN for SIGNATURE HOMES
 BEING SUBLT #1 IN THE MISTY RIDGE SUBDIVISION
 RECORDED - VOL. 10 PG. 37
 CONCORD TOWNSHIP-LAKE COUNTY-OHIO
 SCALE: 1"=30' SEPTEMBER 29-1990
 REV. PER T. REDLIN: 10-3-90

PLAN PREPARED BY:
LAKE INC.
 ENGINEERS & SURVEYORS
 30601 ENGLIS AVENUE
 WILLOUGHBY OHIO 44092
William D. Landeg 10/1/90
 WILLIAM D. LANDEG #4594 DATE

Grading Plan Approved
 as shown and/or noted
 THOMAS P. GILLES, P.E.
 Lake County Engineer
 By GJH Date 10/10/90

